## MECHANICAL/PLUMBING SPECIFICATIONS

#### <u>PART ONE - GENERAL</u>

- 1. THE CONTRACTOR SHALL PROVIDE THE WORK SHOWN ON THE DRAWINGS AND SPECIFIED FOR THEIR INDIVIDUAL SECTIONS OF WORK. THE WORD "WORK" SHALL MEAN ALL LABOR, TRANSPORTATION, MATERIAL, EQUIPMENT, TOOLS, INSTALLATION, SUPERVISION AND ANY OTHER INCIDENTAL ITEMS OR SERVICES NECESSARY FOR THE PROPER INSTALLATION AND OPERATION OF THE COMPLETE SYSTEMS, WHICH SHALL BE PROVIDED WHETHER OR NOT SPECIFICALLY INDICATED OR NOTED.
- 2. ALL GENERAL CONDITIONS, SPECIAL REQUIREMENTS OR GENERAL REQUIREMENTS OF THE CONSTRUCTION SPECIFICATIONS ARE MADE PART OF THIS SPECIFICATION AND HAVE THE SAME FORCE AND AFFECT AS IF COMPLETELY REPRODUCED.
- 3. THE WORD "PROVIDE" SHALL MEAN FURNISH AND INSTALL, MAKE ALL FINAL CONNECTIONS AND LEAVE IN AN APPROVED COMPLETE OPERATING CONDITION. 4. ALL WORK SHALL BE DONE IN ACCORDANCE WITH THE LATEST ADOPTED EDITIONS OF THE APPLICABLE INTERNATIONAL BUILDING CODE (IBC), UNIFORM MECHANICAL CODE (UMC), UNIFORM PLUMBING CODE (UPC), NATIONAL ELECTRIC CODES (NEC) AND ALL OTHER APPLICABLE FEDERAL, STATE, AND LOCAL REGULATIONS.
- 5. THE CONTRACTOR SHALL BE RESPONSIBLE FOR PAYING ALL FEES AND OBTAINING ALL PERMITS AND INSPECTIONS REQUIRED FOR THE WORK.
- 6. THE CONTRACTOR SHALL CAREFULLY EXAMINE ALL CONTRACT DOCUMENTS. THE CONTRACTOR SHALL COORDINATE THE WORK WITH ALL OTHER TRADES INCLUDING. BUT NOT LIMITED TO, THE CONTRACT DOCUMENTS, SHOP DRAWINGS, ETC. FOR ALL GENERAL CONSTRUCTION, STRUCTURAL, MECHANICAL, ELECTRICAL AND SPECIALTY CONTRACTOR WORK. THE CONTRACTOR SHALL BE RESPONSIBLE FOR THE PROPER FITTING OF MATERIAL INTO THE BUILDING AS PLANNED, WITHOUT INTERFERENCE WITH OTHER WORK, AND SHALL MAKE REASONABLE MODIFICATIONS IN THE LAYOUTS NEEDED TO PREVENT CONFLICT WITH OTHER TRADES, TO PROVIDE ACCESS AND FOR THE PROPER EXECUTION OF THE WORK.
- 1. DRAWINGS ARE DIAGRAMMATIC AND SCHEMATIC IN NATURE, AND INDICATE THE TYPE SIZE, ARRANGEMENT AND LOCATION OF MATERIALS AND EQUIPMENT. WORK INCLUDES CERTAIN COMPONENTS, APPURTENANCES AND RELATED SPECIALTIES THAT MAY NOT BE SHOWN. CONTRACTOR SHALL PROVIDE ALL NECESSARY ITEMS TO COMPLETE THE WORK ACCORDING TO INDUSTRY STANDARDS. IT IS THE INTENT OF THE DRAWINGS AND SPECIFICATIONS TO CALL OUT FOR FINISHED WORK, TESTED AND READY FOR OPERATION. DO NOT SCALE DRAWINGS. ARRANGEMENT OF EQUIPMENT AND ROUTING OF PIPES AND DUCTWORK, ETC. INDICATED ON DRAWINGS SHALL BE ROLLTED PLUMB AND AT RIGHT ANGLES TO BUILDING CONSTRUCTION AND MAY REQUIRE MODIFICATION DUE TO UNFORESEEN CONDITIONS AND REQUIRE ON SITE REVISIONS DURING CONSTRUCTION. (SEE ALSO "BIDDING").
- 8. ALL WORK REQUIRED FOR IDENTICAL ITEMS SHOWN ON THE DRAWINGS SHALL BE PROVIDED, ALTHOUGH EACH SPECIFIC IDENTICAL ITEM MAY NOT BE SHOWN IN
- 9. THE CONTRACTOR SHALL SUBMIT FIVE SETS OF SHOP DRAWINGS AND TECHNICAL DATA SHEETS FOR ALL EQUIPMENT AND MATERIALS SPECIFIED HEREIN TO THE ENGINEER. THE ENGINEER SHALL REVIEW SHOP DRAWINGS AND TECHNICAL DATA SHEETS FOR CONFORMANCE WITH THE CONTRACT DOCUMENTS AND ISSUE A WRITTEN ASSESSMENT TO THE OWNER PRIOR TO COMMENCEMENT OF WORK. THE CONTRACTOR SHALL BE RESPONSIBLE FOR ALL ENGINEERING FEES NECESSARY TO CHANGE PERMIT DOCUMENTS BASED ON ALTERNATE SUBMITTAL PACKAGES/EQUIPMENT SUBSTITUTIONS.
- 10. ALL SUBSTITUTIONS SHALL BE SUBMITTED TO THE ENGINEER FOR CONSIDERATION PRIOR TO BIDDING. THE OWNER'S REPRESENTATIVE SHALL PREAPPROVE ANY PROPOSED SUBSTITUTION IN WRITING. THE CONTRACTOR SHALL BE RESPONSIBLE FOR COORDINATING ALL REQUIREMENTS ASSOCIATED WITH SUBSTITUTED EQUIPMENT OR MATERIALS WITH OTHER BUILDING TRADES, INCLUDING ALL ELECTRICAL STRUCTURAL, OR ARCHITECTURAL ELEMENTS. THE CONTRACTOR SHALL IDENTIFY AND ANNOTATE ALL REVISED REQUIREMENTS PER BUILDING TRADE ON THE SHOP DRAWINGS. THE CONTRACTOR SHALL ALSO IDENTIFY ALL COST DEBITS OR CREDITS IN WRITING FOR THE PROPOSED CHANGES PER BUILDING TRADE.
- 1. UPON COMPLETION OF CONSTRUCTION, THE CONTRACTOR SHALL SUPPLY THE ENGINEER WITH FIVE (5) COMPLETE SETS OF AS-BUILT DOCUMENTS ACCURATELY SHOWING THE MATERIALS AND EQUIPMENT AS INSTALLED.
- 2. ALL MATERIALS AND WORKMANSHIP SHALL BE GUARANTEED FOR A MINIMUM OF ONE (1) YEAR FROM DATE OF ACCEPTANCE BY OWNER. REFRIGERATION COMPRESSORS SHALL BE GUARANTEED FOR A MINIMUM OF FIVE (5) YEARS FROM DATE OF OWNER'S ACCEPTANCE. IN ADDITION, THE CONTRACTOR SHALL GUARANTEE THAT THE INSTALLATION WHEN OPERATED IN ACCORDANCE WITH THE CONTRACTOR'S INSTRUCTIONS WILL DEVELOP CAPACITY AND CHARACTERISTICS AS SPECIFIED AND WILL FULFILL EACH AND EVERY REQUIREMENT OF THE DRAWINGS AND SPECIFICATIONS, SHOULD THE INSTALLATION IN ANY WAY FAIL TO DO SO, THE CONTRACTOR WILL, WITHOUT DELAY OR WITHOUT COST TO THE OWNER, PROVIDE WHATEVER ADDITIONAL EQUIPMENT, MATERIAL, AND LABOR REQUIRED TO CORRECT THE DEFICIENCY AND COMPLY WITH THE REQUIREMENTS OF THE DRAWINGS AND SPECIFICATIONS.
- 13. CONTRACTOR SHALL CHECK AND VERIFY ALL SIZES, DIMENSIONS, AND CONDITIONS BEFORE STARTING ANY WORK. ANY DEVIATIONS OR PROBLEMS SHALL BE TRANSMITTED TO THE ENGINEER FOR REVIEW.
- 14. PROVIDE BASE AND COUNTER FLASHING FOR ITEMS PENETRATING THE ROOF OR EXTERIOR WALLS.
- 15. STARTERS AND CONTROLS FOR MOTORS, ETC. TO BE FURNISHED BY MECHANICAL CONTRACTOR. ELECTRICAL CONTRACTOR TO INSTALL THE AFOREMENTIONED ITEMS, PART THREE - EXECUTION AND FURNISH ALL POWER WIRING. ALL CONTROL AND INTERLOCKING WIRING SHALL BE FURNISHED AND INSTALLED BY MECHANICAL CONTRACTOR.
- 16. ALL WORK SHOWN IS NEW UNLESS NOTED OTHERWISE.

- . THE CONTRACTOR SHALL VISIT THE SITE PRIOR TO SUBMITTING A BID TO BECOME FAMILIAR WITH THE EXISTING CONDITIONS. THE CONTRACTOR SHALL COMPARE THE WORK SPECIFIED IN THE CONTRACT DOCUMENTS WITH THE EXISTING CONDITIONS. THE CONTRACTOR SHALL IDENTIFY AND NOTATE ALL WORK OR CONDITIONS THAT ARE DIFFERENT FROM THE CONTRACT DOCUMENTS OR THEIR INTENT. THE CONTRACTOR SHALL, UPON DISCOVERY, IMMEDIATELY NOTIFY AND REPORT, IN WRITING, ANY DISCREPANCIES TO THE ENGINEER. NO EXTRAS OR CHANGE ORDERS WILL BE ALLOWED FOR FAILURE TO PERFORM THE PRE-BID SITE VISIT.
- 2. BASE PROPOSAL ON MANUFACTURER NAMES LISTED UNLESS "OR EQUAL" IS INDICATED. PROVIDE SUBSTITUTION REQUESTS A MINIMUM OF FIVE (5) BUSINESS DAYS PRIOR TO BID DATE CLOSING TO ALLOW TIME FOR DUE CONSIDERATION OF PROPOSED ALTERNATE. DETERMINATION OF SUBSTITUTION OF EQUALITY RESTS SOLELY WITH THE ENGINEER.

### PART TWO - PRODUCTS HYAC EQUIPMENT

PROVIDE HYAC EQUIPMENT AS SPECIFIED AND/OR SCHEDULED HEREIN AND IN ACCORDANCE WITH MANUFACTURER'S PUBLISHED INSTALLATION INSTRUCTIONS. EQUIPMENT SHALL OPERATE ACCORDING TO THE MANUFACTURER'S "OWNER'S OPERATING AND MAINTENANCE MANUAL" TROUBLE-FREE PRIOR TO STARTING TEST AND BALANCE (TAB) WORK.

# <u>DUCTWORK</u>

- 1. DUCTWORK SHALL BE ASTM A525 OR A527 GALYANIZED SHEET METAL LOCK-FORMING QUALITY HAVING ZINC COATING OF 1.25 OZ PER SQ. FT. FOR EACH SIDE PER ASTM A90 AND INSTALLED ACCORDING TO ASHRAE RECOMMENDATIONS, AND SMACNA DUCT CONSTRUCTION STANDARDS. DUCTWORK SYSTEMS SHALL BE (2" CLASSIFICATION SUPPLY, AND 1" CLASSIFICATION RETURN AND EXHAUST). 2. PROVIDE MANUAL VOLUME DAMPERS WITH LOCKING QUADRANTS AND IDENTIFYING RIBBONS AT DAMPER HANDLES FOR AIR BALANCING EACH BRANCH DUCT TAKE-OFF
- OR PIECE OF AIR DISTRIBUTION EQUIPMENT. 3. SEAL ALL DUCT PENETRATIONS THROUGH WALLS, FLOOR AND ROOF. SEAL ALL TRANSVERSE DUCT SEAMS WITH APPROVED MASTIC. DUCT TAPES SHALL NOT BE ALLOWED FOR RIGID DUCTWORK. SUPPLY AND RETURN DUCTWORK SHALL BE INSULATED WITH 1 1/2" THICK FLEXIBLE GLASS FIBER ANSI/ASTM C612: MAXIMUM 'K' VALUE OF 0.29 AT 15°F, WITH FOIL-KRAFT FLAME RESISTANT VAPOR BARRIER, 3/4
- \*/CUFT. DENSITY. 4. ALL DUCTWORK SIZES SHOWN ARE FREE AREA DIMENSIONS. EXHAUST DUCTWORK SHALL BE UNINSULATED. DUCTWORK INTERIOR BEHIND DEVICES SHALL BE PAINTED
- 5. FLEXIBLE DUCTWORK WHERE INDICATED ON THE DRAWINGS SHALL BE INSULATED, WITH PLASTIC VAPOR BARRIER AT INTERIOR AND EXTERIOR, STEEL WIRE COIL REINFORCED. JOINTS SHALL BE BAND-CLAMPED AND TAPE SEALED TO MAINTAIN INTEGRITY OF VAPOR BARRIER. FLEXIBLE INSTALLATION SHALL BE SUPPORTED TO ELIMINATE SAGS. FLEXIBLE GLASS FIBER INSULATION SHALL HAVE A MAXIMUM Ø23 K VALUE AT 75°F.

# MECHANICAL PRODUCTS

- . PIPE HANGERS: PIPE SIZES 1/2" TO 1 1/2": MALLEABLE IRON, CARBON STEEL ADJUSTABLE SWIVEL, SPLIT RING. PIPE SIZES 2" TO 4": CARBON STEEL, ADJUSTABLE, CLEVIS. PIPE SIZES 6" AND OVER: ADJUSTABLE STEEL YOKE, CAST IRON ROLL, DOUBLE HANGER.
- 2. YALVES: PROVIDE THE NAME OF MANUFACTURER AND GUARANTEED WORKING PRESSURE CAST OR STAMPED ON VALVE BODIES AND BE BY SINGLE MANUFACTURER FOR SIMILAR TYPE. ACCEPTABLE MANUFACTURERS: MILWAUKEE, STOCKHAM, NIBCO, APOLLO.
- 3. PIPING: HYDRONIC WATER PIPING (ABOVE GROUND) SCHEDULE 40 STEEL (ASTM A53), MALLEABLE IRON OR FORGED STEEL WELDED TYPE FITTINGS, SCREWED OR WELDED JOINTS; OR TYPE L HARD DRAWN COPPER TUBING (ASTM B88), CAST BRASS OR SOLDER WROUGHT COPPER FITTINGS, SOLDER GRADE 95TA JOINTS, PIPING OVER 2" SHALL BE STEEL WITH WELDED JOINTS. EQUIPMENT DRAIN OVERFLOWS SHALL BE TYPE M HARD DRAWN COPPER.
- 4. PIPE INSULATION: GLASS FIBER INSULATION WITH MAXIMUM K VALUE OF 27 AT 15 DEGREES F. MINIMUM THICKNESS SHALL BE I" FOR PIPING LESS THAN 2". AND 2" HOT WATER/ 1 1/2" CHILLED WATER FOR PIPING 2" AND GREATER. OUTDOOR INSULATION THICKNESS SHALL BE DOUBLE INDOOR THICKNESS WITH A MAXIMUM THICKNESS OF 3". INTERIOR APPLICATIONS SHALL HAVE KRAFT REINFORCED FOIL VAPOR BARRIER WITH ONE PIECE PREMOLDED PYC JACKETS FOR FITTINGS. EXTERIOR APPLICATIONS SHALL HAVE Ø.16 THICK ALUMINUM JACKETS. ACCEPTABLE MANUFACTURERS: OWENS CORNING, CERTAINTEED, JOHNS MANYILLE, KNAUF.
- 5. PACKAGED ELECTRIC/GAS ROOFTOP UNITS(HEAT PUMPS INCLUDED): UNIT SHALL BE

COMPLETE WITH HERMETICALLY SEALED COMPRESSOR WITH HIGH AND LOW PRESSURE CUT-OFFS, COILS, HEATING SECTION, AIR COOLED CONDENSER, CONDENSER BLOWER OR FAN, AUTOMATIC CONTROLS, CONTROL PANEL WITH STARTERS AND DISCONNECT SWITCH, RELAYS, ETC. FOR SINGLE POINT POWER CONNECTION. UNITS SHALL BE FURNISHED WITH 2 SETS OF 1" THROWAWAY PLEATED 30% FILTERS. UNITS SHALL BE COMPLETELY FACTORY WIRED FOR TERMINAL CONNECTIONS OF THERMOSTAT WITH A FAN-AUTO/MANUAL SWITCH AND A SYSTEM HEAT/OFF/COOL/AUTO SWITCH. UNITS TO BE INSTALLED AS PER MANUFACTURER RECOMMENDATIONS, WITH MANUAL OUTSIDE AIR DAMPER, 12" ROOF CURB, ITEMS AS SCHEDULED AND ALL NECESSARY ACCESSORIES REQUIRED FOR EFFICIENT AND PROPER OPERATION. ACCEPTABLE MANUFACTURERS: TRANE, LENNOX, McQUAY CARRIER.

### <u>AUTOMATIC TEMPERATURE CONTROLS</u>

- THE MECHANICAL CONTRACTOR SHALL PROVIDE A COMPLETE SYSTEM OF AUTOMATIC TEMPERATURE CONTROLS. THIS SYSTEM SHALL INCLUDE BUT NOT BE LIMITED TO: HEAT/OFF/COOL/AUTO - THERMOSTAT, AUTO/MANUAL - FAN, TRANSFORMERS AND ALL REQUIRED RELAYS, WIRING AND CONDUIT. THERMOSTAT SHALL BE I DAY PROGRAMMABLE WITH AUTOMATIC CHANGE OVER FROM HEATING TO COOLING AND VICE VERSA.
- !. DUCT MOUNTED SMOKE DETECTORS SHALL BE FURNISHED BY THE ELECTRICAL CONTRACTOR AND INSTALLED BY THE MECHANICAL CONTRACTOR WHEN THE DUCT TYPE SMOKE DETECTOR IS REQUIRED TO BE PART OF THE DESIGN BUILD FIRE ALARM SYSTEM. WHEN NOT PART OF THE FIRE ALARM SYSTEM. THE DUCT MOUNTED SMOKE DETECTORS SHALL BE FURNISHED AND INSTALLED BY THE MECHANICAL CONTRACTOR AND PROVIDED AT 24 VAC. DUCT MOUNTED SMOKE DETECTORS SHALL SHUT DOWN THE RESPECTIVE UNIT AND ALL ADDITIONAL UNITS IN A COMMON AREA IF THE SUMMATION OF THE AIRFLOWS EXCEED 2000 CFM TOTAL.

### <u>PLUMBING EQUIPMENT</u>

PROVIDE PLUMBING EQUIPMENT AS SPECIFIED AND/OR SCHEDULED HEREIN AND IN ACCORDANCE WITH MANUFACTURER'S PUBLISHED INSTALLATION INSTRUCTIONS. EQUIPMENT SHALL OPERATE ACCORDING TO THE MANUFACTURER'S "OWNER'S OPERATING AND MAINTENANCE MANUAL" TROUBLE FREE AND CONFORMING TO THE ONE-YEAR WARRANTEE.

#### PLUMBING PRODUCTS

- I. GAS PIPING: ABOVE GRADE SCHEDULE 40 BLACK IRON(ASME A-53), THREADED MALLEABLE FITTINGS INSIDE AND GALVANIZED FITTINGS AND PIPE WHERE EXPOSED, JOINT COMPOUND. PROVIDE ISOLATION VALVES AT ALL EQUIPMENT. BELOW GRADE GAS PIPING SHALL BE POLYETHYLENE (PE) GAS PIPING WITH BUT FUSION JOINTS, PIPING SHALL BE LABELED GAS, GAS VALVE SHALL BE BRONZE BODY, BRONZE TAPERED PLUG, NON-LUBRICATED, TEFLON PACKING, THREADED
- 2. PIPE INSULATION: ALL DOMESTIC COLD WATER PIPING (IN UNCONDITIONED SPACES ONLY) AND ALL DOMESTIC HOT WATER PIPING ABOVE GROUND SHALL B INSULATED WITH I" THICK FIBERGLASS PIPE INSULATION WITH ALL-SERVICE JACKET AND MAXIMUM K VALUE OF 0.27 AT 15°F. WHERE CLEARANCE LIMITATIONS PREVENT THE USE OF FIBERGLASS INSULATION, A MINIMUM 3/4" THICK CLOSED CELL NEOPRENE PIPE INSULATION MAY BE USED.
- 3. PIPE HANGERS: PIPE SIZES 1/2" TO 1 1/2": MALLEABLE IRON, CARBON STEEL, ADJUSTABLE SWIVEL, SPLIT RING. PIPE SIZES 2" TO 4": CARBON STEEL, ADJUSTABLE, CLEVIS. PIPE SIZES 6" AND OVER: ADJUSTABLE STEEL YOKE, CAST IRON ROLL, DOUBLE HANGER.
- 4. CONDENSATE DRAIN PIPING: TYPE "M" COPPER (ASTM B-88), WROUGHT FITTINGS (ASME BIG.22), JOINTS: ANSI/ASTM B32, SOLDER, GRADE 95 TA, Ø2% MAX LEAD.

## TEST AND BALANCE REPORT (TAB)

I. BALANCE ALL DUCTS, DIFFUSERS, AND GRILLES TO OBTAIN THE AIR QUANTITIES AS SHOWN ON PLANS. TEST AND BALANCE WORK SHALL BE PERFORMED BY AN INDEPENDENT, APPROVED, AND CERTIFIED AABC OR NEBB CONTRACTOR. 2. THE TEST AND AIR BALANCE (TAB) REPORT SHALL INCLUDE DESIGN AIR QUANTITIES AND AIR QUANTITIES AFTER ADJUSTMENTS, FURNISH OWNER'S REPRESENTATIVE WITH THREE (3) COPIES OF THE FINAL TAB REPORT.

- I. DIELECTRIC FITTINGS SHALL BE USED WHEREVER DISSIMILAR METALS ARE JOINED. 2. PROVIDE ACCESS PANELS IN CEILING TO ACCESS VOLUME DAMPERS WHERE
- 3. PLUMBING FIXTURES: PROVIDE CHROME PLATED ANGLE STOPS WITH ESCUTCHEON PLATES AT PLUMBING FIXTURES. ALL PLUMBING FIXTURES SHALL COMPLY WITH LOCAL REGULATIONS AND ADOPTED WATER CONSERVATION CODES.
- 4. DISINFECT ALL POTABLE WATER SYSTEMS IN ACCORDANCE WITH PLUMBING CODE AND/OR, AWWA STANDARD. PROVIDE WRITTEN CONFIRMATION TO OWNERS REPRESENTATIVE THAT THIS WORK HAS BEEN COMPLETED.

- I. THE CONTRACTOR SHALL PROVIDE ALL SLEEVES, OPENINGS, CUTTING, AND PATCHING NECESSARY FOR THE INSTALLATION OF THE WORK. CUTTING AND PATCHING SHALL BE DONE BY WORKMEN SKILLED IN THE TRADES REQUIRED AND PAID BY THE CONTRACTOR REQUIRING THE WORK COMPLETED.
- 2. THE CONTRACTOR SHALL PROVIDE ALL RIGGING, HANDLING OF MATERIALS AND EQUIPMENT, AND THE NECESSARY PROTECTION FOR MATERIALS AND EQUIPMENT. 3. THE CONTRACTOR WILL PROTECT THE WORK AND MATERIAL AGAINST DIRT, THEFT, INJURY OR DAMAGE UNTIL ACCEPTED BY OWNER. ALL WORK SHALL BE TURNED

OVER TO OWNER CLEAN AND IN NEW CONDITION

- 4. PIPES AND/OR CONDUITS PASSING THROUGH WALL, FLOORS AND PARTITIONS SHALL BE PROVIDED WITH SLEEVES. SLEEVES PASSING THROUGH WATER PROOFING OR DAMP PROOFING SHALL BE WATER TIGHT. SLEEVES PASSING THROUGH FIRE RATED CONSTRUCTION SHALL BE FIRE PROOFED WITH MATERIAL APPROVED FOR THE FIRE RATING OF THE SEPARATION AREA AND U.L. LISTED.
- 5. EACH CONTRACTOR SHALL PROVIDE ALL FOUNDATIONS, HANGERS, AND SUPPORTS FOR ALL EQUIPMENT SUPPLIED AND/OR INSTALLED UNDER THEIR WORK. ANY EQUIPMENT WITH MOVING PARTS SHALL BE PROVIDED WITH VIBRATION ISOLATION
- AND FLEXIBLE CONNECTIONS TO PIPING AND OR DUCTWORK IF APPLICABLE. 6. WHERE PIPES OR CONDUITS PASS THROUGH WALLS, FLOORS, OR CEILINGS IN FINISHED AREAS, THEY SHALL BE FURNISHED WITH ESCUTCHEON PLATES (COLOR PER
- ARCHITECT AND/OR INTERIOR DESIGNER). 7. AT THE CONCLUSION OF THE JOB, EACH PIECE OF EQUIPMENT, VALVE, SWITCH, STARTER, PANEL, PIPE LINE, CONDUIT, DUCT, ETC., SHALL BE CLEARLY IDENTIFIED WHETHER EXPOSED OR CONCEALED, COVERED OR UNCOVERED, IN ACCORDANCE WITH OSHA AND ANSI REGULATIONS, IDENTIFY PIPES NEAR EACH VALVE WITH "BRANDY-PERMA" CODE PIPE TAPE" OR T. & B. WESTLINE "TEL-A-PIPE" INDICATING DIRECTION OF FLOW, SERVICE, ZONE, AND SIZE. TAPE SHALL BE APPLIED TO PIPE CONDUIT, OR COVERING. VALVES, CONTROLS, AND DAMPERS SHALL BE IDENTIFIED BY 2-INCH LACQUERED BRASS TAGS WITH STAMPED LETTERS FASTENED WITH "S" HOOKS OR CHAINS. EQUIPMENT IS TO BE IDENTIFIED AS TO FUNCTION AND PURPOSE BY MEANS OF PERMANENTLY ATTACHED LAMINATED ENGRAVED PHENOLIC NAMEPLATES WITH BEVELED EDGES, AND WHITE LETTERS ON BLACK BACKGROUND. (NO ADHESIVE LABELS ALLOWED).
- 8. AT THE CONCLUSION OF THE WORK, ALL EQUIPMENT AND SYSTEMS SHALL BE BALANCED, ADJUSTED, AND TESTED TO PROVIDE A QUIET-OPERATING, STABLE, AND SAFELY OPERATING SYSTEM(S). DEMONSTRATE OPERATION OF ALL SYSTEMS TO THE OWNER'S DESIGNATED REPRESENTATIVE. THE TEST AND BALANCE WORK SHALL BE PERFORMED IN ACCORDANCE WITH NEBB OR AABC STANDARDS, BY INDEPENDENT, APPROVED, AND CERTIFIED TEST AND BALANCE PERSONNEL
- 9. THE MECHANICAL/PLUMBING CONTRACTOR IS RESPONSIBLE FOR RETAINING AND PAYING FOR THE DESIGN SERVICES OF A STRUCTURAL ENGINEER TO CREATE THE DESIGN AND INSTALLATION DRAWINGS FOR MECHANICAL/PLUMBING SYSTEMS SEISMIC RESTRAINT SUPPORT, PER THE PROJECT BUILDING CODE. PRIOR TO CONSTRUCTION, THE CONTRACTOR SHALL SUBMIT MECHANICAL SYSTEMS SHOP DRAWINGS BASED UPON MULTI DISCIPLINE COORDINATION. INCLUDED WITH THE SHOP DRAWING SUBMISSION SHALL BE SEISMIC RESTRAINT DRAWINGS NOTING WHERE SEISMIC SUPPORT IS REQUIRED. FOR EACH AREA NOTED NEEDING SEISMIC SUPPORT FOR TH MECHANICAL SYSTEMS, THERE SHALL BE A SEISMIC DRAWING DETAILING THE REQUIRED SUPPORT. THE SEISMIC SUPPORT DRAWINGS SHALL BE SIGNED AND SEALED BY A REGISTERED STRUCTURAL ENGINEER IN THE SAME STATE AS THE PROJECT. IN ADDITION TO THE PROJECT DESIGN TEAM REVIEW, THE SEISMIC SUPPORT DRAWINGS WILL BE ISSUED TO THE LOCAL BUILDING DEPARTMENT FOR REVIEW AS PART OF A DEFERRED SUBMITTAL FOR THE BUILDING DOCUMENTS. COMMENCEMENT OF CONSTRUCTION PRIOR TO BUILDING DEPARTMENT REVIEW IS AT THE CONTRACTOR'S RISK.
- 10. CONTRACTOR SHALL REFER TO THE ARCHITECTURAL REFLECTED CEILING PLAN FOR EXACT LOCATION OF GRILLES, REGISTERS AND DIFFUSERS.
- II. PIPE HANGERS: PIPE SIZES 1/2" TO 1 1/2" 6'-0" MAX SPACING, 3/8" ROD DIAMETER: PIPE SIZES 2" TO 3" - 10'-0" MAX SPACING, 1/2" ROD DIAMETER; PIPE SIZES 4 TO 6"-10'-0" MAX SPACING, 5/8" ROD DIAMETER. DAMPERS.
- 12. WATER PROOFING AND FLASHING OF PIPE PENETRATIONS THROUGH EXTERIOR WALL AND ROOF SHALL BE BY THIS CONTRACTOR. PLUMBING CONTRACTOR SHALL COORDINATE LOCATIONS AND METHODS WITH GENERAL CONTRACTOR PRIOR TO CONSTRUCTION OF ROOF DECK.
- 13. CONTRACTOR SHALL OBTAIN FROM THE ARCHITECT THE EXACT LOCATION OF EQUIPMENT, PLUMBING FIXTURES, FLOOR DRAINS AND ANY OTHER APPARATUS SPECIFIED IN THESE DRAWINGS. 14. PROVIDE CLEAN OUTS IN SANITARY, WASTE AND DRAIN LINES AS SHOWN AND AS
- REQUIRED BY LOCAL CODE. ALL CLEANOUTS SHALL BE READILY ACCESSIBLE. 15. PROVIDE BALANCE VALVE FOR HOT WATER RETURN SYSTEM AS REQUIRED. 16. PROVIDE PRESSURE REDUCING VALVE IN SYSTEM AS REQUIRED. 17. PROVIDE HEAT TRAPS (INTEGRAL OR EXTERNAL) FOR ALL WATER HEATING
- EQUIPMENT. 18. PROVIDE A NON-VENTED TRAP ON ALL INDIRECT WASTE PIPING FIVE (5) TO FIFTEEN (15) FEET IN DEVELOPED LENGTH. INDIRECT WASTE PIPING WITH ANGLES

AND CHANGES OF DIRECTION SHALL BE BE PROVIDED WITH CLEANOUTS.

19, WHERE A SINK IN A BAR, SODA FOUNTAIN, OR COUNTER HAS IN INDIRECT WASTE, THE DEVELOPED LENGTH FROM THE SINK OUTLET SHALL NOT EXCEED FIVE (5)

# MECHANICAL/PLUMBING SYMBOL LIST

NOTE: THIS IS A MASTER SCHEDULE. NOT ALL SYMBOLS CONTAINED HEREIN MAY APPEAR ON THE DRAWINGS. ITEM TO BE REMOVED HEATING WATER RETURN PIPING POINT OF CONNECTION/DISCONNECTION HEATING WATER SUPPLY PIPING SHEET NOTE REFRIGERANT LIQUID PIPING REFRIGERANT SUCTION PIPING REVISION NUMBER COMPRESSED AIR LINES EQUIPMENT MARK CONDENSATE DRAIN PIPING TAG DIFFUSER TAG PUMPED CONDENSATE DRAIN PIPING DRAIN PIPING ACCESS PANEL COLD WATER PIPING SUPPLY AIR DUCT UP/DOWN INDUSTRIAL COLD WATER PIPING RETURN AIR DUCT UP/DOWN INDUSTRIAL SOFTENED COLD WATER PIPING EXHAUST AIR DUCT UP/DOWN SOFTENED COLD WATER PIPING \_\_\_\_SCW\_\_\_ RETURN GRILLE FIRE PROTECTION PIPING ——F—— EXHAUST GRILLE HIGH PRESSURE GAS PIPING

4-WAY BLOW SUPPLY DIFFUSER LOW PRESSURE GAS PIPING 3-WAY BLOW SUPPLY DIFFUSER MEDIUM PRESSURE GAS PIPING 2-WAY BLOW SUPPLY DIFFUSER GAS VENT PIPING 1-WAY BLOW SUPPLY DIFFUSER HOT WATER PIPING \_\_\_\_ AIRFLOW DIRECTION 140° HOT WATER PIPING HOT WATER RETURN PIPING --"Φ ROUND DUCTWORK --"X--" RECTANGULAR DUCTWORK TEMPERED WATER PIPING  $\sim$ ROUND FLEXIBLE DUCT OVERFLOW ROOF DRAIN PIPING SQUARE TO ROUND TRANSITION ROOF DRAIN PIPING \_\_\_\_ SINGLE LINE RIGID DUCT ACID VENT PIPING ----*A*V----\_\_\_\_ SINGLE LINE RIGID DUCT (ACOUSTICALLY LINED) ABOVE GROUND ACID WASTE PIPING UNDERGROUND ACID WASTE PIPING DOUBLE LINE RIGID DUCT - - - AW- - ------DOUBLE LINE RIGID DUCT (ACOUSTICALLY LINED) ABOVE GROUND WASTE PIPING EXISTING DUCTWORK UNDERGROUND WASTE PIPING \_\_\_\_\_

ABOYE GROUND GREASE WASTE PIPING

ABOVE GROUND GREASE WASTE PIPING W/HEAT TRACE

GAL

GALLONS

UNDERGROUND GREASE WASTE PIPING

2-WAY ELECTRONIC CONTROL VALVE

3-WAY ELECTRONIC CONTROL VALVE

2-WAY PNEUMATIC CONTROL VALVE

3-WAY PNEUMATIC CONTROL VALVE

SOLENOID VALVE

BUTTERFLY VALVE

PLUG YALVE

BALL VALVE

CHECK YALVE

GATE VALVE

RELIEF YALVE

THERMOMETER

MANUAL AIR VENT

PIPE GUIDE

HOSE END DRAIN VALVE

PRESSURE REDUCING YALVE

TEMPERATURE PRESSURE RELIEF VALVE

PRESSURE GAUGE WITH GAUGE COCK

PRESSURE TEMPERATURE PORT

Y-STRAINER WITH BLOWDOWN

FLEXIBLE CONNECTOR

PIPE CAP/STUB-OUT

DIRECTION OF FLOW

PIPE DOWN

PIPE TEE UP

PIPE UP

FIRE DAMPER SMOKE DAMPER FIRE/SMOKE DAMPER MOTORIZED DAMPER (OPPOSED BLADE TYPE) MOTORIZED DAMPER (PARALLEL BLADE TYPE) BACKDRAFT DAMPER MANUAL VOLUME DAMPER

REMOTE VOLUME DAMPER SMOKE DETECTOR THERMOSTAT

HUMIDISTAT SENSOR CARBON DIOXIDE SENSOR

RYD

\_\_\_\_CR\_\_\_

CARBON MONOXIDE SENSOR DOOR UNDERCUT CLEAN OUT WALL CLEAN OUT FLOOR CLEAN OUT

GRADE CLEAN OUT FLOOR DRAIN FLOOR SINK

FLOOR SINK W/ GRATE ROOF DRAIN OVERFLOW ROOF DRAIN YENT THRU ROOF

FLOW SWITCH GAS REGULATOR GAS METER WATER METER

WATER HAMMER ARRESTOR SHUT-OFF YALVE IN IRRIGATION BOX BACKFLOW PREVENTION STATION

HOSE BIBB CHILLED WATER RETURN PIPING ----CHR----CHILLED WATER SUPPLY PIPING

CONDENSER WATER SUPPLY PIPING

PIPE TEE DOWN CONDENSER WATER RETURN PIPING

# MECHANICAL/PLUMBING ABBREVIATIONS

NOTE: THIS IS A MASTER SCHEDULE. NOT ALL ABBREVIATIONS CONTAINED HEREIN MAY APPEAR ON THE DRAWINGS.

AABC AMERICAN AIR BALANCE GRADE CLEANOUT COUNCIL GREASE INTERCEPTOR AUTOMATIC CONTROL DAMPER GALLONS PER FLUSH ABOVE FINISHED FLOOR GALLONS PER MINUTE ACCESS PANEL GLYCOL RETURN ASHRAE AMERICAN SOCIETY OF HEATING, GLYCOL SUPPLY REFRIGERATION, AND AIR GREASE WASTE CONDITIONING ENGINEERS HEAD AMERICAN SOCIETY OF PLUMBING ENGINEERS HORSEPOWER ACID VENT HIGH PRESSURE GAS ACID WASTE BACKFLOW PREVENTION DEVICE HEATING SEASONAL PERFORMANCE FACTOR BRAKE HORSE POWER HOT WATER BRITISH THERMAL UNIT PER HEATING HOT WATER RETURN CD CONDENSATE DRAIN HEATING HOT WATER SUPPLY CFM CUBIC FEET PER MINUTE INTERNATIONAL BUILDING CODE CHARACTERISTICS INVERT ELEVATION CHILLED WATER RETURN INTERNATIONAL MECHANICAL CHS CHILLED WATER SUPPLY INTERNATIONAL PLUMBING CODE CO CLEANOUT KILOWATT CR CONDENSER WATER RETURN LEAVING AIR TEMPERATURE CONDENSER WATER SUPPLY POUNDS CWCOLD WATER LEAVING WATER TEMPERATURE MAXDRY BULB TEMPERATURE ONE THOUSAND BTUH DDC DIRECT DIGITAL CONTROL MCA MINIMUM CIRCUIT AMPS DIA DIAMETER MINIMUM MAXIMUM OVER CURRENT DX DIRECT EXPANSION PROTECTION EXISTING TO REMAIN MEDIUM PRESSURE GAS EXHAUST AIR MANUAL VOLUME DAMPER ENTERING AIR TEMPERATURE NOT APPLICABLE N/A ELECTRICAL CONTRACTOR NORMALLY CLOSED ENERGY EFFICIENCY RATIO NATIONAL ENVIRONMENTAL **EFFICIENCY** BALANCING BUREAU ELECTRICAL NATIONAL ELECTRIC CODE ESP EXTERNAL STATIC PRESSURE NATIONAL FIRE PROTECTION ENTERING WATER TEMPERATURE ASSOCIATION FAHRENHEIT NOT IN CONTRACT FC0 FLOOR CLEANOUT NORMALLY OPEN NOT TO SCALE FIRE DAMPER FPM FEET PER MINUTE OUTSIDE AIR FSD FIRE/SMOKE DAMPER OUTSIDE AIR TEMPERATURE OPPOSED BLADE DAMPER GΑ **O**ED GAGE OR GAUGE OPEN END DUCT

PRESSURE DROP PRESSURE REDUCING YALVE POUNDS PER SQUARE INCH POUNDS PER SQUARE INCH ABSOLUTE POUNDS PER SQUARE INCH DIFFERENTIAL POUNDS PER SQUARE INCH EXISTING TO BE RELOCATED (R) RETURN AIR RELATIVE HUMIDITY REFRIGERANT LIQUID/SUCTION RL/S REVOLUTIONS PER MINUTE REDUCED PRESSURE PRINCIPAL ASSEMBLY REMOTE VOLUME DAMPER SUPPLY AIR SMOKE DAMPER SEASONAL ENERGY EFFICIENCY RATIC S01 SAND OIL INTERCEPTOR "SP STATIC PRESSURE (INCHES OF) SPECIFICATIONS SOUARE FEET STAINLESS STEEL TEMPERATURE TEST AND BALANCE WORK AND TOTAL STATIC PRESSURE TEMPERED WATER TYP TYPICAL UNIFORM BUILDING CODE UMC UNIFORM MECHANICAL CODE UON

UNLESS OTHERWISE NOTED UNIFORM PLUMBING CODE VARIABLE FREQUENCY DRIVE YENT THROUGH ROOF WET BULB TEMPERATURE WALL CLEANOUT

Y/PH/HZ YOLTAGE/PHASE/HERTZ YFD YTR WCO WATER GAUGE WIRE MESH SCREEN EXISTING TO BE REMOVED

DRAWING INDEX

INSTALLED


OWNER FURNISHED, CONTRACTOR


NUMBER SHEET TITLE MECHANICAL PLUMBING SYMBOL LIST AND ABBREVIATIONS MECHANICAL IECC COMPLIANCE REPORT MECHANICAL DETAILS AND SCHEDULES MPØ.3 GAS ISOMETRIC MD5.Ø MECHANICAL DEMOLITION ROOF PLAN MECHANICAL DEMOLITION ROOF PLAN MD5.1 MECHANICAL PLAN MECHANICAL PLAN P5.0 PLUMBING PLAN PLUMBING PLAN 10 4 TOTAL





REVISIONS OWNER'S REVISION √ Ø9.17.2Ø13

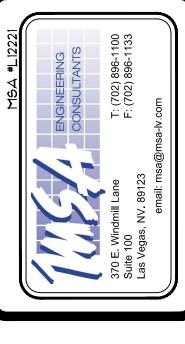


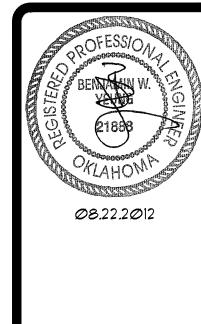



000

(U) \_\_


MSA CHECKED 08.22.2012 AS NOTED L12221 SHEET

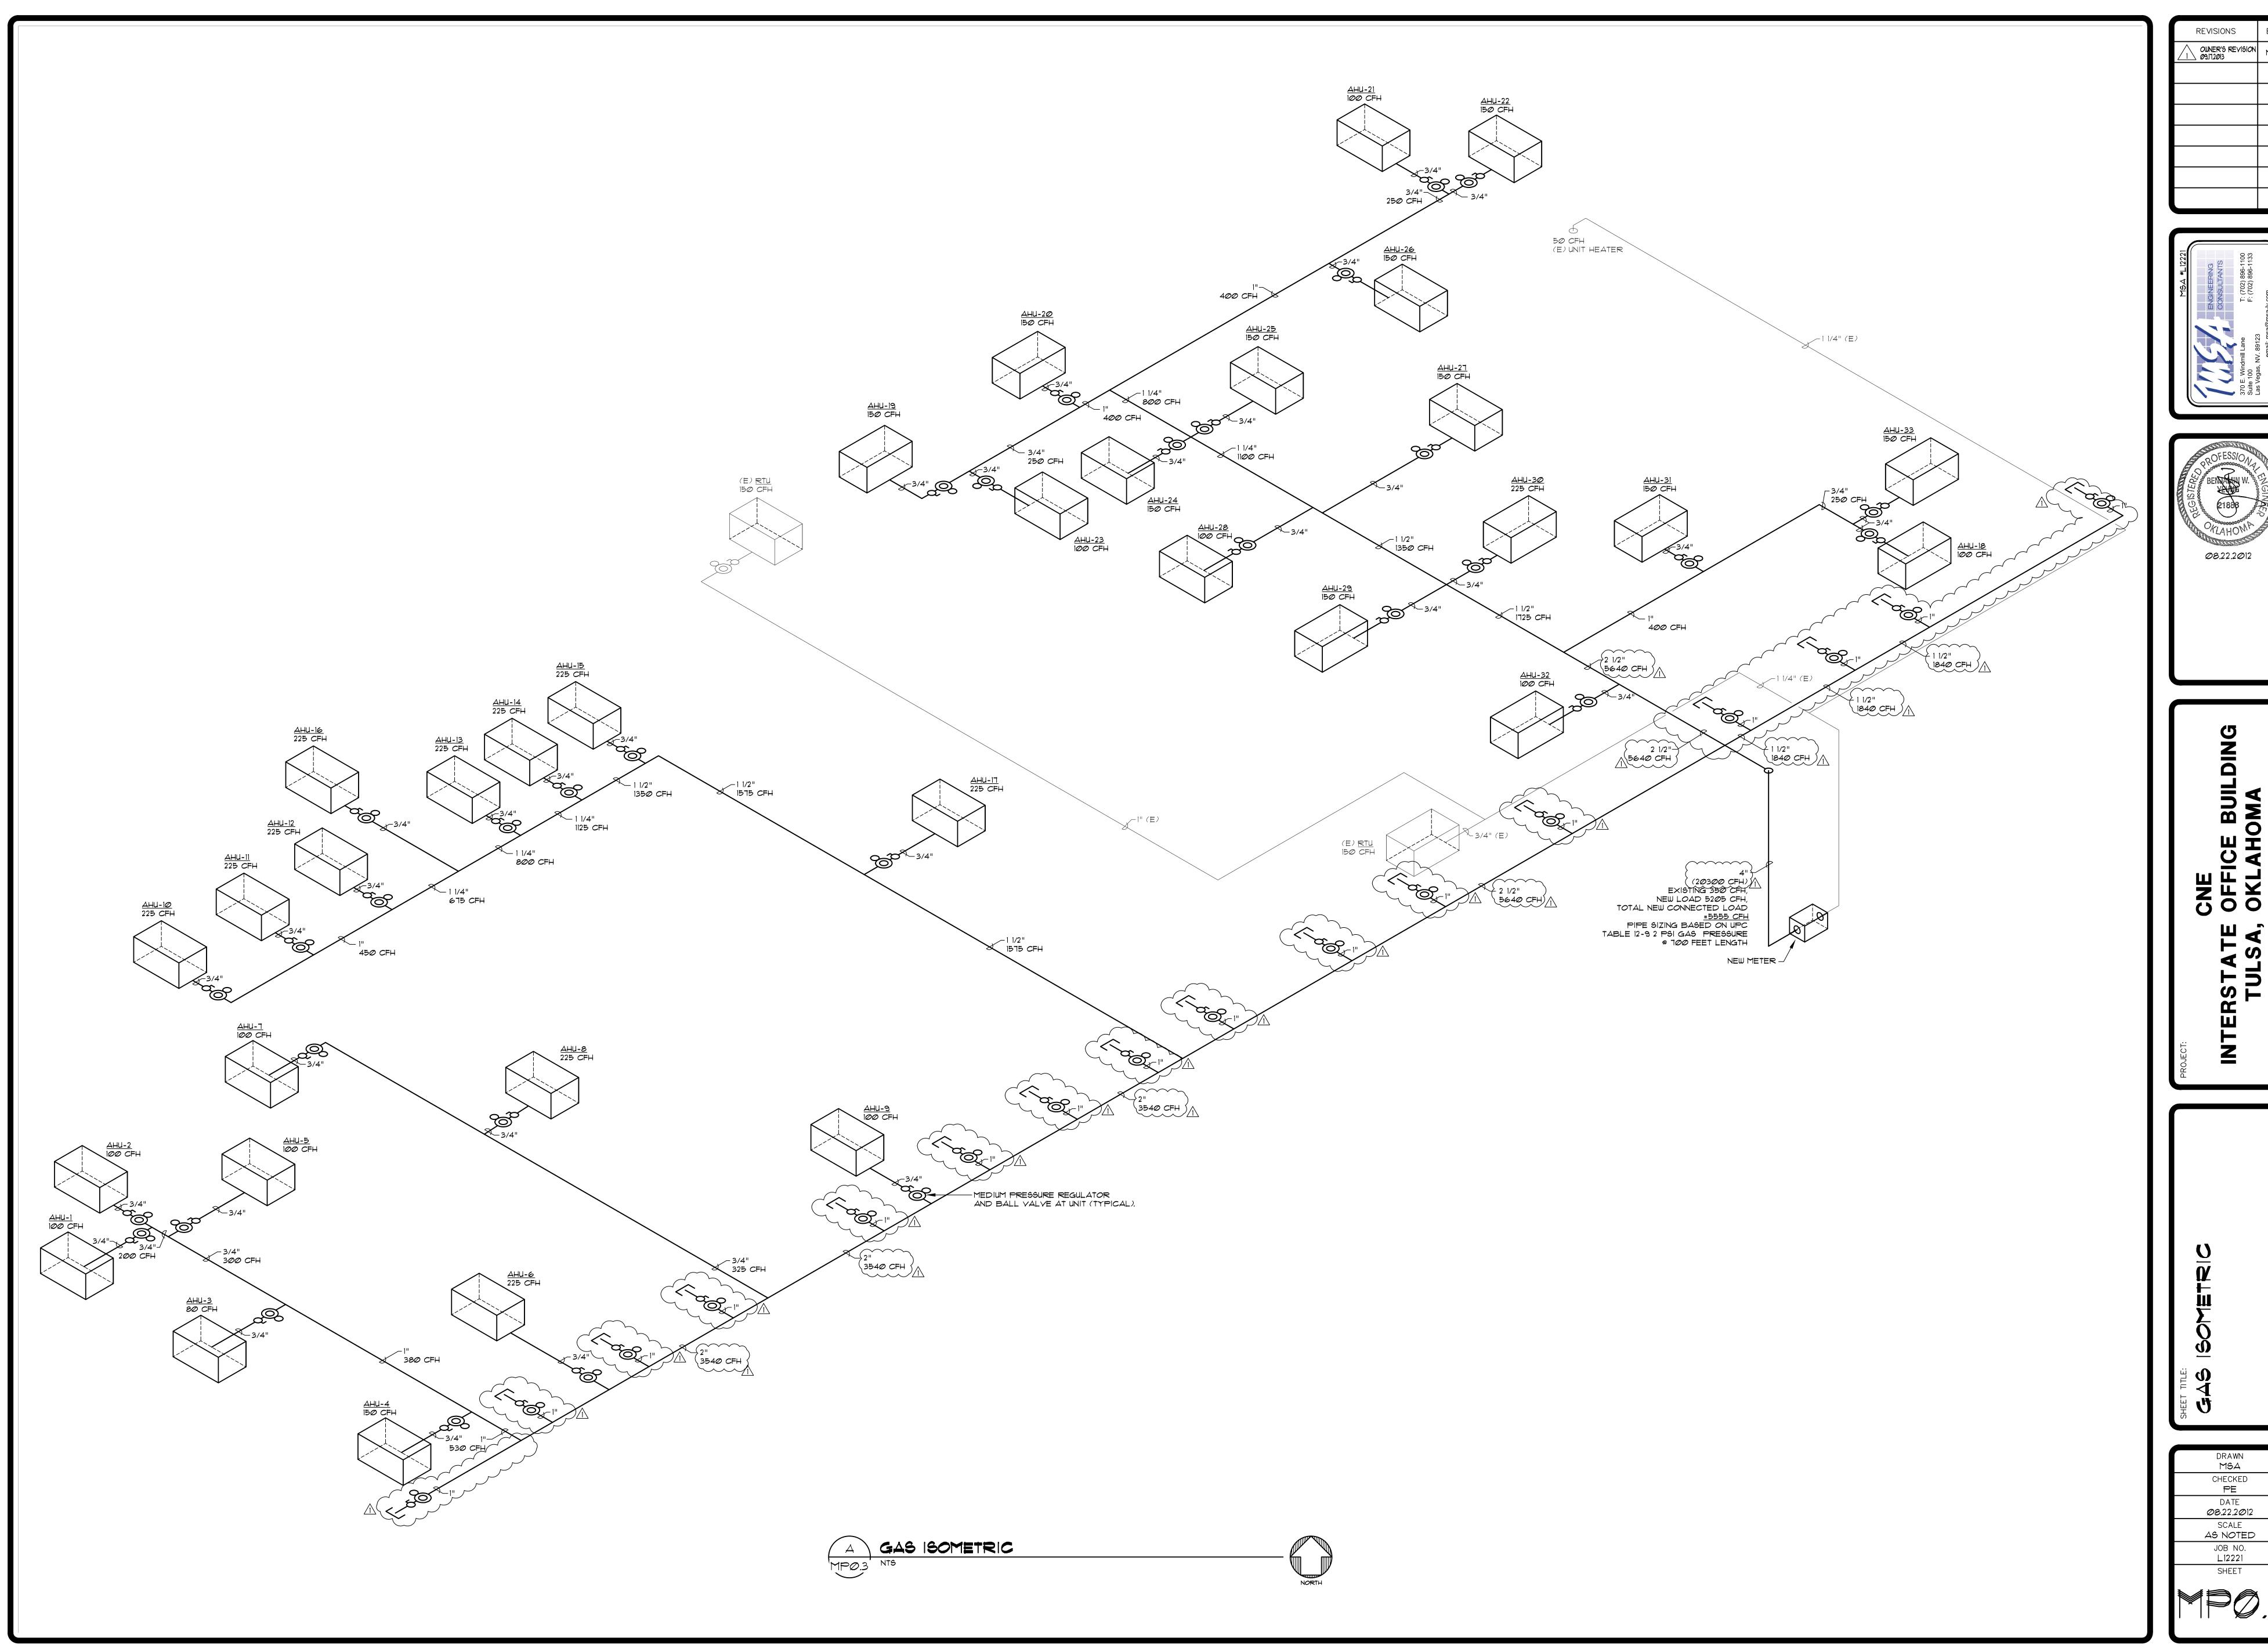

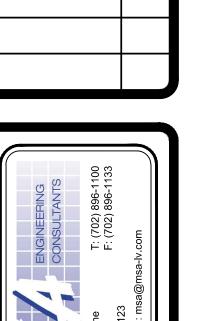

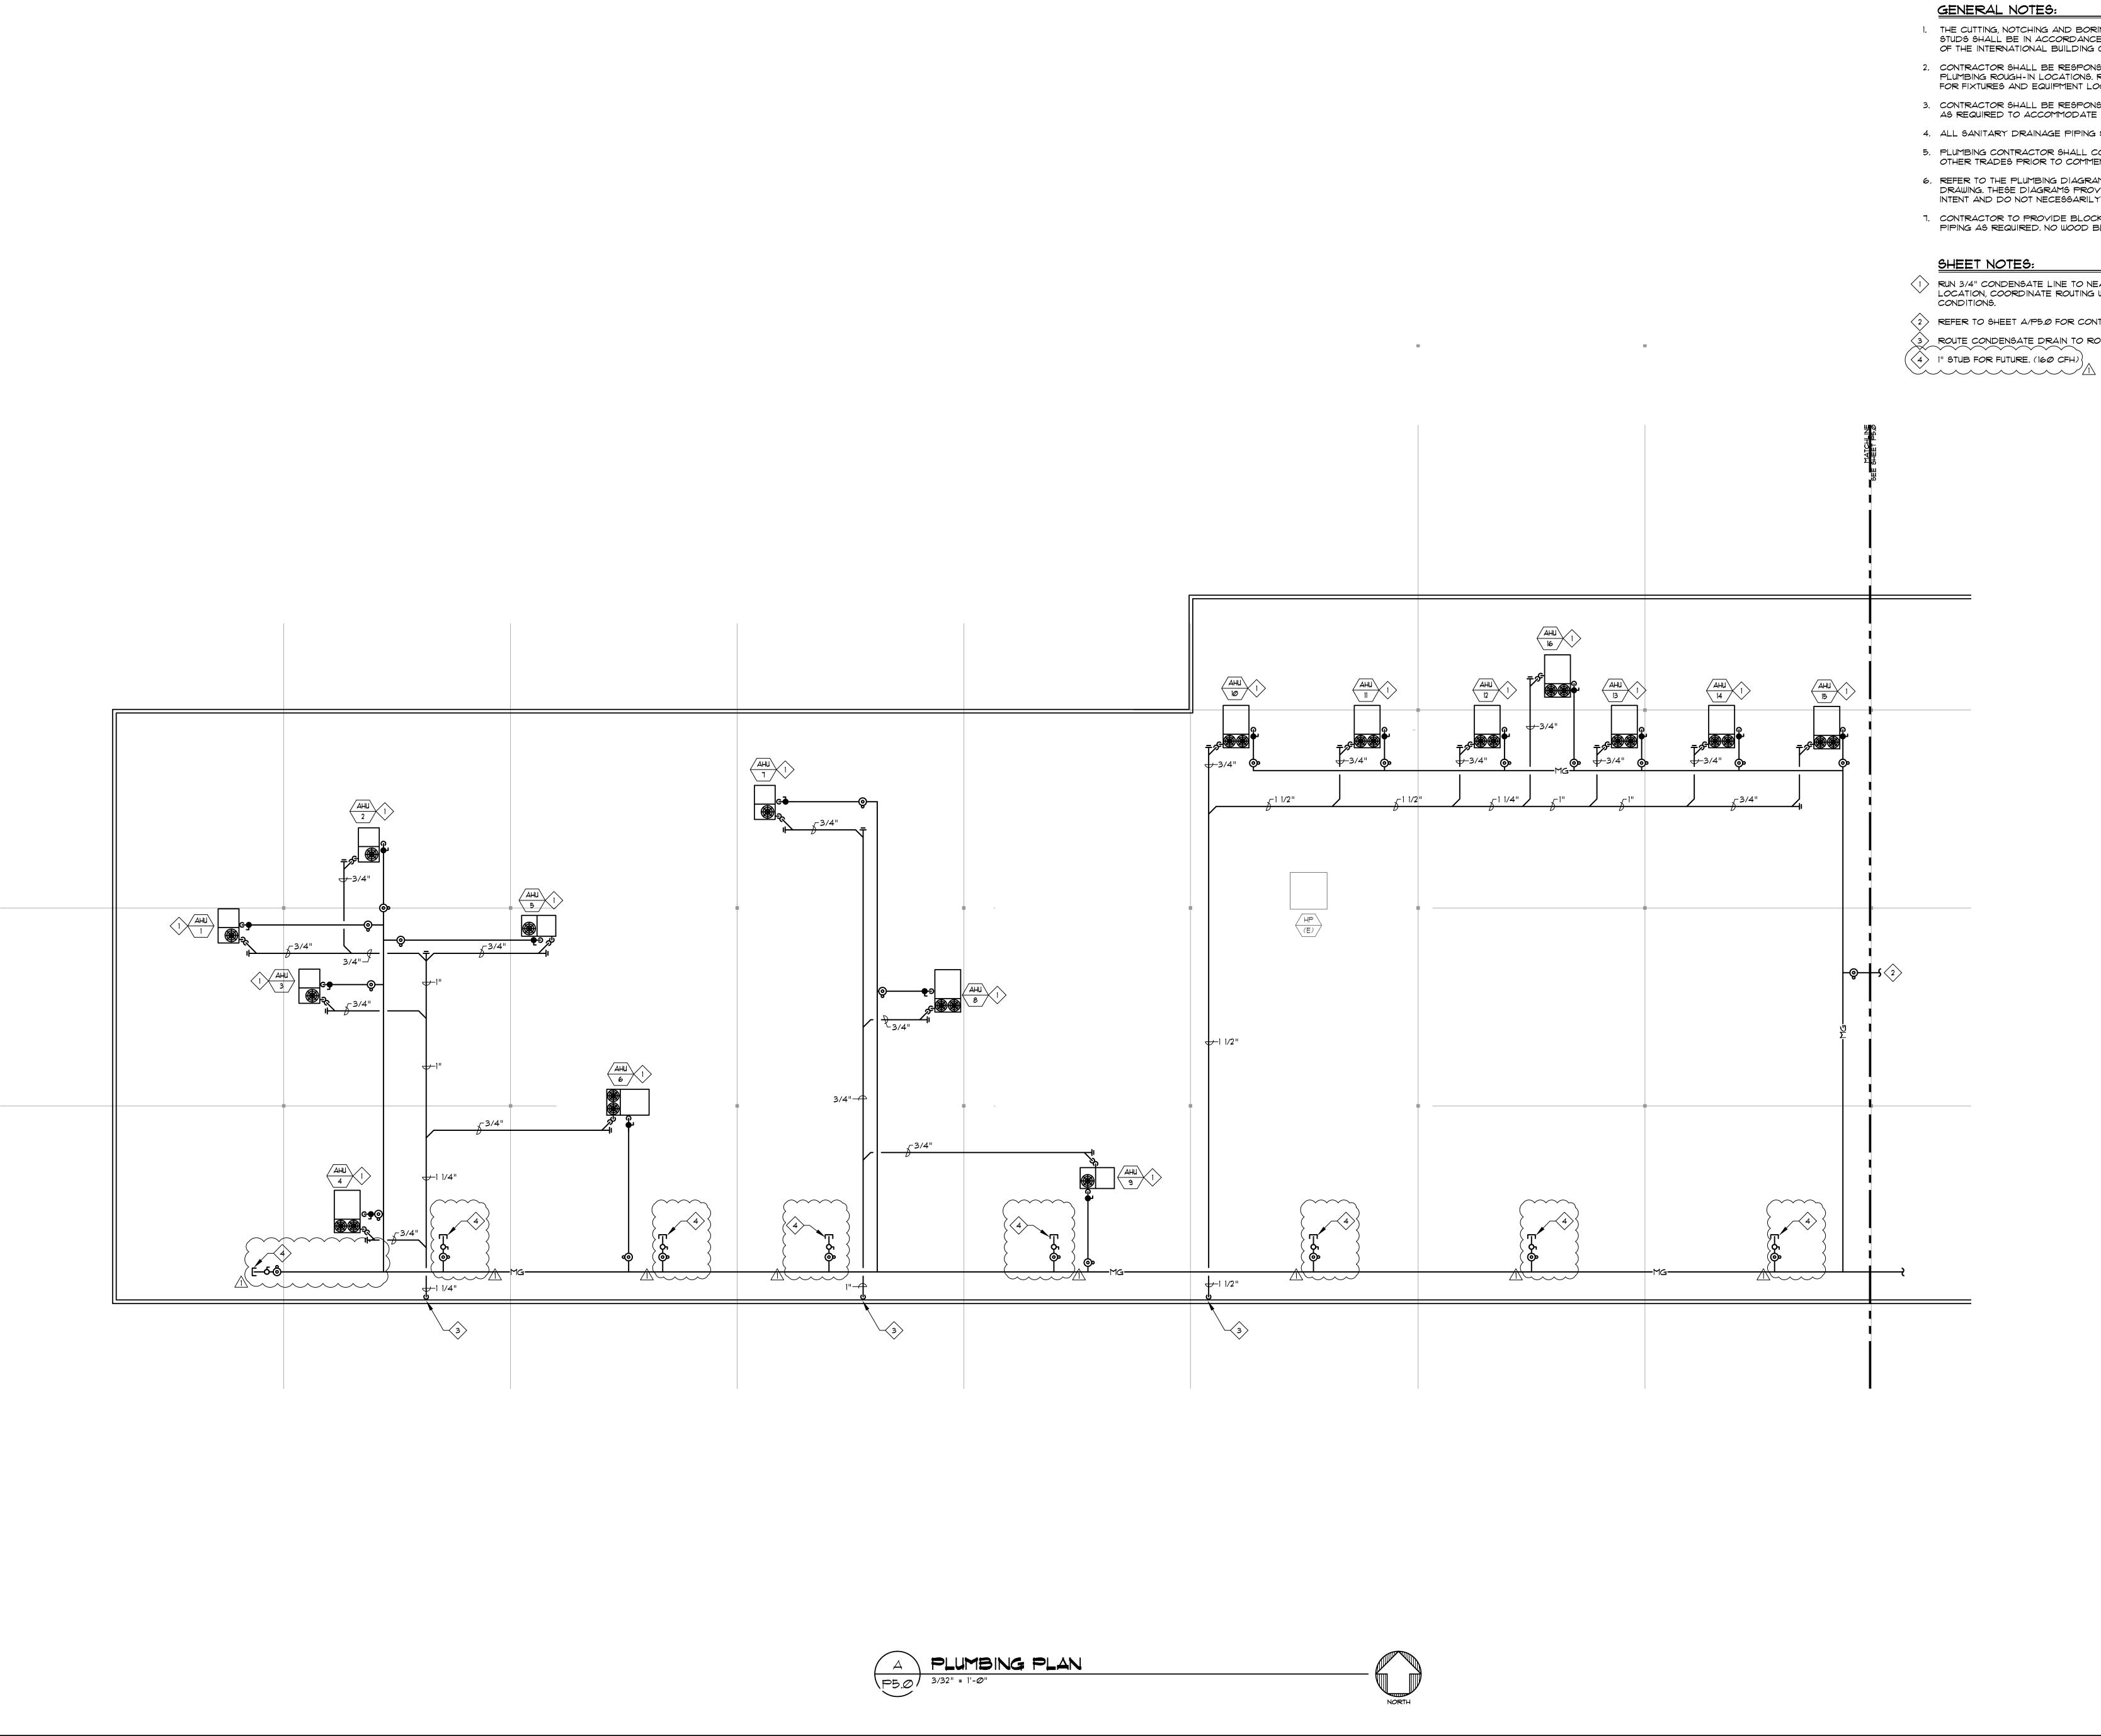

- THE CUTTING, NOTCHING AND BORING OF HOLES IN FLOOR JOIST AND WALL STUDS SHALL BE IN ACCORDANCE WITH THE LATEST APPROVED EDITION OF THE INTERNATIONAL BUILDING CODE.
- CONTRACTOR SHALL BE RESPONSIBLE FOR THE COORDINATION OF ALL PLUMBING ROUGH-IN LOCATIONS. REFER TO ARCHITECTURAL DRAWINGS FOR FIXTURES AND EQUIPMENT LOCATIONS.
- CONTRACTOR SHALL BE RESPONSIBLE FOR ALL CUTTING AND PATCHING AS REQUIRED TO ACCOMMODATE HIS WORK.
- 4. ALL SANITARY DRAINAGE PIPING SHALL BE SLOPED AT 1/4" PER FOOT.
- PLUMBING CONTRACTOR SHALL COORDINATE ROUTING OF PIPING WITH ALL OTHER TRADES PRIOR TO COMMENCING WORK.
- 6. REFER TO THE PLUMBING DIAGRAMS THAT APPLY TO THE WORK ON THIS DRAWING. THESE DIAGRAMS PROVIDE GUIDANCE AS TO INSTALLATION INTENT AND DO NOT NECESSARILY SHOW ALL COMPONENTS REQUIRED.
- CONTRACTOR TO PROVIDE BLOCKS FOR GAS PIPING AND CONDENSATE PIPING AS REQUIRED. NO WOOD BLOCKS
- RUN 3/4" CONDENSATE LINE TO NEAREST RD/ORD. FIELD VERIFY EXACT LOCATION, COORDINATE ROUTING WITH ALL OTHER TRADES AND EXISTING CONDITIONS.
- 2 REFER TO SHEET A/P5.0 FOR CONTINUATION.
- ROUTE CONDENSATE DRAIN TO ROOF DRAINS.

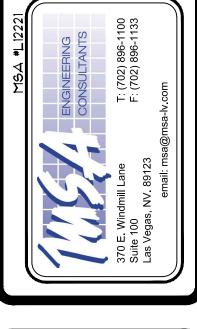


OWNER'S REVISION 09.17.2013



SCALE AS NOTED




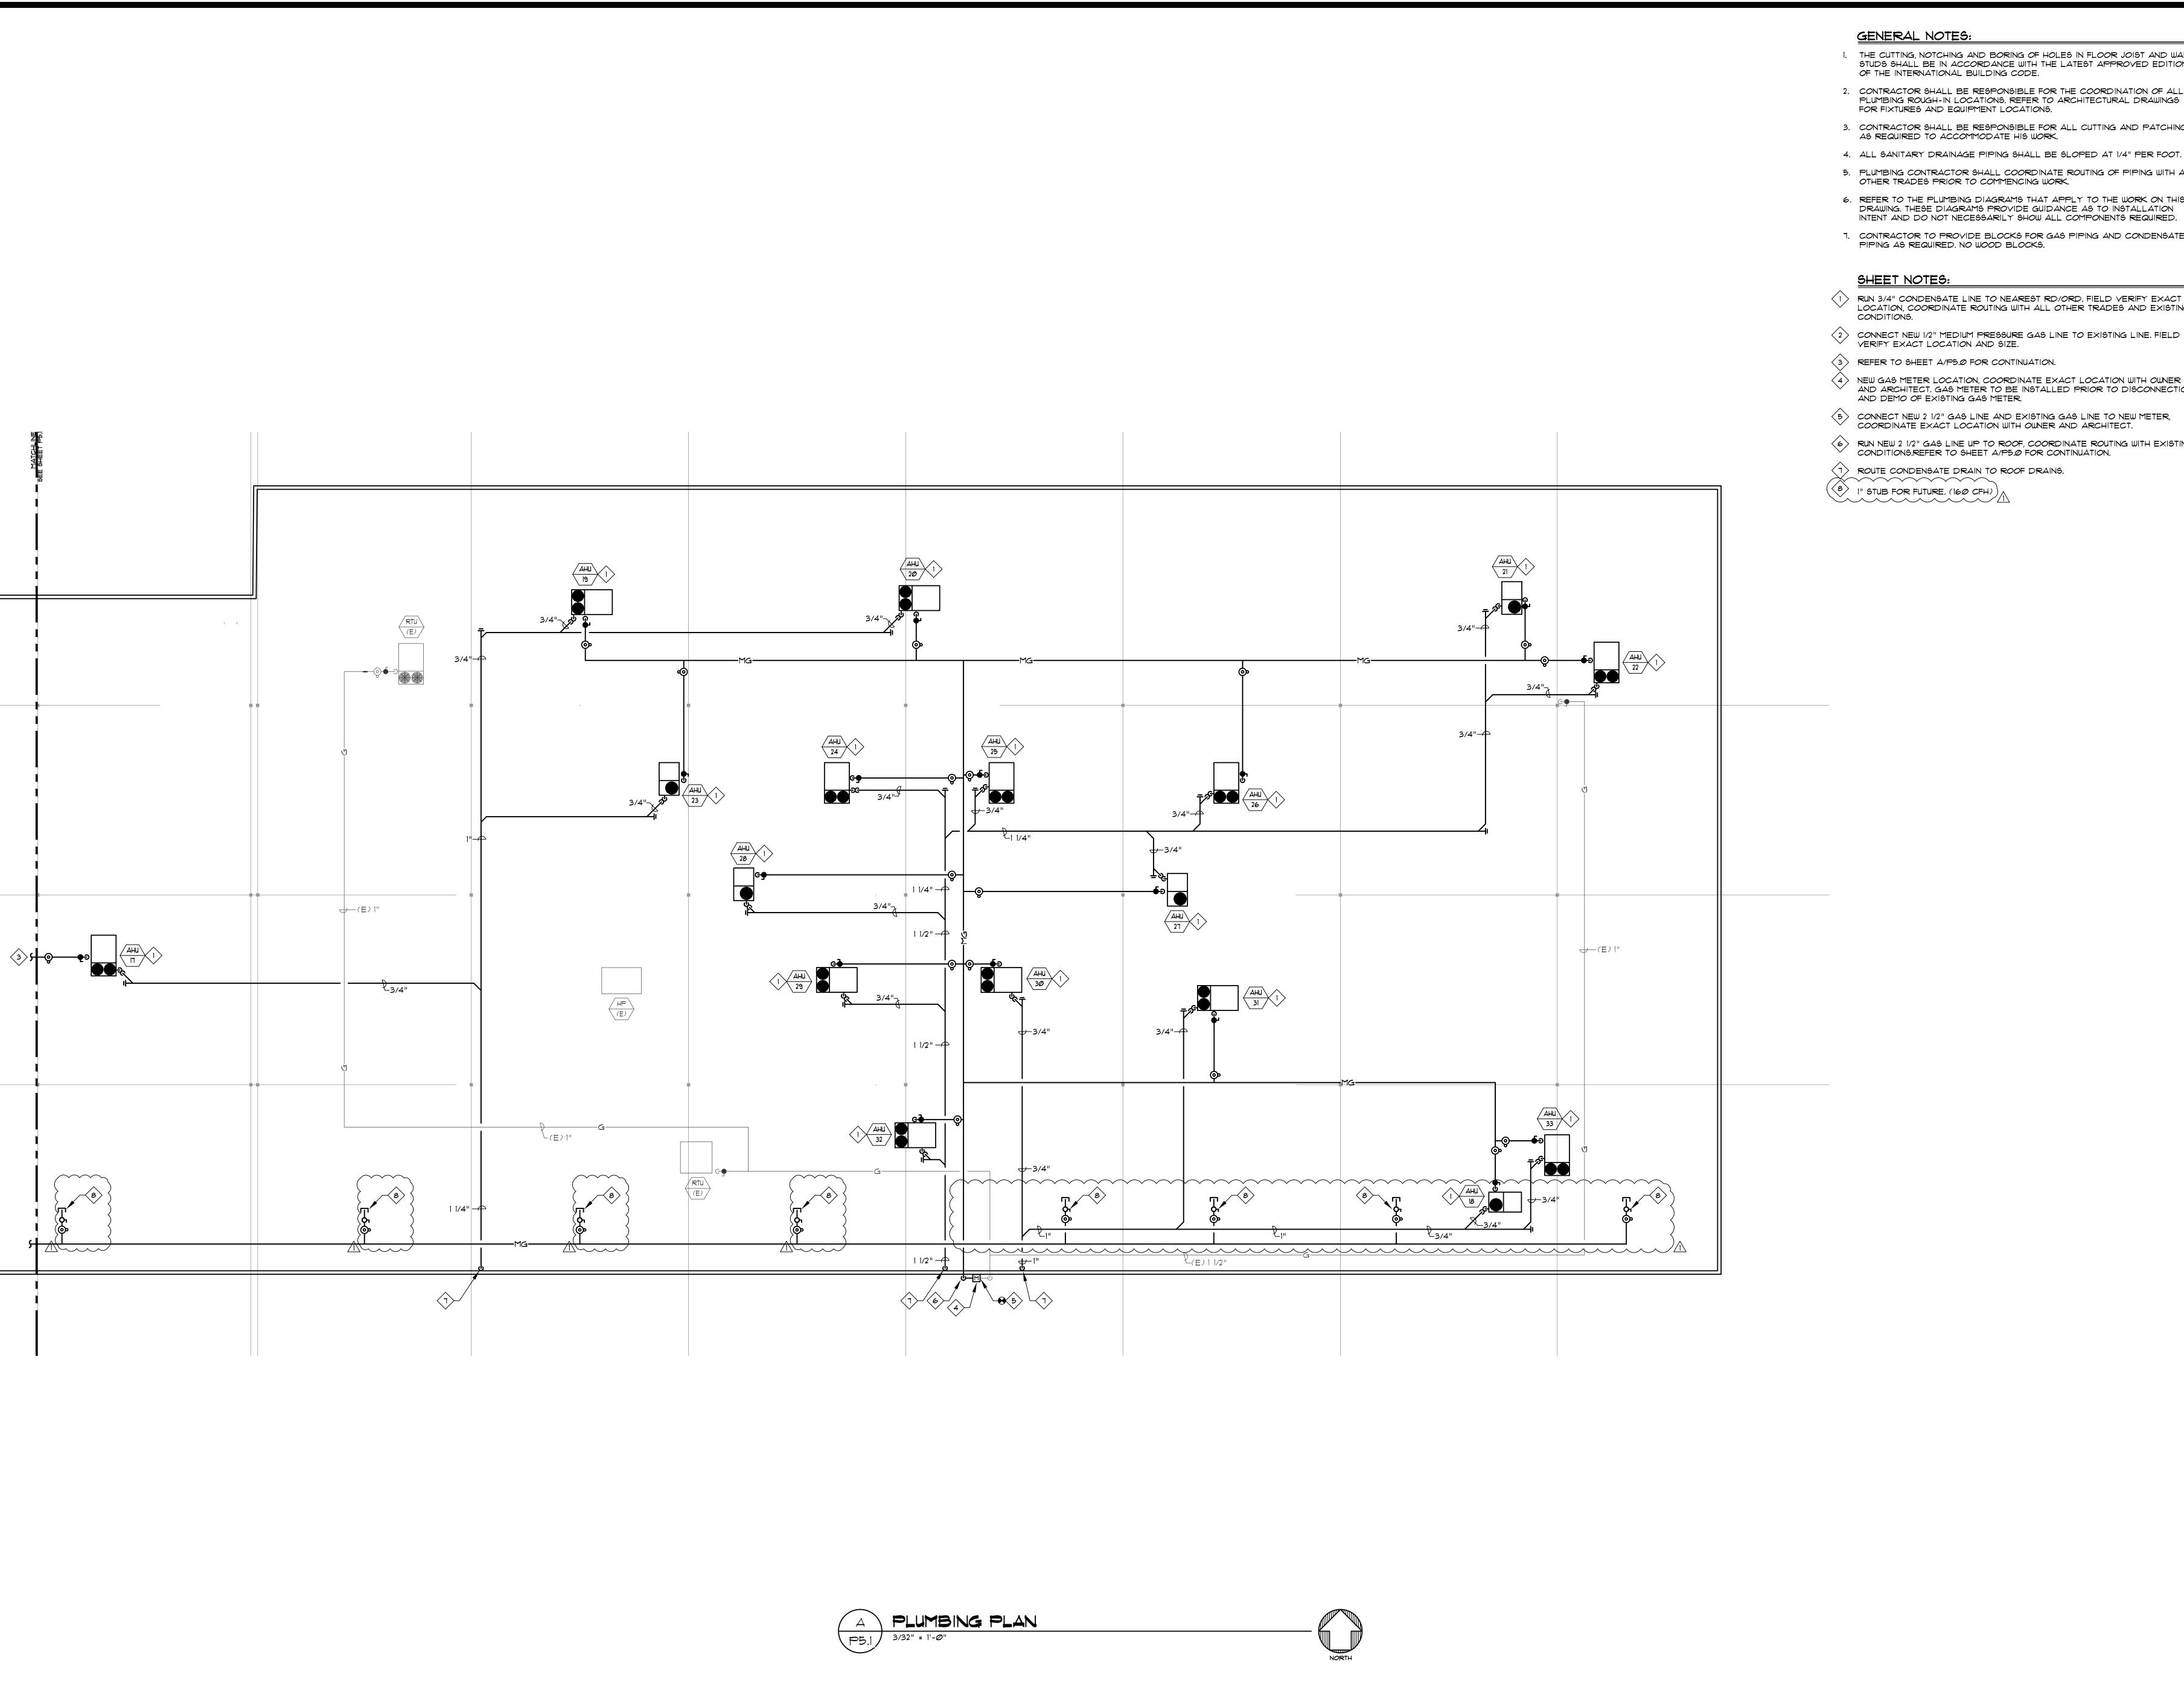


- GENERAL NOTES:
- THE CUTTING, NOTCHING AND BORING OF HOLES IN FLOOR JOIST AND WALL STUDS SHALL BE IN ACCORDANCE WITH THE LATEST APPROVED EDITION OF THE INTERNATIONAL BUILDING CODE.
- CONTRACTOR SHALL BE RESPONSIBLE FOR THE COORDINATION OF ALL PLUMBING ROUGH-IN LOCATIONS. REFER TO ARCHITECTURAL DRAWINGS FOR FIXTURES AND EQUIPMENT LOCATIONS.
- CONTRACTOR SHALL BE RESPONSIBLE FOR ALL CUTTING AND PATCHING AS REQUIRED TO ACCOMMODATE HIS WORK.
- 4. ALL SANITARY DRAINAGE PIPING SHALL BE SLOPED AT 1/4" PER FOOT.
- 5. PLUMBING CONTRACTOR SHALL COORDINATE ROUTING OF PIPING WITH ALL
- OTHER TRADES PRIOR TO COMMENCING WORK. 6. REFER TO THE PLUMBING DIAGRAMS THAT APPLY TO THE WORK ON THIS
- INTENT AND DO NOT NECESSARILY SHOW ALL COMPONENTS REQUIRED.
- CONTRACTOR TO PROVIDE BLOCKS FOR GAS PIPING AND CONDENSATE PIPING AS REQUIRED. NO WOOD BLOCKS.

## SHEET NOTES:

- RUN 3/4" CONDENSATE LINE TO NEAREST RD/ORD. FIELD VERIFY EXACT LOCATION, COORDINATE ROUTING WITH ALL OTHER TRADES AND EXISTING CONDITIONS.
- CONNECT NEW 1/2" MEDIUM PRESSURE GAS LINE TO EXISTING LINE. FIELD VERIFY EXACT LOCATION AND SIZE.
- (3) REFER TO SHEET A/P5.0 FOR CONTINUATION.
- NEW GAS METER LOCATION, COORDINATE EXACT LOCATION WITH OWNER AND ARCHITECT. GAS METER TO BE INSTALLED PRIOR TO DISCONNECTION AND DEMO OF EXISTING GAS METER.
- CONNECT NEW 2 1/2" GAS LINE AND EXISTING GAS LINE TO NEW METER, COORDINATE EXACT LOCATION WITH OWNER AND ARCHITECT.
- RUN NEW 2 1/2" GAS LINE UP TO ROOF, COORDINATE ROUTING WITH EXISTING CONDITIONS.REFER TO SHEET A/P5.0 FOR CONTINUATION.
- ROUTE CONDENSATE DRAIN TO ROOF DRAINS.
- (8) 1" STUB FOR FUTURE. (160 CFH)

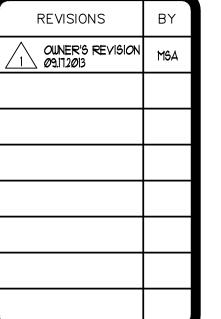

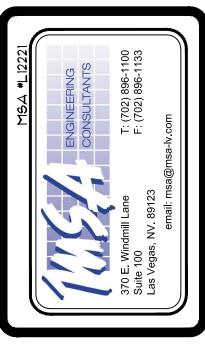



AS NOTED SHEET