



Housing Authority of the Cherokee Nation
1500 Hensley Drive
P.O. Box 1007
Tahlequah, OK 74465-1007
Phone 918-456-5482



Homeowner, Bobby Hernback accepts/declines the required specifications for Handicap Assessability, for Housing Program (New Construction or Rehab).

Items Listed:

GRAB BARS AT TOILET: / Accept / Decline

GRAB BARS AT TUB/SHOWER: / Accept / Decline

HIGH RISE TOILET / Accept / Decline

ADA SHOWER W / TRANSFER: / Accept / Decline

ENTRY DOORWAY OF 36": / Accept / Decline

RAMP: / Accept / Decline

WALL HUNG VANITY: / Accept / Decline


VISUALLY IMPAIRED (BLIND) Accept/Decline

HEARING IMPAIRED (DEAF) Accept/Decline

OTHER Accept/Decline

Homeowners agrees and understands the above and NO other changes will be made after this date.

Homeowner: _____ Date: _____
Dustin Carter 12/6/2023
Inspector Date:

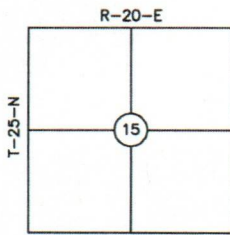

LOCATION MAP

COUNTY: CRAIG

NOTE:

THIS PLAT OF SURVEY MEETS THE OKLAHOMA MINIMUM STANDARDS FOR THE PRACTICE OF LAND SURVEYING AS ADOPTED BY THE OKLAHOMA STATE BOARD OF REGISTRATION FOR PROFESSIONAL ENGINEERS AND LAND SURVEYORS.

BOUNDARY SURVEY PLOT PLAN & AS-BUILT


PREPARED FOR CHEROKEE NATION HOUSING AUTHORITY
PARTICIPANT: BOBBY HORNBACK
MAILING ADDRESS: 737 NORTH SMITH ST., VINITA, OK 74301
UNIT ADDRESS: 737 NORTH SMITH ST., VINITA, OK 74301
UNIT #12825

BASIS OF BEARINGS:
GEODETIC NORTH
LAT 36°39'10.3"N
LONG 95°09'04.5"W



LEGEND

- SET IRON PIN
W/ CAP LST1316
- FOUND MONUMENT
- ONE - OVERHEAD ELECTRIC

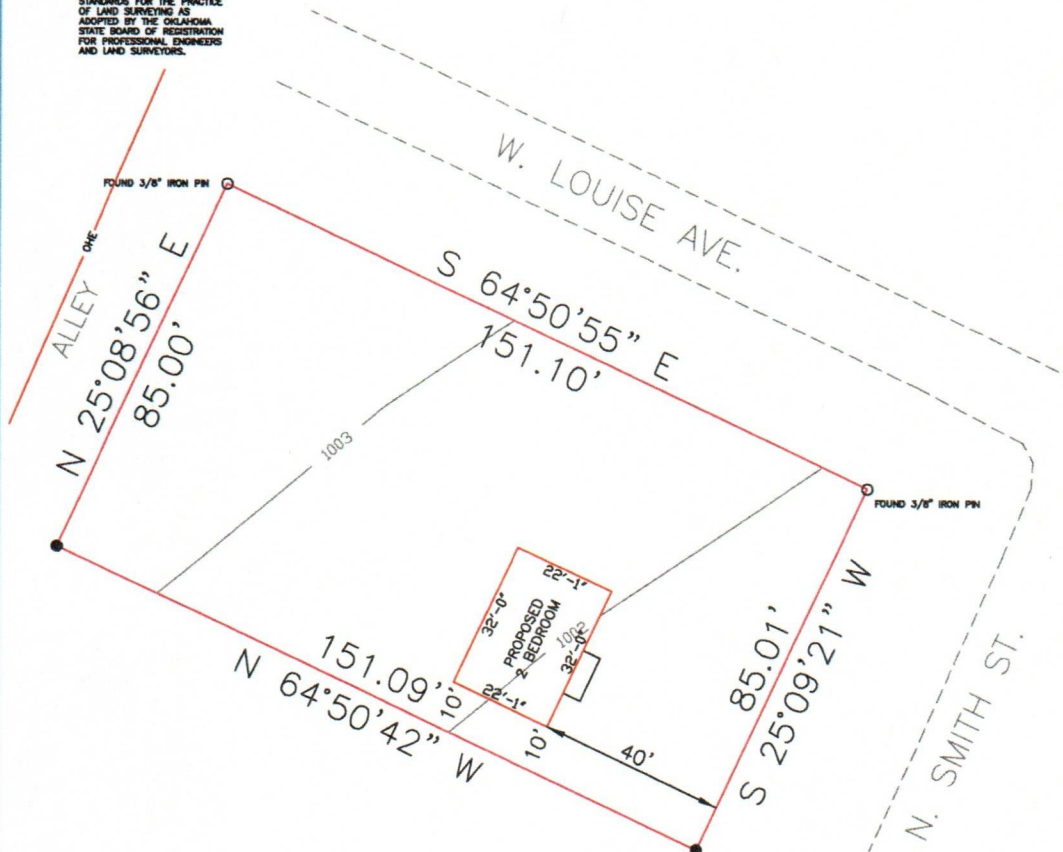

LEGAL DESCRIPTION


Lot 50, 51, and 52 in Block 4 in Cherokee Addition to the City of Vinita, Oklahoma...(DEED), containing 0.3 acres, more or less.

CERTIFICATE

I, DANIEL S. GOSS, A REGISTERED SURVEYOR BY THE STATE OF OKLAHOMA, DO HEREBY CERTIFY THAT THE ABOVE TRACT HAS BEEN SURVEYED UNDER MY DIRECT SUPERVISION. TO THE BEST OF MY KNOWLEDGE, THE ABOVE PLAT IS AN ACURATE REPRESENTATION OF SAID SURVEY. NO UNDERGROUND UTILITIES WERE LOCATED, AND THERE ARE NO BUILDING ENCROACHMENTS THEREON EXCEPT AS INDICATED.

WITNESS MY HAND AND SEAL THIS 1 DAY OF APRIL, 2024

DANIEL S. GOSS P.L.S. NO. 1316, CA NO. 3932...EXP 6/30/26

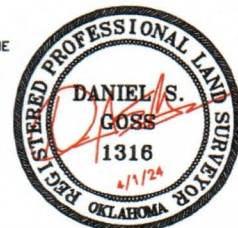

NORTH

D. GOSS & ASSOCIATES

P.O. BOX 216
COLLINSVILLE, OK 74021
PH. (918)371-0096 FAX (918)371-7750

Scale: 1"= 30' DATE: 4/1/2024

HORNBACK DRAWN BY: CJ

JOB # 14308 REVISED:

SITE LAST VISTED: 3/19/2024

HOUSING REHAB
SITE EVALUATION

Name: Bobby Hornback Address: _____

Phone: _____ County: _____

Directions: _____

(CHECK ALL THAT APPLY TO THE SITE)

____ Handicap (yes) or no)

____ Existing Certified Septic System/Drainfield

____ Perc Test or Soil Test (attach)

____ New City Septic System or Aerobic System (Circle One)

____ Survey (attach)

____ Plat (attach)

____ Drill Well

Name City Utilities _____ Rural Utilities _____

Electric Company PSO How far from Site: _____

Gas Company wants total Ele How far from Site _____

RWD Name: City How far from Site same side of road

____ Environmental Report Requested ____ Environmental Issues, noted below

Notes: _____

Attach: _____