



Housing Authority of the Cherokee Nation
1500 Hensley Drive
P.O. Box 1007
Tahlequah, OK 74465-1007
Phone 918-456-5482



Homeowner, #12465 accepts/declines the required specifications for Handicap Assessability, for Housing Program (New Construction or Rehab).

Items Listed:

GRAB BARS AT TOILET:

Accept / Decline

GRAB BARS AT TUB/SHOWER:

Accept / Decline

HIGH RISE TOILET

Accept / Decline

ADA SHOWER W / TRANSFER:

Accept / Decline

ENTRY DOORWAY OF 36":

Accept / Decline

RAMP:

Accept / Decline

WALL HUNG VANITY:

Accept / Decline

VISUALLY IMPAIRED (BLIND)

 Accept/Decline

HEARING IMPAIRED (DEAF)

 Accept/Decline

OTHER

 Accept/Decline

Homeowners agrees and understands the above and NO other changes will be made after this date

15/24

ate:

ate:

HOUSING REHAB
SITE EVALUATION

Name: #12465

Address: 325 NE Katherine Ave
Barthlesville OK 74006

Phone: (918) 332-0222

County: Washington

Directions:

(CHECK ALL THAT APPLY TO THE SITE)

Handicap (yes or no)

Existing Certified Septic System/Drainfield

Perc Test or Soil Test (attach)

New Septic System or Aerobic System (Circle One)

Survey (attach)

Plat (attach)

Drill Well

Name City Utilities Barthlesville Rural Utilities _____

Electric Company PSD How far from Site: _____

Gas Company DWG How far from Site: _____

RWD Name: _____ How far from Site: _____

Environmental Report Requested Environmental Issues, noted below

Notes: No place to move to

Has animals

POD #

Attach:

House plans


Cost Estimator:

Rodney D. Canna

Signature

8/15/2024

Date

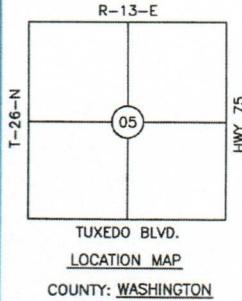

BOUNDARY SURVEY PLOT PLAN & AS-BUILT

PREPARED FOR CHEROKEE NATION HOUSING AUTHORITY
PARTICIPANT: DAVID RAIN
MAILING ADDRESS: 325 NE KATHERINE AVE, BARTLESVILLE, OK
74006
UNIT ADDRESS: SAME AS MAILING
UNIT #12465


BASIS OF BEARINGS:
GEODETIC NORTH

LAT $36^{\circ}45'41.9''N$
LONG $95^{\circ}56'20.8''W$



LEGEND

- = SET IRON PIN
W/ CAP LS1316
- ▲ = SET MAG NAIL
W/ SHAKER LS1316
- = FOUND MONUMENT
- = FENCE
- WM = WATER METER
- PP = POWER POLE
- OHE = OVERHEAD ELECTRIC

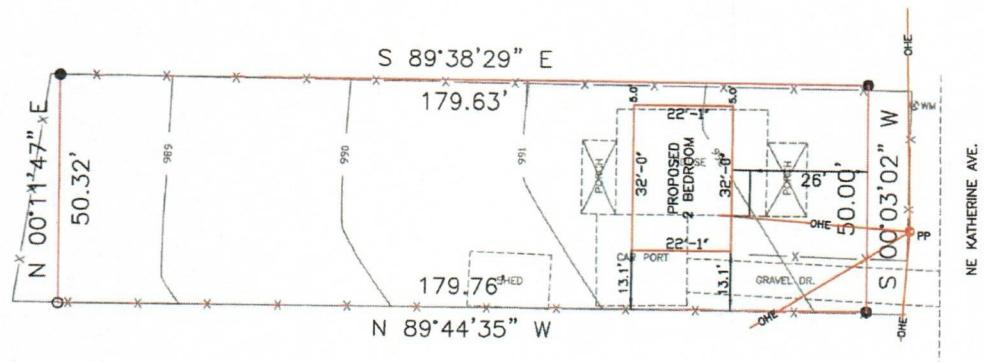

NOTE:
THIS PLAT OF SURVEY MEETS
THE OKLAHOMA MINIMUM
STANDARDS FOR THE PRACTICE
OF LAND SURVEYING AS
ADOPTED BY THE OKLAHOMA
STATE BOARD OF REGISTRATION
FOR PROFESSIONAL ENGINEERS
AND LAND SURVEYORS.

LEGAL DESCRIPTION

Lot Six (6). Block Two (2), Tuxedo Park Addition, Bartlesville, Washington County, OK....(Bk. 968 Pg. 1852)

CERTIFICATE

I, DANIEL S. GOSS, A REGISTERED SURVEYOR BY THE STATE OF OKLAHOMA, DO HEREBY CERTIFY THAT THE ABOVE TRACT HAS BEEN SURVEYED UNDER MY DIRECT SUPERVISION. TO THE BEST OF MY KNOWLEDGE, THE ABOVE PLAT IS AN ACCURATE REPRESENTATION OF SAID SURVEY. NO UNDERGROUND UTILITIES WERE LOCATED, AND THERE ARE NO BUILDING ENCROACHMENTS THEREON EXCEPT AS INDICATED.

WITNESS MY HAND AND SEAL THIS 08 DAY OF MARCH, 2024

DANIEL S. GOSS P.L.S. NO. 1316, CA NO. 3932 (EXP. 06/30/2024)



	D. GOSS & ASSOCIATES 12347 HEYWOOD HILL RD. SAPULPA, OK 74066 PH. 918371-0096 EMAIL: SURVEY@DGOSST-SURVEY.COM WEBSITE: DGOSST-SURVEY.COM	Scale: 1" = 30' RAIN JOB # 14302 SITE LAST VISTED: 03/07/2024	DATE: 03/08/2024 DRAWN BY: CJ REVISED:
---	---	--	--