93					P	ANEL	BOAF	RD	120/240 Single, 1PH, 3 100 A, M.C (8) A				
													` ′
-D\	/EC. HOUSE												RFACE
	/ES: HOUSE ATION: GARAGE											EQUIPMENT GROUN	D BOS
JCA	ATION. GARAGE												
	DESCRIPTION	WIRE	BRKR	PL		A		В	PL	BRKR	WIRE	DESCRIPTION	
1	LIGHITNG GARAGE / MASTER (6)	12	20 A	1	0.89	2.87			2	25 A	10	CU-1	2
3	LIGHTING LIVING AREA (6)	12	20 A	1	0.00	2.07	0.71	2.87	<del>  -</del>			}	4
5	LIGHTING BEDROOMS (6)	12	20 A	1	1.27	1.50			1	15 A	12	GAS FURNACE (6)	6
7	RECEPT KITCHEN (6)	12	20 A	1			0.54		1			SPACE	8
9	RECEPT KITCHEN COUNTER (6)	12	20 A	1	1.50				1			SPACE }	10
11	RECEPT KITCHEN COUNTER(6)	12	20 A	1			1.50	0.10	1	20 A	12	GAS WATER HEATER (6)	12
3	REFRIGERATOR (6)	12	20 A	1	1.08	0.18			1	20 A	12	GAS RANGE (6)	14
5	DISHWASHER / DISPOSAL (6)	12	20 A	1			1.20	1.20	1	20 A	12	GAS DRYER (6)	16
7	RANGE HOOD OR MICROWAVE (6)	12	20 A	1	1.20	2.50			2	30 A	10	FUTURE ELEC DRYER	18
9	RECEPTS DINING ROOM (6)	12	20 A	1			0.54	2.50					20
21	RECEPTS LIVING ROOM (6)	12	20 A	1	0.72	1.50			1	20 A	12	WASHER (6)	22
23	RECEPTS LIVING ROOM (6)	12	20 A	1			0.72	1.20	1	20 A	12	GARAGE DOOR OPENER (6)	24
25	RECEPTS MASTER BDRM (6)	12	20 A	1	0.54	0.90			1	20 A	12	RECEPTS EXTERIOR (6)	26
27	RECEPTS MASTER BDRM (6)	12	20 A	1			0.72	0.54	1	20 A	12	RECEPTS GARAGE (6)	28
29	RECEPT MASTER BATH (6)	12	20 A	1	0.18	0.54			1	20 A	12	RECEPTS GARAGE (6)	30
31	RECEPTS BEDROOM 2 (6)	12	20 A	1			0.90	0.36	1	20 A	12	RECEPTS ENTRY / LAUNDRY (6)	32
33	RECEPT BATHROOM (6)	12	20 A	1	0.18	0.08			1	20 A	12	SMOKE DETECTORS (6)	34
35	RECEPTS BEDROOM 3 (6)	12	20 A	1			1.08	0.21	1	20 A	12	MASTER CLOSET (6)	36
37	SPACE			1		0.00			1	20 A		SPARE (6)	38
39	SPACE			1					1			SPACE	40
41	SPACE			1					1			SPACE	42
		TOTAL	L CONNE	CTED	17	7.62	16	.88	KVA				
		TOTAL	L CONNE	CTED	14	6.87	140	0.65	AMF	PS		SEE RESIDENTIAL LOAD CALCS	

			LIGHTING FIX	TUF	RE S	CHE	EDULE
TYPE	QTY	MANUFACTURER	CATALOG NUMBER	VOLT	WATT	LAMP	DESCRIPTION
Α	12	ELITE	REL637-1200L-DIMTR-120-30K -90-WH	120V	16 VA	LED	6" RECESSED CAN LIGHT, DAMP LOCATION RATED, RT-CL-WH
В	1	GOLDEN	HOMESTEAD 4 LIGHT MINI CHANDELIER	120V	48 VA	LED	DECORATIVE DINING ROOM LIGHT, PROVIDE 100W EQV E26 3000K LED BULBS
D	2	COMMERCIAL	9IN 120W EQU MUSHROOM FLUSH MOUNT	120V	32 VA	LED	9" DOME LIGHT
Е	2	VOGUE	WS-3127-3000K	120V	39 VA	LED	3' VANITY LIGHT
F	4	EELP	CGF7-19L-120V-30K	120V	480 VA	LED	CEILING FAN W/ LIGHT - VEIRIFY COLOR W/ ARCHITECTURAL
G	2	ELITE	4-OED-LED-5000L-DIM10-40K- 85	120V	37 VA	LED	4' GARAGE LIGHT
Н	4	HAMPTON	WICKFORD 1-LIGHT WALL LANTERN	120V	16 VA	LED	WALL MOUNTED PORCH LIGHT, PROVIDE 100W EQV E26 4000K LED BULB
J	2	BROAN	679	120V	240 VA	LED	BATHROOM EXHAUST FAN W/ LIGHT - REF MECHANICAL
				·	·	·	

# PANELBOARD NOTES (#):

- 1. TERMINATE GROUND ON ISOLATED GROUND BUS.
- PROVIDE LOCKING DEVICE (LOCK-OFF FOR MAINTENANCE).
- PROVIDE LOCKING DEVICE (LOCK-ON FOR CRITICAL LOAD). PROVIDE GFCI BREAKER (PERSONNEL PROTECTION 5 mA).
- PROVIDE GFCI BREAKER (EQUIPMENT PROTECTION 30 mA).
- PROVIDE COMBINATION ARC FAULT CIRCUIT BREAKERS WHERE INDICATED PER NEC 210.12(A).
- CONDUCTOR SIZE HAS BEEN INCREADED TO ACCOUNT FOR VOLTAGE DROP. SIZE GROUNDING CONDUCTOR PROPORTIONALLY PER NEC.
- COORDINATE PANELBOARD AIC RATING WITH UTILITY.
- REFERENCE ONE-LINE DIAGRAM FOR WIRE SIZE/QUANTITY.

# TYPICAL MOUNTING HEIGHTS

ALL HEIGHTS ARE FROM FINISHED FLOOR TO THE CENTERLINE OF THE DEVICE UNLESS NOTED OTHERWISE. DEVICES ABOVE A COUNTERTOP SHALL BE MOUNTED 4" ABOVE THE BACKSPLASH TO THE CENTERLINE.

> RECEPTACLES +18" TELEPHONE JACKS +48" DATA JACKS **SWITCHES**

RESIDENTIAL LOAD CALC	JL	ATION
PANELBOARD VOLTAGE DWELLING UNIT AREA	=	240 V 1190 SQFT
GENERAL LIGHTING/POWER (3W/SQFT) SMALL APPLIANCE CIRCUIT (2 CIRCUITS) WASHER (ASSUMED)	= =	3570 VA 3000 VA 1500 VA
DRYER (MINIMUM) REFRIGERATOR (ASSUMED)	=	5000 VA 1080 VA
VENT HOOD / MICROWAVE (ASSUMED) DISHWASHER / DISPOSAL (ASSUMED) GAS RANGE (ASSUMED)	= =	1200 VA 1200 VA 240 VA
GAS WATER HEATER (ASSUMED)	=	100 VA

SUBTOTAL = 16890 VA FIRST 10KVA AT 100% = 10000 VA REMAINDER AT 40% = 2756 VA = 5736 VA CONDENSING UNIT / HEAT PUMP GAS FURNACE (0%) = 1500 VA HVAC LOAD PER NEC 220.82(C) = 5736 VATOTAL FEEDER LOAD PER NEC 220.85 = 18492 VA

# 

REFER TO ARCHITECTURAL ELEVATIONS FOR MOUNTING HEIGHT. MOUNT FIXTURE HORIZONTALLY AND CENTER ABOVE VANITY

**KEYNOTES** 

- SEAL FIXTURE TO CEILING WITH WEATHERPROOF SILICONE PER MANUFACTURERS INSTRUCTION. PROVIDE SHOWER LENS AND TRIM FOR FIXTURE.
- WHERE POSSIBLE, SWITCH INTEGRAL LIGHT AND FAN SEPERATELY.
- DISCONNECT SWITCH SIZED PER MANUFACTURERS MOCP RATING (MAXIMUM OVER-CURRENT PROTECTION PROVIDE CONNECTION OF THERMOSTAT TO FCU USING 18/7
- THERMOSTAT WIRING. COORDINATE WITH MECHANICAL CONTRACTOR FOR FINAL LOCATION PRIOR TO ROUGH-IN. LOCATION OF PUSHBUTTON CONTROLS FOR GARAGE DOOR
- DISHWASHER RECEPTACLE TO BE GFCI TYPE. GARBAGE
- DISPOSAL SWITCH FOR STANDARD RECEPTACLE SHALL BE INTALLED AFTER DISHWASHER RECEPTACLE TO ENSURE SWITCH OPERATION DOES NOT CONFLICT WITH GFCI FUNCTIONALITY.
- RECEPTACLE FOR RANGE HOOD OR OVER THE RANGE MICROWAVE SHALL BE INTALLED IN CABINETRY OVER RANGE.
- COORDINATE ROUTING OF CORD THROUGH MILLWORK IN FIELD. COORDINATE METER CAN LOCATION AND REQUIREMENTS WITH UTILITY PRIOR TO SITE WORK OR ROUGH-IN.
- TRANSFER CENTER WITH MANUAL TRANSFER SWITCH CONTAINING A MINIMUM OF TWO BREAKERS. GENERATOR TWIST LOCK RECEPTACLE LOCATED BELOW. CONNECT LIGHT AND RECEPTACLE IN HARDENED SPACE ON A
- DEDICATED CIRCUIT TO BE ROUTED THROUGH TRANSFER CENTER PRIOR TO LANDING ON ELECTRICAL PANEL.

# **GENERAL NOTES:**

- NOT ALL SYMBOLS MAY APPLY TO ALL SHEETS.
- PROVIDE ALL POWER CIRCUITS, WIRING, CONDUIT, OUTLETS, DISCONNECT SWITCHES, ETC., AND PROVIDE FINAL ELECTRICAL CONNECTIONS TO ALL EQUIPMENT.
- PROVIDE A GROUNDING CONDUCTOR FOR ALL CIRCUITS IN ACCORDANCE WITH N.E.C. ARTICLE 250. VERIFY EXACT CONNECTIONS REQUIRED FOR ALL EQUIPMENT PRIOR TO ROUGH--IN.
- 4. THE USE OF EXTENSION CORDS OR POWER STRIPS AS PERMANENT WIRING TO EQUIPMENT, LIGHTING, FANS, ETC. IS PROHIBITED.
- ALL ELECTRICAL WIRING SHALL BE IN COMPLIANCE WITH THE LATEST ADOPTED EDITION OF THE NATIONAL ELECTRICAL CODE.
- 5. ALL ELECTRICAL DEVICE AND COVER PLATE COLORS TO BE COORDINATED WITH ARCHTIECTURAL FINISH PLANS.
- ALL DEVICES LOCATED WITHIN CLOSE PROXIMITY TO ONE ANOTHER SHALL BE COVERED BY A SINGLE FACE PLATE WHENEVER
- 7. ALL WORK SHALL BE PERFORMED IN STRICT COMPLIANCE WITHT THE LATEST ADOPTED EDITION OF THE NATIONAL ELECTRICAL CODE (NEC), AND ALL APPLICABLE FEDERAL, STATE, AND LOCAL CODES. WHERE CONFLICTS ARISE, THE MOST STRINGENT REQUIREMENTS SHALL TAKE PRECEDENCE.
- BIDDERS SHALL VISIT THE SITE AND FAMILIARIZE THEMSELVES WITH EXISTING CONDITIONS TO FULLY UNDERSTAND THE NATURE AND SCOPE OF THE WORK PRIOR TO SUBMITTING A BID. THE SUBMISSION OF A BID IS CONSIDERED EVIDENCE THAT SUCH EXAMINATION HAS BEEN PERFORMED AND THAT COMPLIANCE WITH ALL GOVERNING CODES/REQUIREMENTS IS INCLUDED IN BID. LATER CLAIMS FOR LABOR, EQUIPMENT, MATERIALS REQUIRED, OR FORESEEABLE DIFFICULTIES ENCOUNTERED SHALL NOT BE ALLOWED. ALL PERMIT AND INSPECTION FEES SHALL BE INCLUDED IN BASE BID.

## GENERAL POWER NOTES:

- PROTECT ALL ADJACENT SURFACES DURING CONSTRUCTION. ANY SURFACES DAMAGED SHALL BE REPAIRED BY THE CONTRACTOR AT NO ADDITIONAL COST TO THE OWNER.
- CONTRACTOR SHALL COORDINATE INSTALLATION OF ELECTRICAL SYSTEMS WITH OTHER TRADES. SEE MECHANICAL AND PLUMBING DRAWINGS FOR EXACT LOCATIONS OF MECHANICAL AND PLUMBING EQUIPMENT.
- PROVIDE A IN-GROUND PULL BOX EVERY 200' FOR ALL UNDERGROUND CONDUIT RUNS.
- WIRING DEVICES: DEVICE MOUNTING HEIGHTS ARE FROM FINISHED FLOOR TO CENTER OF OUTLET BOX UNLESS NOTED OTHER WISE ON PLANS. COORDINATE THE STANDARD MOUNTING HEIGHTS WITH MASONRY. REFERENCE TYPICAL MOUNTING HEIGHT SCHEDULE
- WIRING SHALL INCLUDE FINAL CONNECTIONS TO ALL EQUIPMENT IN CONFORMANCE WITH EQUIPMENT SUPPLIER WIRING DIAGRAMS.
- CONTRACTOR IS RESPONSIBLE FOR PROVIDING COMPLETE PANELBOARD IDENTIFICATION SCHEDULES UPON COMPLETION. WHERE BRANCH CIRCUITS ARE GROUPED, SIZE CONDUITS AND DE-RATE CURRENT CARRYING CONDUCTORS PER NEC.
- PROVIDE APPROPRIATE HANDLE TIES FOR TWO SINGLE POLE CIRCUIT BREAKERS AS REQUIRED WHEN USING MULTI-WIRE BRANCH
- CIRCUITS PER NEC ARTICLE 210.4 PART (B). PROVIDE BLANK FILLERS FOR ALL UNUSED SPACES IN PANELBOARDS WHERE FACTORY KNOCKOUTS HAVE BEEN REMOVED.
- FEEDERS SHALL CONFORM TO NEC 215.2. BRANCH CIRCUITS AND VOLTAGE DROP REQUIREMENTS SHALL CONFORM TO NEC
- 11. ONLY FEEDER CIRCUITS SPECIFICALLY NOTED AS UNDERGROUND ON THE ONE-LINE DIAGRAM AND BRANCH CIRCUITS NOTED BY
- LEGEND SHALL BE INSTALLED UNDER SLAB. ALL OTHER FEEDER AND BRANCH CIRCUITS SHALL BE INSTALLED OVERHEAD WHERE POSSIBLE. ALL SITE CONDUITS SHALL BE INSTALL AT A MINIMUM OF 24" UNDER FINISHED GRADE. 12. HOME RUNS ARE SHOWN SEPARATELY TO PRESERVE DRAWING CLARITY. COMBINE HOME RUNS SERVING LIGHTING AND WIRING
- DEVICES AS ALLOWED BY THE NEC.
- 13. NO EXPOSED CONDUIT OR WIRING IN FINISHED SPACES SHALL BE ALLOWED WITHOUT WRITTEN PERMISSION FROM

# **GENERAL LIGHTING NOTES::**

1 LIGHTING PLAN 1/4" = 1'-0"

- PROVIDE ALL ACCESSORIES REQUIRED FOR FUNCTIONAL ELECTRICAL INSTALLATION AND SUPPORT.
- PROVIDE DRY WALL/PLASTER KIT FOR FIXTURES MOUNTED ON GYPBOARD PER CEILING PLAN.
- LIGHT FIXTURES SHALL BE SUPPORTED IN ACCORDANCE WITH NEC ARTICLE 300; SPECIFICALLY PARAGRAPH 300.11(A).

7. PROVIDE TWO COPIES OF OPERATION AND MAINTENANCE MANUALS FOR ALL LIGHT FIXTURES AND LIGHT CONTROLS.

- COORDINATE EXACT FIXTURE LOCATIONS WITH STRUCTURE, DIFFUSERS, ETC.
- THE LOCATION OF DUCTS, PIPE AND EQUIPMENT AS SHOWN ON THE DRAWINGS IS DIAGRAMMATIC AND SCHEMATIC. IT IS THE RESPONSIBILITY OF OF THE CONTRACTOR TO COORDINATE WITH ALL OTHER TRADES BEFORE INSTALLATION. LIGHT FIXTURE
- REFER TO LIGHT FIXTURE SCHEDULE FOR ALL LIGHT FIXTURES THAT ARE IC RATED. ALL RECESSED FIXTURES SHALL ADHERE TO ARTICLE 410.116 OF THE NATIONAL ELECTRICAL CODE (NEC).

LOCATIONS SUPERSEDE HVAC DUCTWORK, GRILLES AND DIFFUSERS. OFFSET TO AVOID STRUCTURE AND/OR ANY OTHER PIPING.

ELEC.	TRICAL LEGENE
(NO	T ALL SYMBOLS MAY BE USED)
SYMBOL	DESCRIPTION
J	JUNCTION BOX
Φ	RECEPTACLE, 120V DUPLEX
$\Diamond$	RECEPTACLE, 120V GFI DUPLEX
•	RECEPTACLE, 240V SIMPLEX
<del>**</del>	RECEPTACLE, 120V QUADPLEX
	PANELBOARD
	DISCONNECT SWITCH, NON-FUSED
Zh	DISCONNECT SWITCH, FUSED
\$	SWITCH, SINGLE POLE
\$3	SWITCH, 3-WAY
\$4	SWITCH, 4-WAY
\$ <sub>D</sub>	SWITCH, DIMMER
	LIGHT FIXTURE, LINEAR
0	LIGHT FIXTURE, CEILING MOUNTED
Н	LIGHT FIXTURE, WALL MOUNTED
	CIRCUIT,

CIRCUIT, CONCEALED IN SLAB TELEPHONE DATA AND COAXIAL CONNECTION


CONCEALED IN WALLS OR CEILING


UNDER SINGLE FACE PLATE SMOKE / CARBON MONOXIDE

AFF -- ABOVE FINISHED FLOOR WP -- WEATHER PROOF AFCI -- ARC FAULT CIRCUIT INTERUPTING GFCI -- GROUND FAULT CIRCUIT INTERRUPTING AC -- ABOVE COUNTER TR -- TAMPER RESISTANT CF -- CEILING FAN EC -- ELECTRICAL CONTRACTOR

EF -- EXHAUST FAN NTS -- NOT TO SCALE FCU -- FAN COIL UNIT (INDOOR) HP -- HEAT PUMP (OUTDOOR) WH -- WATER HEATER UNO -- UNLESS OTHERWISE NOTED

ABBREVIATIONS:

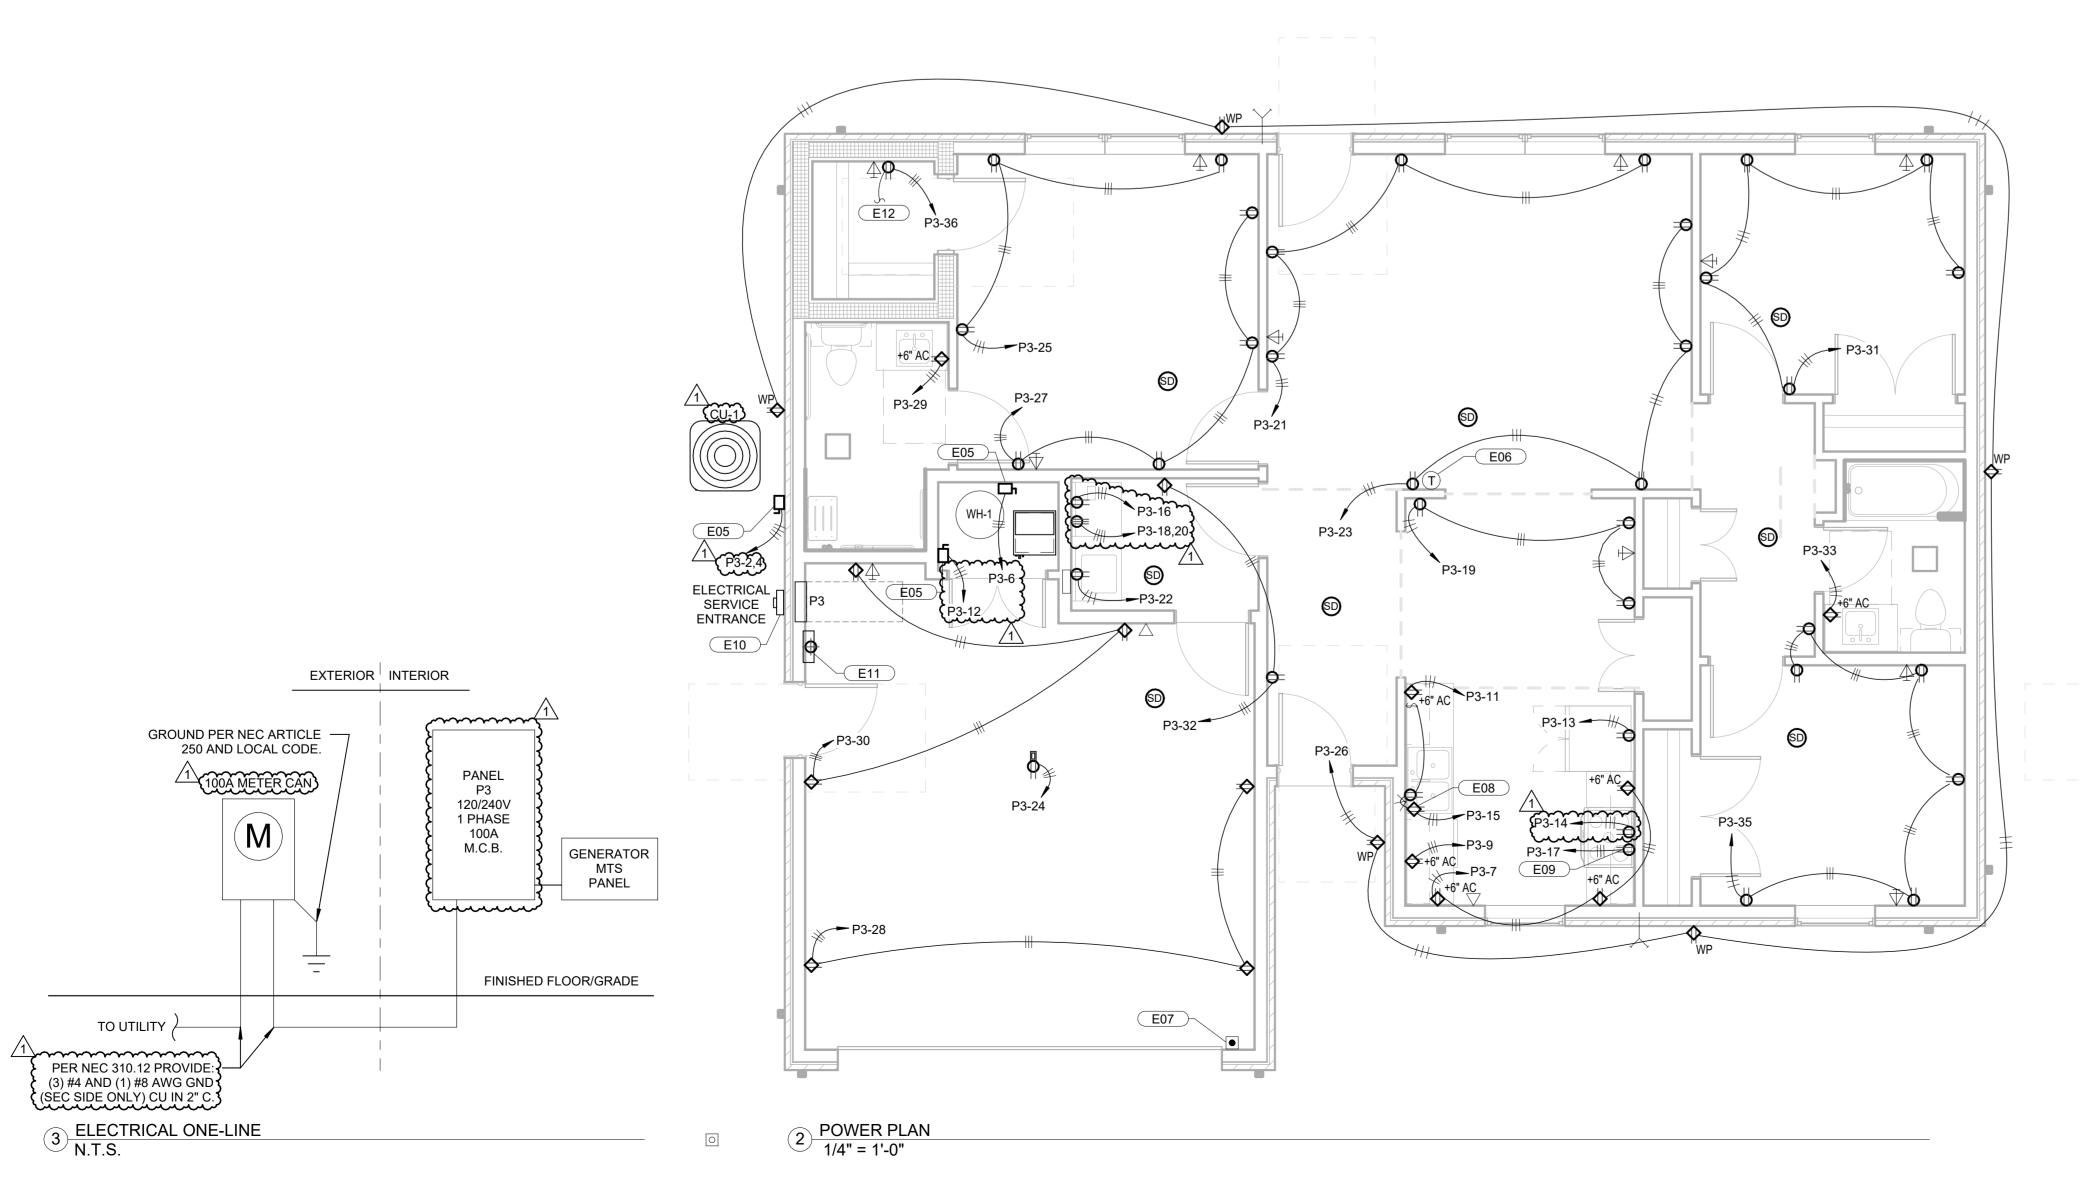

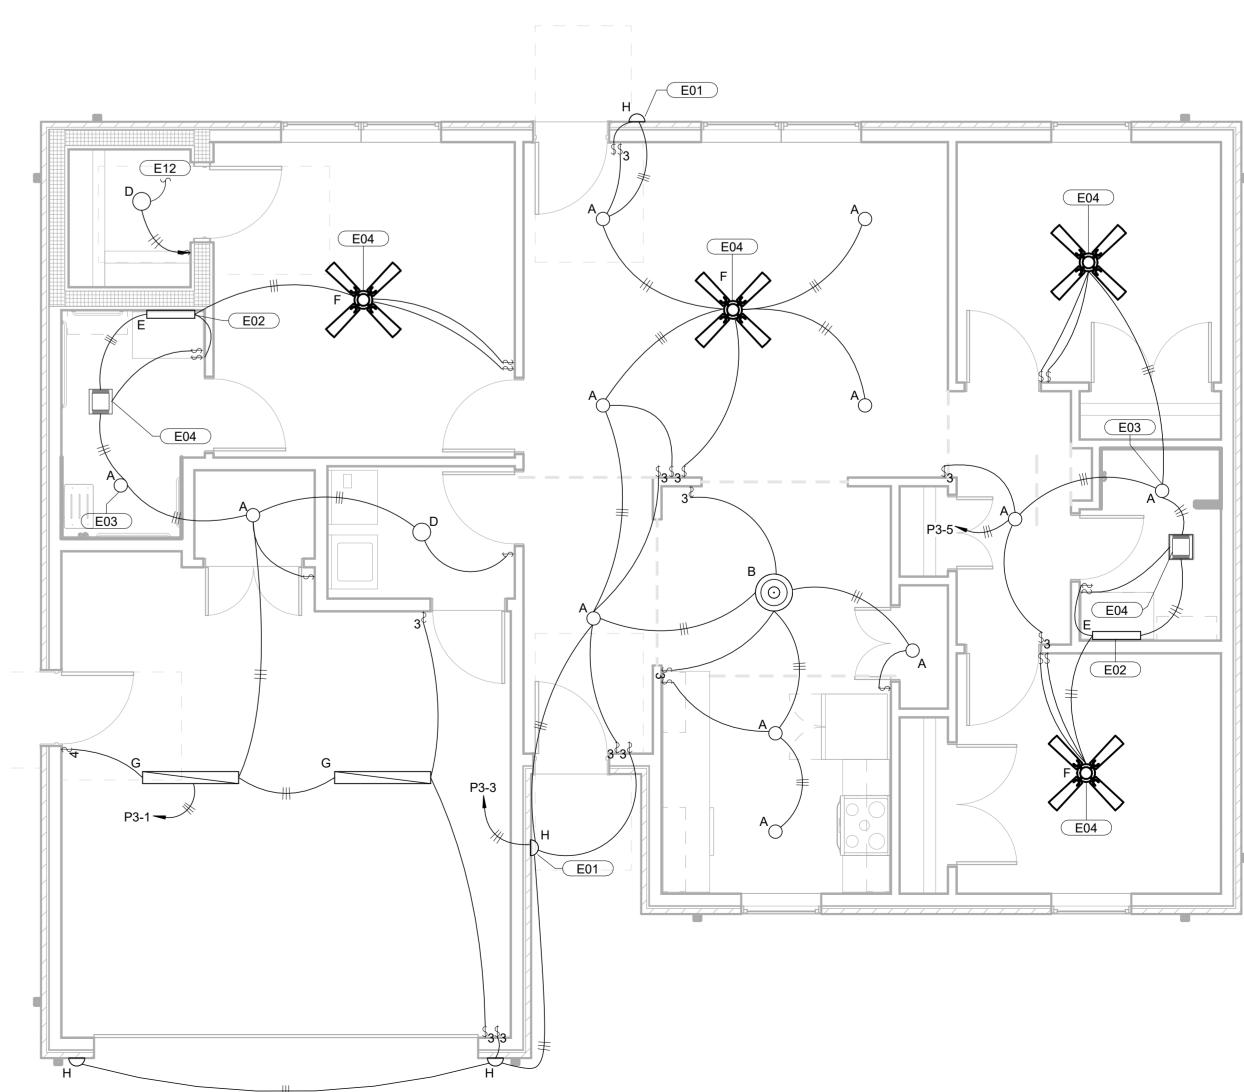

A Native American Owned Firm

Q 0

MPW ENGINEERING, LLC 110 W. 7TH STREET • SUITE 600 TULSA, OK 74119 (918) 582-4088 • FAX (918) 582-4087 OK COA #2940 • EXP 06/30/2022


BLUE RIVER PROJECT NUMBER: 20220104 ISSUE DATE:


08/18/2022 **CONSTRUCTION** 

**DOCUMENTS** OTHER ISSUE DATES: NO. DESCRIPTION ASI#1


SHEET NAME: TYPE 3 **ELECTRICAL PLAN** 

SHEET NUMBER:

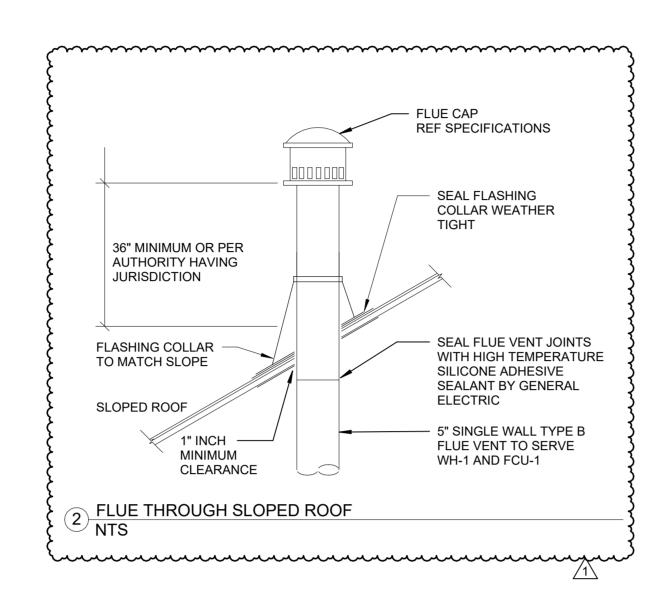

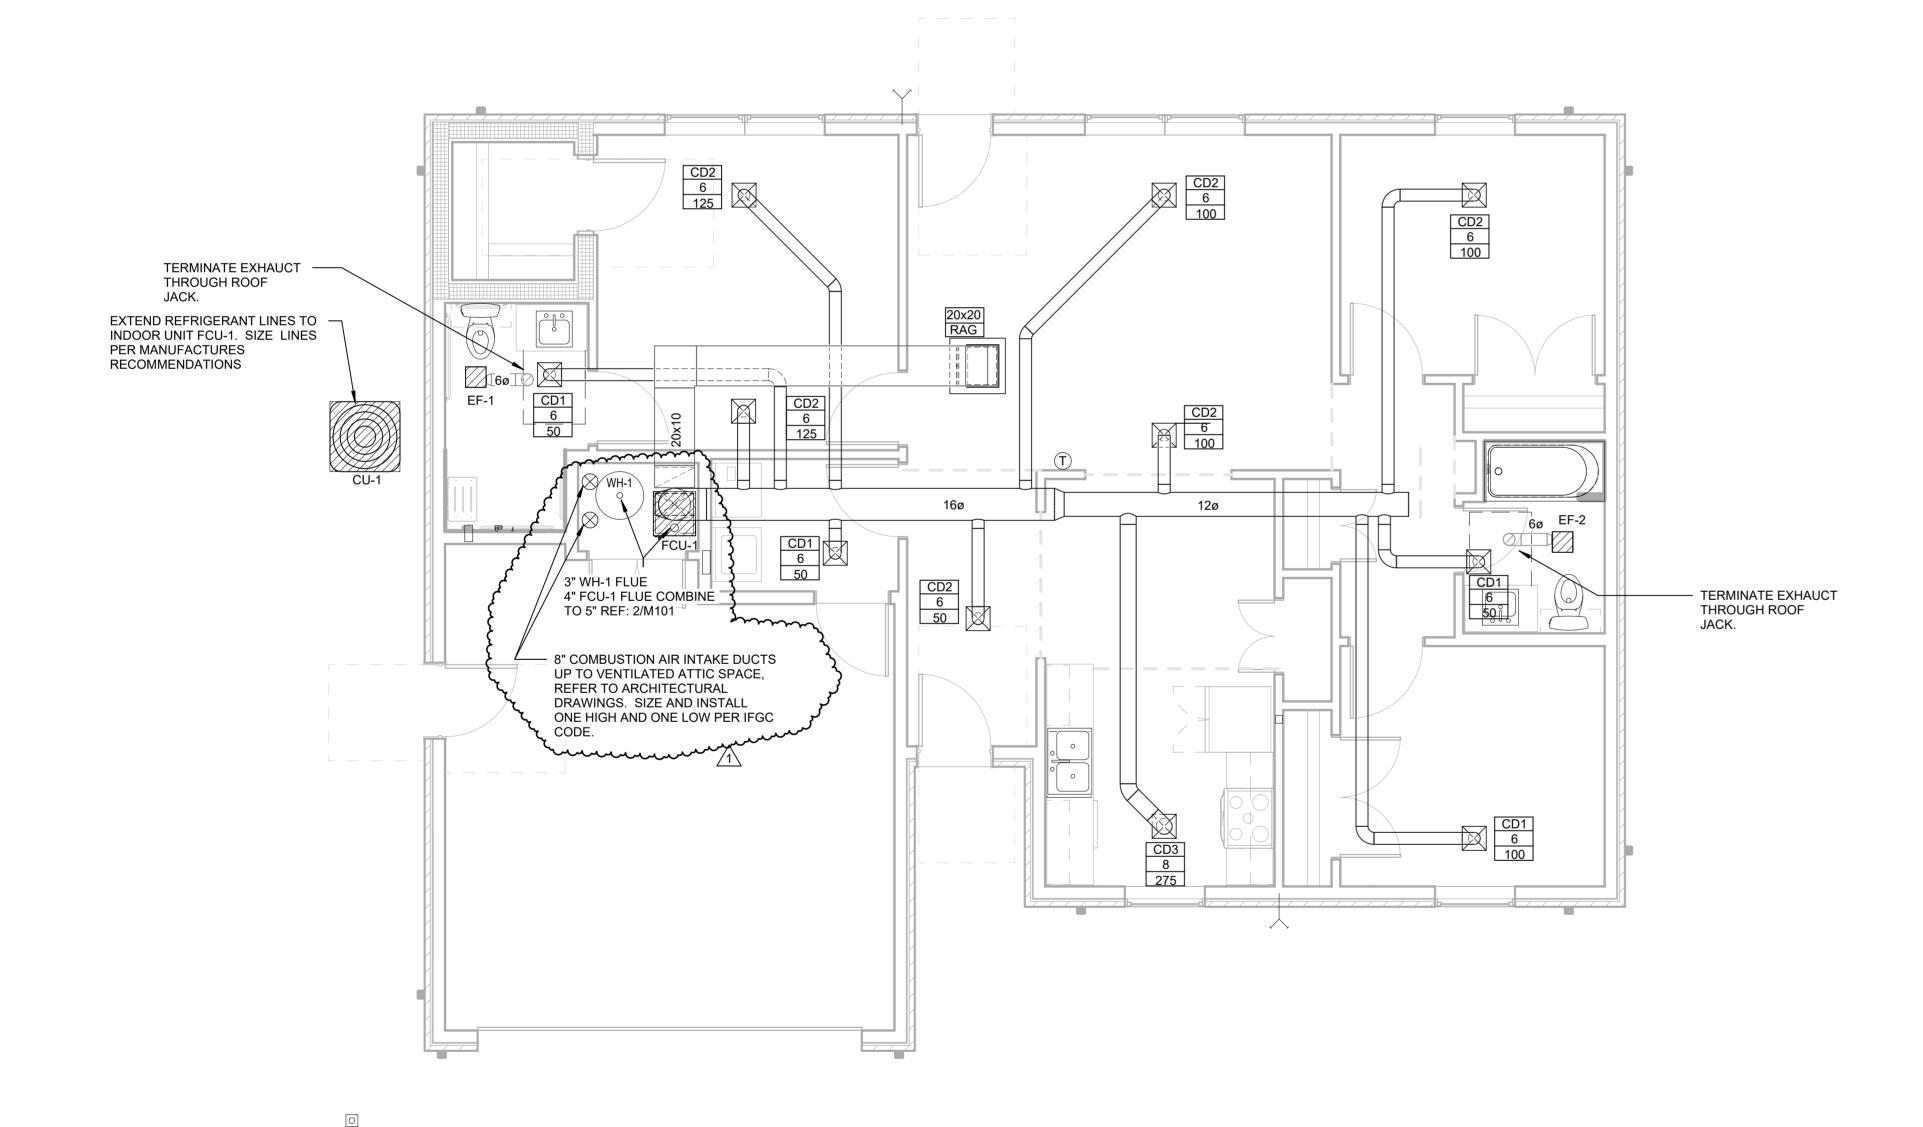

1) FIRST FLOOR HVAC PLAN 1/4" = 1'-0"

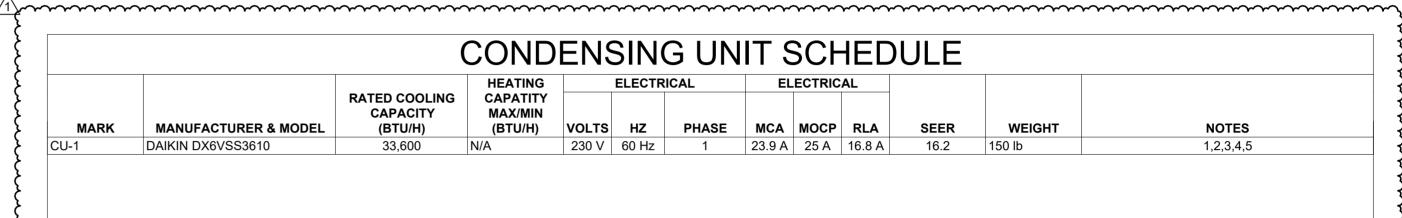

- ALL UNITS SHALL BE SUPPLIED ASCOMPLETE SYSTEMS WITH EXPANSION VALVES (TXV), FILTER-DRYERS, SIGHT GLASS, LOW AMBIENT HEATER, CRANKCASE HEATER AND R410A REFRIGERANT PIPING IN ACCORDANCE WITH MANUFACTURER'S INSTRUCTIONS.
- CONTRACTOR SHALL VERIFY WITH THE UNIT MANUFACTURER THAT REFRIGERANT LINES ARE WITHIN THE RECOMMENDED ALLOWABLE LINE LINGTHS OF RUN AND RISE. CONTACT
- THE ENGINEER IF LINE LENGTHS EXCEED THESE REQUIREMENTS. INSTALL NEW UNITS ON 4" THICK CONCRETE PAD SUITABLE FOR HVAC SYSTEMS. ANCHOR UNIT TO PAD.
- INSTALLING CONTRACTOR SHALL BE CERTIFIED BY THE MANUFACTURER TO BID AND INSTALL THE EQUIPMENT. FIELD INSTALLED DISCONNECT SWITCH BY DIF. 26 ELECTRICAL CONTRACTOR. REFER TO ELECTRICAL DRAWINGS.

					HEATING		EL	ECTRICA	\L		SUPPLY F	AN		
MARK	MANUFACTURER	MODEL#	S/A CFM	ESP	OUTPUT CAPACITY (BTU/H)	v	Hz	PHASE	MCA	МОСР	MOTOR HP	FLA	CONFIG	NOTES
FCU-1	DAIKIN	DC80TN0804BN	1200	0.5	64,000	115 V	60 Hz	1	12 A	15 A	0.75	5 A	VERTICAL	1,2,3,4
EXTE PROV	ALL REFRIGERANT LINE IND CONDENSATE DRA /IDE MANUFACTURER F /IDE DAIKIN CASED COI	IN PIPING TO NEARES RECOMMENDED 7 DAY	FLOOR DRA	AIN WITH C MABLE TH	ODE APPROVE ERMOSTAT.		ΔP.							

								ELE	CTRICAL	•		
MARK	MANUFACTURER & MODEL	LOCATION	MOUNTING	CFM	ESP	SONES	V	Р	Hz	WATTS	SPEEDS	REMARKS
EF-1	BROAN 679	BATHROOM	CEILING	70	0.1	3.5	120 V	1	60 Hz	240 W	1	A, B,C,E
EF-2	BROAN 679	BATHROOM	CEILING	70	0.1	3.5	120 V	1	60 Hz	240 W	1	A, B,C,E
REFEI INSTA	R TO DIVISION 23 SPACIFICATION R TO SPECIFICATIONS FOR ACCI LL FAN SYSTEM COMPLETE PER	EPTABLE ALTERNATE MANUFA R MANUFACTURER'S INSTRUCT	IONS.			2014						
REFER INSTA	R TO SPECIFICATIONS FOR ACC	EPTABLE ALTERNATE MANUFA R MANUFACTURER'S INSTRUCT DORDINATE FAN OPERATION A	TIONS. IND RELAYS REQUIF									

				AIR DE'	VICE S	CHEL	ULE				
MARK	MANUFACTURER & MODEL#	SERVICE	MATERIAL	FACE TYPE	MOUNTING LOCATION	FACE SIZE	NECKSIZE	NOISE CRITERIA (NC)	NUMBER OF SLOTS	SLOT INCHES	NOTES
CD1	TITUS TMS	SUPPLY AIR	ALUMINUM	ROUND NECK	SURFACE	12"X12"	6	25			1,3,4,6,7
CD2	TITUS TMS	SUPPLY AIR	STEEL	ROUND NECK	SURFACE	12"X12"	6	25			1,3,4,6,7
CD3	TITUS TMS	SUPPLY AIR	STEEL	ROUND NECK	SURFACE	12"X12"	8	25			1,3,4,6,7
RAG	TITUS 350RLF1	RETURN AIR	STEEL	SQUARE NECK	SURFACE	24X24	20	25			1,3,6,7,8

- COORDINATE FRAME TPYE WITH CEILING MATERIALS. DUCT MOUNT WHERE SPIRAL DUCTWORK EXPOSED. NOT ALL GRILLE AND DIFFUSERS SHOWN ARE NECESSARILY USED, REFER TO HVAC PLAN FOR LOCATION AND QUANTITY.
- FOR SURFACE MOUNTED LAY-IN TYPE DIFFUSERS OR GRILLES PROVIDE TRIM RINGS. REFER TO ARCHITECTURAL DRAWINGS AND COORDINATE CEILING TYPES WITH AIR

FAN CONTROLLED BY WALL SWITCH. REFER TO ELECTRICAL DRAWINGS FOR LOCATION BY BAR. PROVIDE LABEL FOR SWITCH ON SWITCH PLATE.

- WHERE BACK PAN OF DIFFUSER IS EXPOSED TO NON-CONDITIONED ATTIC TYPE SPACES, PROVIDE FACTORY R-6 FOIL BACKED INSULATION TO MINIMIZE CONDENSATION. COORDINATE LOCATION OF GRILLES, REGISTERS AND DIFFUSERS WITH CEILING GRID, LIGHT LOCATIONS, STRUCTURAL MEMBERS AND ARCHITECTURAL FEATURES.
- FINAL FINISH OF ALL AIR DEVICES SHALL BE VERIFIED WITH ARCHITECT'S FINISH AND PAINTING SCHEDULE. ACCEPTABLE ALTERNATE MANUFACTURERS: HART & COOLEY, TRUAIRE, ANEMOSTAT, AND METALAIRE. PROVIDE 1 INCH THICK 20X20 FILTER.

FLEXIBLE CONNECTIONS AT DISCHARGE DUCT CONNECTIONS TO MINIMIZE VIBRATION.

A Native American Owned Firm



HOUSING

110 W. 7TH STREET • SUITE 600 TULSA, OK 74119

(918) 582-4088 • FAX (918) 582-4087

OK COA #2940 • EXP 06/30/2022 BLUE RIVER PROJECT NUMBER:

20220104 ISSUE DATE: 08/18/2022

CONSTRUCTION **DOCUMENTS** 

ASI#1

TYPE 3 HVAC PLAN AND **SCHEDULES** 

SHEET NUMBER:

## **ABBREVIATIONS** K KW KILOWATT ABV ABOVE ACCU | AIR COOLED CONDENSING UNIT LAB LAT LAV LABORATORY ACETYLENE GAS LEAVING AIR TEMPERATURE AIR CONDITIONING UNIT LAVATORY ACCESS DOOR LINEAR DIFFUSER AIR FILTER LDB LF ABOVE FINISHED FLOOR LEAVING DRY BULB AFH AIR FILTER, HIGH EFFICIENCY LINEAR FEET LFD LAMINAR FLOW DIFFUSER AIR HANDLING UNIT AIR PRESSURE DROP LP LIQUID PROPANE AR ACID RESISTANT L/S LITERS PER SECOND LWB LWT ASSY | ASSEMBLY LEAVING WET BULB LEAVING WATER TEMPERATURE AUX AUXILIARY AV AUTOMATIC AIR VENT M MAU MAX MAKE-UP AIR UNIT MAXIMUM BACKDRAFT DAMPER B BDD MIXING BOX/MOP BASIN MB BRAKE HORSE POWER THOUSAND BTU/HR BACKFLOW PREVENTER MOTORIZED DAMPER BIRD SCREEN MECH MECHANICAL MIN MM MS MINUTE/MINIMUM CONDENSATE MILLIMETERS MOTOR STARTER CENTER LINE CEILING DIFFUSER CFM CUBIC FEET PER MINUTE N N NITROGEN CHILLER NORMALLY CLOSED CHDR | CHEMICAL DRAIN NATURAL GAS CHP CHILLED WATER PUMP CLG CEILING NIC NO NOX NTS NOT IN CONTRACT NUMBER CLEANOUT NITROGEN OXIDE CONC CONCRETE NOT TO SCALE CONN | CONNECTION CONT | CONTINUED/CONTINUATION/CONTINUOUS | OXYGEN COTG | CLEAN OUT TO GRADE **OUTSIDE AIR** CONDENSING UNIT/COPPER OAL OBD OC OUTSIDE AIR LOUVER CONSTANT VOLUME OPPOSED BLADE DAMPER **COLD WATER** ON CENTER **OVERFLOW SCUPPER** DIRECT DIGITAL CONTROL DOOR GRILLE OUTSIDE SCREW & YOKE DIAMETER P PD PRESSURE DROP DIMENSION DMPR DAMPER POC POINT OF CONNECTION PRESS PRESSURE DOWN PRV PSIG PVC PRESSURE REDUCING VALVE DIFFERENTIAL PRESSURE SWITCH DPS POUNDS PER SQUARE INCH DRAIN DUCT SMOKE DETECTOR POLYVINYL CHLORIDE DSW DISTILLED WATER R RA RETURN AIR DWG DRAWING RETURN AIR GRILLE E EAT ENTERING AIR TEMPERATURE RETURN AIR REGISTER EQUIPMENT DRAIN RAIN CONDUCTOR ENTERING DRY BULB RD REF **ROOF DRAIN** ENERGY EFFICIENCY RATIO REFERENCE EER EXHAUST FAN RETURN FAN | EFFICIENCY RAIN LEADER EXHAUST GRILLE RM ROOM ELEVATION RTN RETURN ELEC | ELECTRICAL ENTERING ER EXHAUST REGISTER SUPPLY AIR GRILLE SAN SAR SANITARY EWB | ENTERING WET BULB ELECTRIC WATER COOLER SUPPLY AIR REGISTER ENTERING WATER TEMPERATURE SMOKE DAMPER SD/FD COMB. SMOKE DAMPER\FIRE DAMP. EXH EXHAUST EWS EYE WASH/SHOWER STATION STATIC PRESSURE F FCO FLOOR CLEANOUT SQUARE FEET FD FIRE DAMPER/FLOOR DRAIN STAINLESS STEEL FUME HOOD TCU TEMP TERMINAL CONTROL UNIT FLEX | FLEXIBLE TEMPERATURE FOR FUEL OIL RETURN TRANSFER GRILLE FUEL OIL SUPPLY TRAP PRIMER TYP TYPICAL FINS PER INCH FPM FEET PER MINUTE UNDERCUT U UC FACE VELOCITY VARIABLE AIR VOLUME **VOLUME DAMPER** VD **GRAVITY INTAKE VENTILATOR** VEL VERT VFD VSD VTR VELOCITY GROUND GALLONS PER MINUTE VARIABLE FREQUENCY DRIVE GRAVITY RELIEF VENTILATOR VARIABLE SPEED DRIVE **VENT THRU ROOF** H HB HOSE BIBB HORIZ HORIZONTAL W W/ WITH HP HORSE POWER/HEAT PUMP WITHOUT HTG HEATING WCO WALL CLEANOUT HUMID HUMIDISTAT WATER COLUMN HWS HOT WATER SUPPLY WALL HYDRANT HWB HOT WATER BOILER WHA WATER HAMMER ARRESTORS HWP HOT WATER PUMP WR WATER RISER HWR HOT WATER RETURN WTR WATER ID INSIDE DIAMETER INCHES INV EL INVERT ELEVATION

**DOMESTIC WATER GENERAL NOTES** 

1. CUTOFF VALVES AND STOPS SHALL BE PROVIDED WHERE SHOWN ON DRAWINGS AND AT FIXTURE CONNECTIONS.

2. TEST ALL WATER SYSTEM IN PRESENCE OF OWNER'S REPRESENTATIVE AT MIN. 100 PSIG FOR 8 HOURS. SANITARY, WASTES, AND VENTS SHALL BE TESTED WITH 10' HEAD OF WATER FOR 8 HOURS WITH LEVEL OF WATER REMAIN UNCHANGED.

3. INSTALL ALL EQUIPMENT AND MATERIALS IN ACCORDANCE WITH MANUFACTURERS INSTRUCTIONS AND RECOMMENDATIONS.

4. INSTALL ALL WATER PIPING SYSTEMS SO THAT THEY WILL

NOT BE SUBJECT TO ANY UNDUE STRAINS OR STRESSES. PROVISIONS SHALL BE MADE FOR EXPANSION. CONTRACTION AND STRUCTURAL SETTLEMENT.

5. ALL PENETRATIONS THROUGH FIRE RATED WALLS AND FLOOR CEILING ASSEMBLY SHALL BE INSTALLED AND SEALED TO MAINTAIN FIRE RATING WITH U.L. LISTED ASSEMBLIES, MATERIALS AND SEALANTS.

6. BELOW GROUND PIPE SHALL BE INSTALLED NO LESS THAN 6" BELOW FROST LINE. REFER TO STRUCTURAL DETAILS FOR FOUNDATION PENETRATION.

7. DRAWING IS DIAGRAMMATIC IN NATURE AND IS NOT INTENDED TO BE SCALED FOR DIMENSIONS.

8. COORDINATE LOCATION OF PLUMBING WORK WITH OTHER TRADES TO AVOID CONFLICTS AND INTERFERENCES.

9. ALL TESTING IS THE RESPONSIBILITY OF THE CONTRACTOR, WITHOUT EXTRA COST FOR THE OWNER.

10. CONTRACTOR SHALL BE RESPONSIBLE FOR PROVIDING A WATER FLOW AND PRESSURE TEST FOR EVALUATING INCOMING DOMESTIC AND FIRE PROTECTION SERVICE PRESSURES.

11. WHERE STREET WATER MAIN PRESSURES FLUCTUATE, THE BUILDING WATER DISTRIBUTION SYSTEM SHALL BE DESIGNED FOR MINIMUM PRESSURE AVAILABLE. WHEREVER WATER PRESSURE FROM THE STREET MAIN OR OTHER SOURCE OF SUPPLY IS LESS THAN 60 PSI, A WATER PRESSURE BOOSTER SYSTEM SHALL BE INSTALLED ON THE BUILDING WATER SUPPLY SYSTEM. WHERE WATER PRESSURE WITHIN A BUILDING EXCEEDS 80 PSI STATIC, AN APPROVED WATER-PRESSURE REDUCING VALVE WITH STRAINER CONFORMING TO ASSE 1003 SHALL BE INSTALLED TO REDUCE THE PRESSURES TO BELOW 80 PSI.

# PIPE LINES

POTABLE COLD WATER ——— — POTABLE HOT WATER —— — — POTABLE HOT WATER RETURN \_\_ \_\_ VENT

# PIPE TAGS

POTABLE COLD WATER POTABLE HOT WATER XX" HWR POTABLE HOT WATER RETURN XX" V COMPRESSED AIR SANITARY SEWER OIL\WASTE WATER NATURAL GAS

VENT THROUGH ROOF

SANITARY SEWER GENERAL NOTES

1. PROVIDE CLEANOUTS AT LOCATIONS AND WITH CLEARANCES AS REQUIRED BY THE CODE NOT EXCEEDING 50 FEET IN HORIZONTAL RUNS AT EACH CHANGE OF DIRECTION, VERTICAL OR HORIZONTAL, GREATER THAN 45°, AT THE BASE OF EACH WASTE OR VENT STACK 5 FEET AFF. PROVIDE WALL CLEANOUTS IN LIEU OF FLOOR CLEANOUTS WHEREVER POSSIBLE. ALL INTERIOR CLEANOUTS SHALL BE ACCESSIBLE FROM WALLS OR

2. THE FLOOR DRAIN IN TOILETS AND MECHANICAL ROOMS SHALL BE PROVIDED WITH BACKWATER VALVES.


3. MAINTAIN MINIMUM OF 10 FEET CLEARANCE BETWEEN ANY VTR AND OUTSIDE AIR INTAKES. WHERE HORIZONTAL CLEARANCE CANNOT BE PROVIDED, EXTEND VENTS A MIN OF 24" ABOVE EACH OUTSIDE AIR INTAKE.

4. VTR'S ROOF PENETRATIONS, WATER PROOFING AND FLASHINGS SHALL BE PROVIDED BY ROOF CONTRACTOR.

5. ALL TESTING IS THE RESPONSIBILITY OF THE CONTRACTOR. TEST ALL SEWER AND VENT SYSTEMS IN PRESENCE OF OWNER'S REPRESENTATIVE. 6. INVERT ELEVATION SHOWN BASED ON 100.0 FT. FF ELEVATION, REFER TO CIVIL DRAWINGS FOR ACTUAL

7. SEWER PIPE SHALL BE INSTALLED NO LESS THAN 6" BELOW THE FROST LINE.

THIS IS A STANDARD SYMBOLS & ABBREVIATIONS SHEET. THEREFORE, SOME SYMBOLS & ABBREVIATIONS MAY APPEAR ON THIS SHEET AND NOT ON THE PLANS.

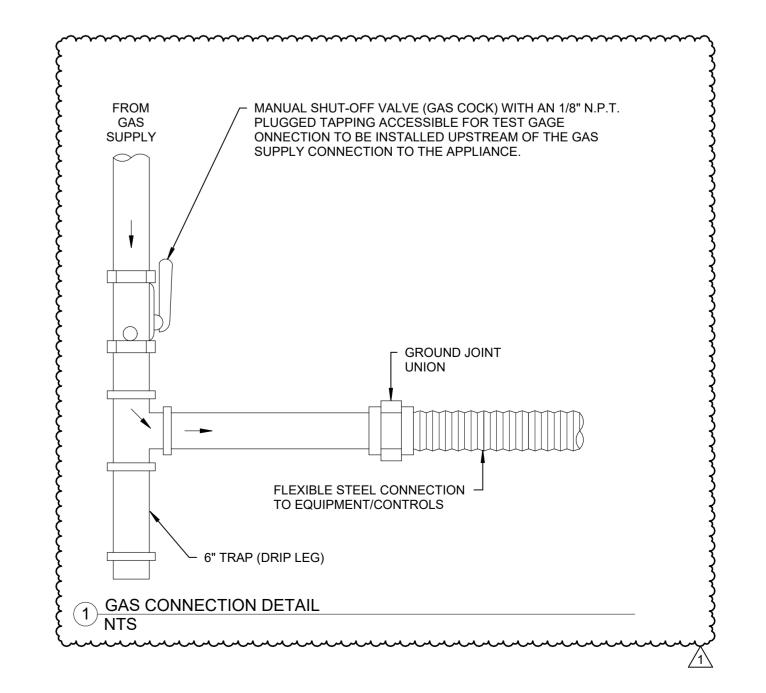





Q 0

0

MPW ENGINEERING, LLC 110 W. 7TH STREET • SUITE 600

TULSA, OK 74119 (918) 582-4088 • FAX (918) 582-4087

OK COA #2940 • EXP 06/30/2022 BLUE RIVER PROJECT NUMBER: 20220104


ISSUE DATE: 08/18/2022

CONSTRUCTION **DOCUMENTS** 

OTHER ISSUE DATES: NO. DESCRIPTION 1 ASI#1


> **PLUMBING NOTES** AND DETAILS


SHEET NUMBER:

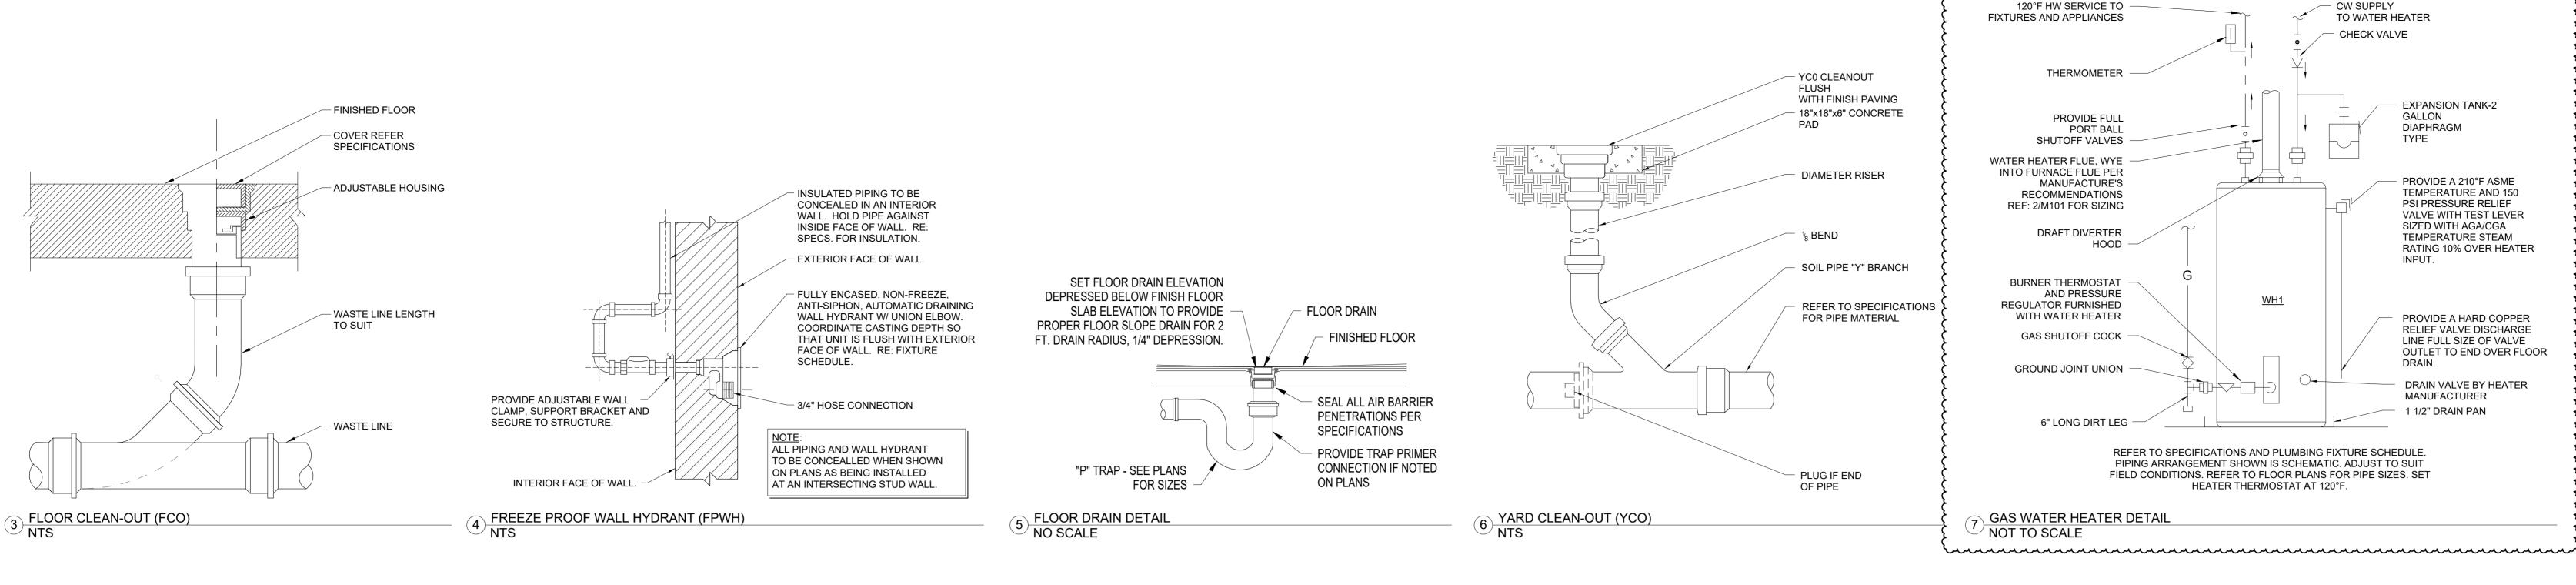

			BRA	ANCH SIZES (MIN	)				
MARK	UNIT TYPE	WASTE	VENT	CW		HW	MANUFACTURER & MODEL	FAUCET/TRIM	DESCRIPTION
BT-1	SHOWER VALVE	0"	0"	1/2"	1/2"		AMERICAN STANDARD RU102SS	T385.502 RELIANT 3 BATH/SHOWER TRIM	FLASH ROUGH VALVE BODY
FD-1	FLOOR DRAIN	2"	1 1/2"				JAY R. SMITH 2005B		FLOOR DRAIN SQUARE
FPWH-1	WALL HYDRANT			1/2"			WOOFORD B67		FREESELESS WALL HYDRANT
IMB-1	ICE MAKER BOX	0"	0"	1/2"	0"		SIOUX CHIEF 696-G1010MF		DOUBLE HOSE BIBB OUTLET CONNECTION OUTLET BOX WITH DRAIN BOX
KS-1	KITCHEN SINK	2"	1 1/2"	1/2"	1/2"		AMERICAN STANDARD 22DB.6332283C.075.50/5	AMERICAN STANDARD 4175.300.F15	COLONY 33 x 22 ADA DOUBLE BOWL STAINLESS STEEL KITCHEN SINK KIT
LAV-1	DROP IN	2"	1 1/2"	1/2"	1/2"		AMERICAN STANDARD 0476.028.020	AMERICAN STANDARD 7075.050	AQUALYN DROP IN SINK VITREOUS CHINA
SD-1	SHOWER DRAIN	2"	1 1/2"				JAY R. SMITH 216		
SH-1	SHOWER VALVE	0"	0"	1/2"	1/2"		AMERICAN STANDARD RU102SS	TU662SG.211SHOWER TRIM	FLASH ROUGH VALVE BODY
WB-1	WASHER WALL BOX	2"	1 1/2"	1/2"	1/2"		SIOUX CHIEF696 series		1/4" COMPRESSION OUTLET CONNECTION OUTLET BOX 1/4" COMPRESSION OUTLET CONNECTIONOUTLET BOX WITH DRAIN BOX
WC-1	TANK TYPE RIGHT FLUSH	3"	2"	3/4"			AMERICAN STANDARD 211AA.004		COMPLETE TOILET WITH ANK AND SEAT HYDRAPRO MODEL HPWPTSESC
3"YCO	YARD CLEAN-OUT	3"					ZURN ZI449		CAST IRON FERRULE AND PLUG, DURA-COATED CAST IRON, DOUBLE-FLANGED HOUSING, AND EXTRA HEAVY DUTY SCORIATED CAS' IRON COVER WITH LIFTING DEVICE, VANDAL-PROOF SCREWS.
4" YCO	YARD CLEAN-OUT	4"					ZURN ZI449		CAST IRON FERRULE AND PLUG, DURA-COATED CAST IRON, DOUBLE-FLANGED HOUSING, AND EXTRA HEAVY DUTY SCORIATED CAS
NOTES:									IRON COVER WITH LIFTING DEVICE, VANDAL-PROOF SCREWS.

{			GAS I		HEATER SO					
MARK	SERVICE	MANUFACTURER & MODEL	TANK VOLUME	МВН	RECOVERY GPH @ 90 RISE	VOLTAGE	FREQUENCY	PHASE	WEIGHT	NOTI
WH-1	HOT WATER	AM STD GSN50T1-3-6,	50.0 gal	40	38	120 V	60 Hz	1	185 lb	1,3,4
		HEATER INSTALL PER MANUFACT TION PUMP AS REQUIRED PER CO		o, o	222322 0/11 211 2211					

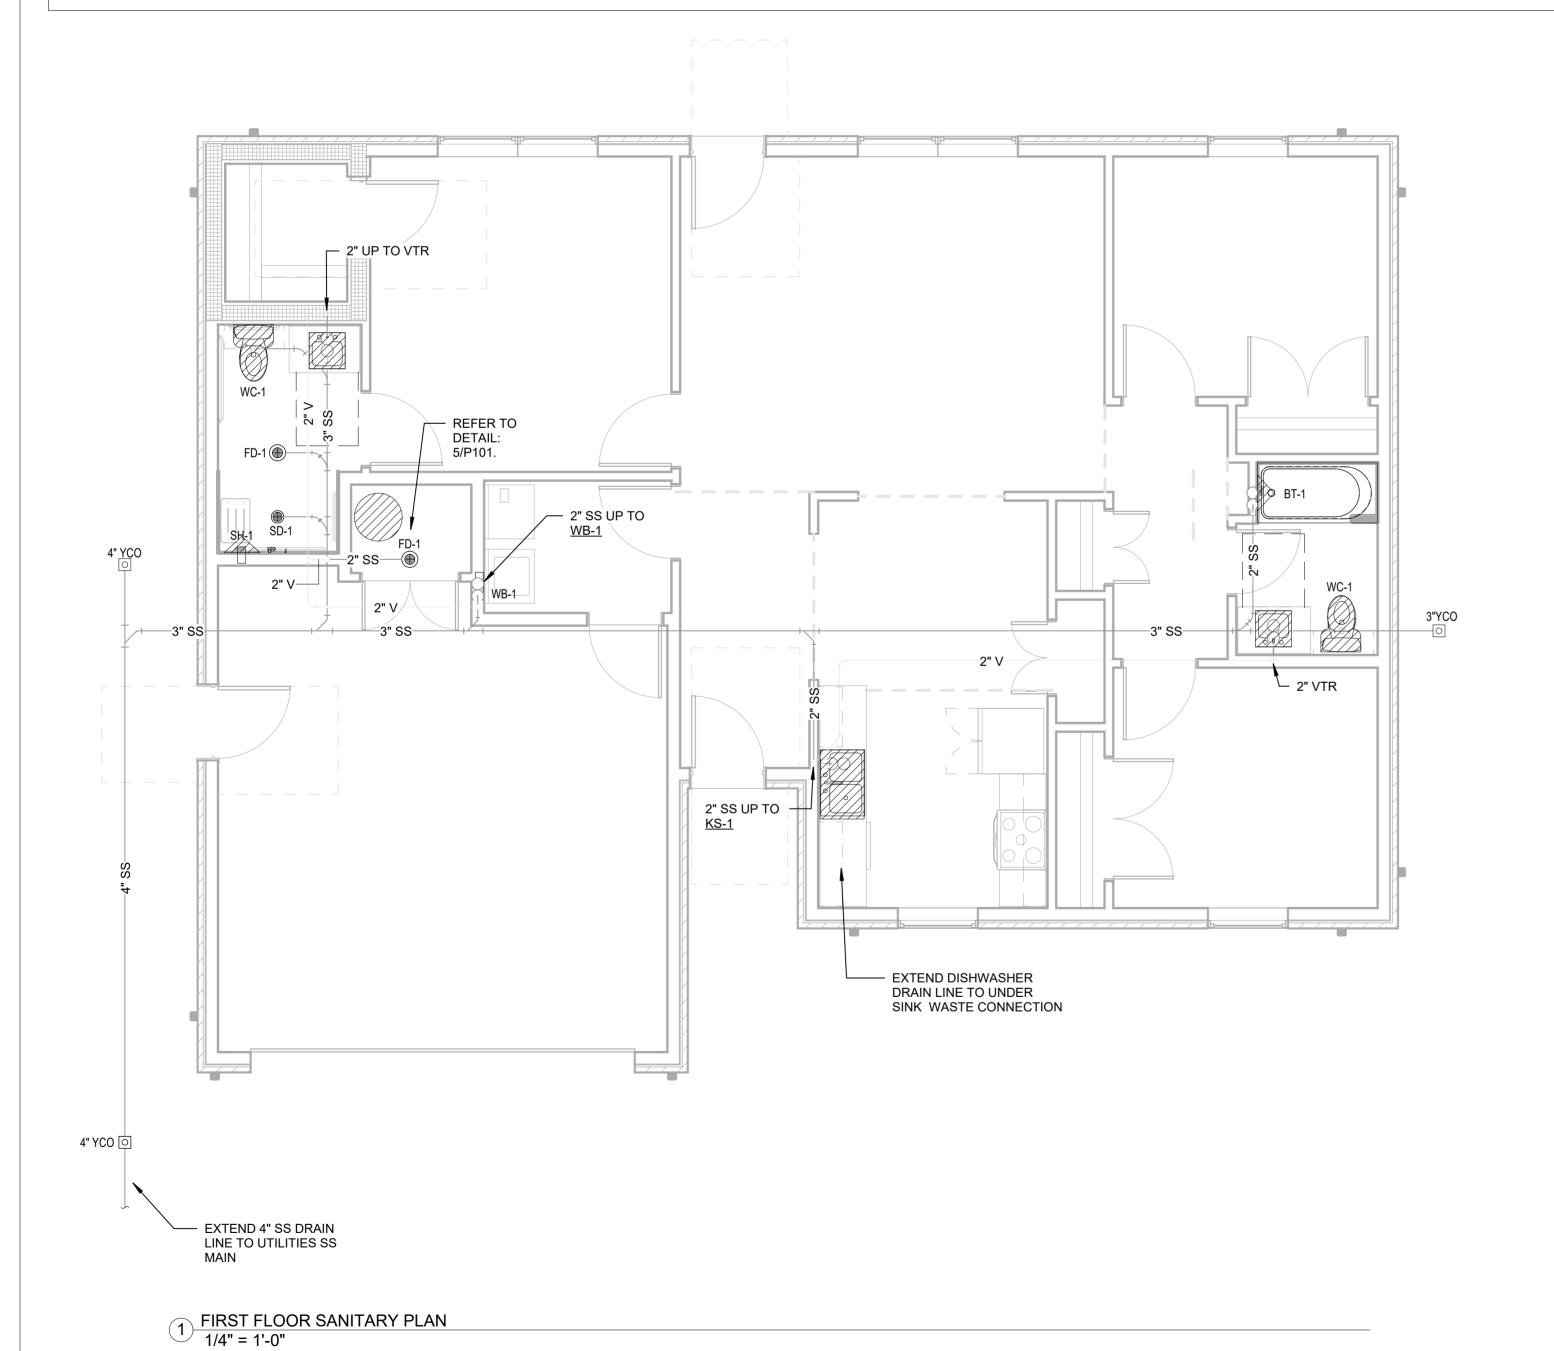

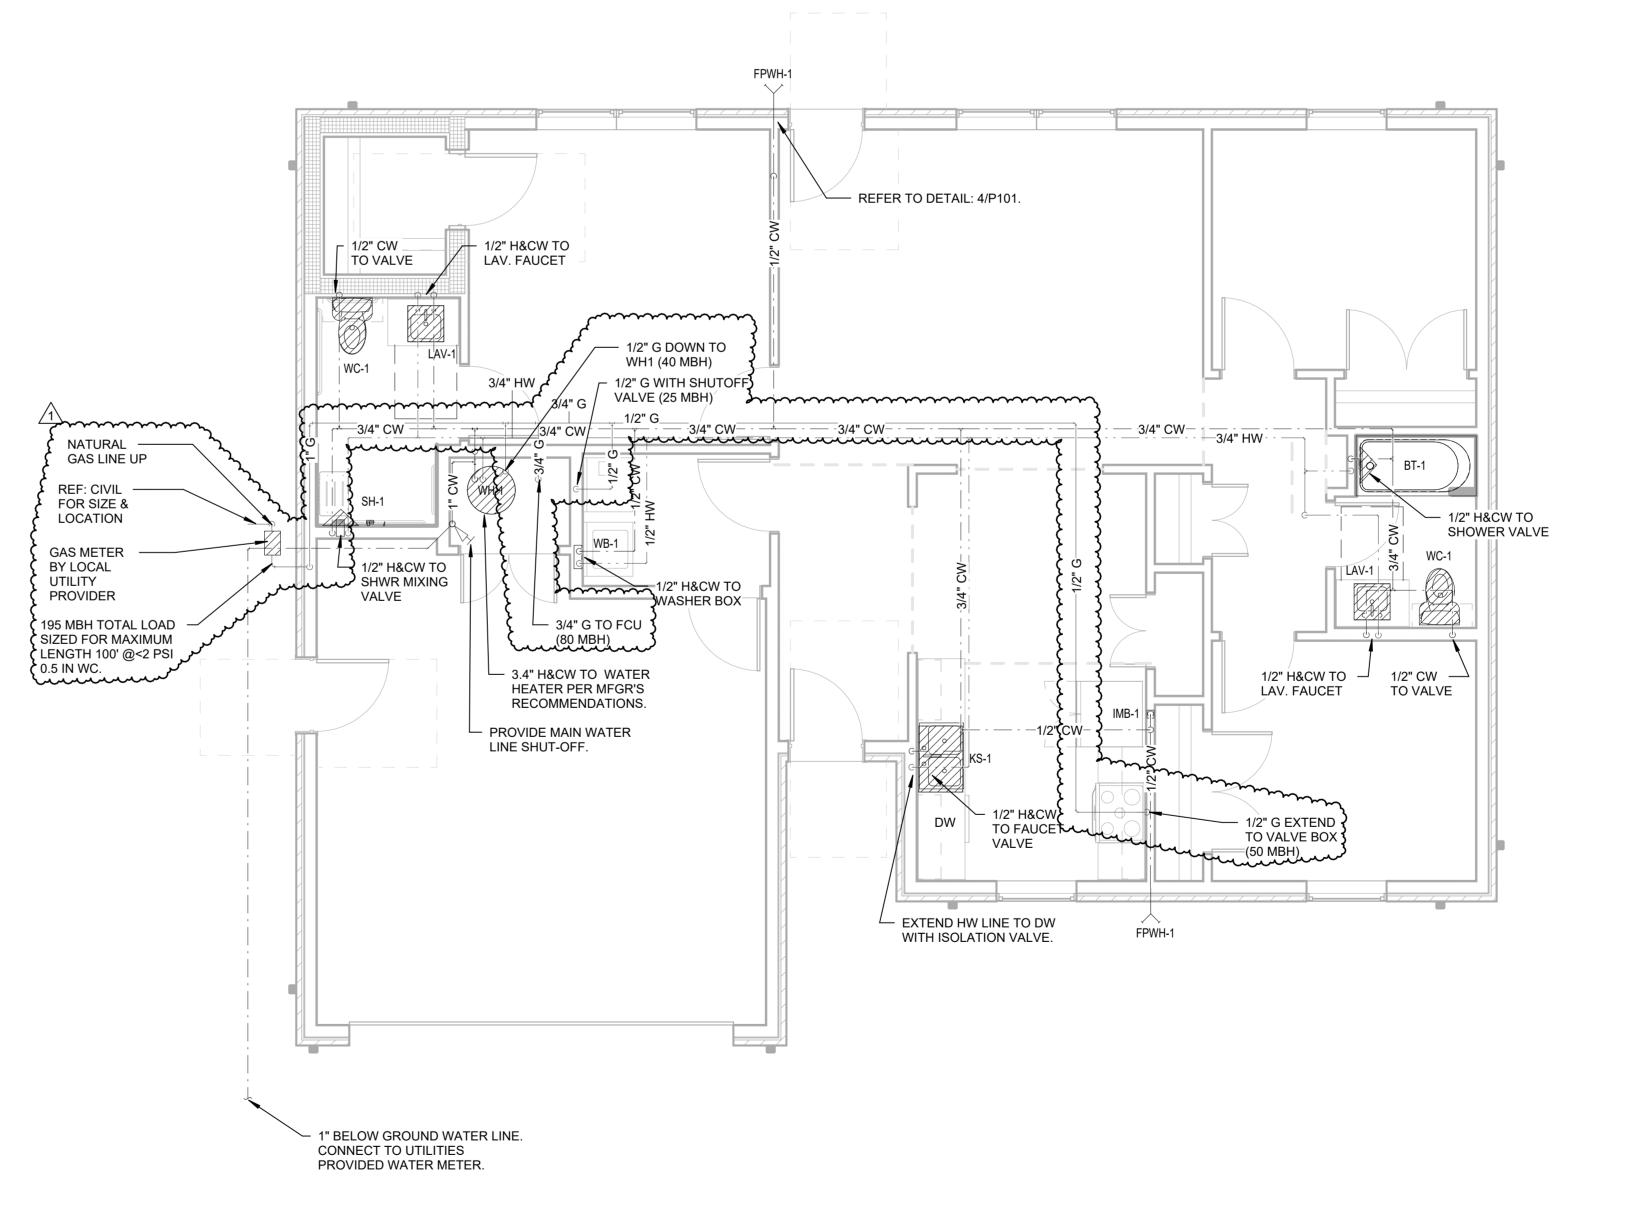

2 FIRST FLOOR DOMESTIC WATER PLAN
1/4" = 1'-0"





# OUSING

TULSA, OK 74119 (918) 582-4088 • FAX (918) 582-4087 OK COA #2940 • EXP 06/30/2022

110 W. 7TH STREET • SUITE 600

BLUE RIVER PROJECT NUMBER: 20220104 ISSUE DATE: 08/18/2022

ISSUE: CONSTRUCTION

**DOCUMENTS** 

OTHER ISSUE DATES: NO. DESCRIPTION

1 ASI#1

TYPE 3 PLUMBING **PLANS**