

CM CLARIFICATION #013
PROJECT: CNE Tahlequah Casino

July 25, 2018

Foreman Manhattan Team has added and/or revised the following CM Manual documents for review and inclusion by all contractors within their Scope Package Proposal:

1. 00 01 10 TABLE OF CONTENTS:

- a. Table of Contents revised to include revised list of Bid Packages

2. 00 50 00 – The following Scope Bid Packages (Bid Forms) have been revised and re-issued with this CM Clarification #013:

- a. 06.02 REV 2 Theming Millwork
- b. 10.02 REV 2 Awnings
- c. 10.04 REV 2 Toilet Partitions and Bath Accessories
- d. 32.01 REV 1 Asphalt Paving
- e. 32.02 REV 1 Site Concrete

3. 00 61 05 Exhibit D – Document Listing

- a. Revised to include current CM Clarification(s) and Addenda

(Documents attached to this CM Clarification)

4. Interior Theming Package / Interior Renderings

See attached Interior Renderings package issued by Childers Architect, dated 6/1/2018 ("Interior Theming Package) – FOR REFERENCE ONLY

5. Questions and Responses:

Foreman Manhattan has received the following Questions and Responses which affect Bid Package 06 Scope Packages:

BP #	Description	RFI #	Question	Answer
10.07	Flagpoles	115	<p>Ref: 10 7500 / 3.06</p> <p>Please confirm that 2ea - 30' and 1ea - 40' flagpoles are to be installed in lieu of 1ea - 30' and 2ea - 40' as stated in 10 7500 / 3.06.</p> <p>Ref: 10 7500 / 2.02 & 10 7500 / 2.05</p> <p>Please verify if it is the design intent to have an internal rope halyard with cam lock cleat and eliminate the need for a hand crank.</p>	<p>1ea - 40' flagpole and 2ea - 30' flagpole.</p> <p>Per spec operate with a hand crank.</p>
9.04	Resinous Flooring	116	<p>Ref: A1.13 INTERIOR FINISH LEGEND</p> <p>Please provide height of urethane cement integral base concerning areas where urethane cement is to be installed.</p>	Base height to be 6"
6.02	Theming Millwork	See Bid Package	See Revised Bid Package 06.02 REV 2 issued with CM Clarification #013	See Revised Bid Package 06.02 REV 2 issued with CM Clarification #013

Please Contact **Tina Jones, Buyer IV** with any questions:

Tina Jones

(918) 384-7802

Tina.Jones@cnet.com

- END OF CM CLARIFICATION -

TABLE OF CONTENTS

INTRODUCTORY INFORMATION

00 0110 TABLE OF CONTENTS

BIDDING REQUIRMENTS

00 21 13 INSTRUCTIONS TO BIDDERS

00 35 00 BID DOCUMENTS TO BE SUBMITTED WITH BID

00 35 00 REPRESENTATIONS AND CERITIFICATIONS

00 35 19 NON-COLLUSION AFFIDAVIT
00 35 21 BUSINESS RELATIONSHIP AFFIDAVIT
00 35 50 TERO – LEGISLATIVE ACT 01-14
00 35 55 TERO – GENERAL PROVISIONS
00 35 56 TERO – PROJECT LABOR AGREEMENT (Sample)
00 35 57 TERO – CORE CREW LIST (Sample)
00 35 58 TERO – PROJECT LABOR FEES (Sample)
00 35 59 TERO – Sign In Log (Sample)
00 35 80 CODE OF CONDUCT FOR CNE JOBSITES

00 45 00 PRE-QUALIFICATION REQUIREMENTS

00 45 13A PREQUALIFICATION INSTRUCTIONS
00 45 13B FORM 2 - PREQUALIFICATION FORM
00 45 13C FORM 4 - SAMPLE SURETY COMMITMENT LETTER
00 45 13E W-9 FORM
00 45 13F INSURANCE REQUIREMENTS

BID FORMS, BID PACKAGE LIST AND BID PACKAGES

00 50 00 BID PACKAGES

06.01 REV 1 Basic Millwork
06.02 REV 2 Theming Millwork
07.03 REV 1 Waterproofing and Damp Proofing
08.03 REV 1 Hollow Metal Doors and Hardware Package
09.02 REV 1 Painting and Wall Finishes
09.03 REV 1 Floor Finishing
09.04 REV 1 Resinous Flooring
09.05 REV 1 Access Flooring
10.02 REV 2 Awnings
10.03 REV 1 Wall and Corner Guards
10.04 REV 2 Toilet Partitions and Bath Accessories
10.05 REV 1 Fire Extinguishers
10.06 REV 1 Lockers
10.07 REV 1 Flag Poles

12.03 Food Service

26.03 Structured Cabling – Backbone

By Owner

By Owner

27.01 Voice – Data – Gaming Data Communications
27.02 Audio – Visual Systems
27.03 Access Control management Systems
27.04 Electronic Surveillance

By Owner
By Owner
By Owner
By Owner

32.01 REV 1 Asphalt Paving

32.02 REV 1 Site Concrete

32.03 Pavement Markings

32.04 Fence and Gates
32.05 Landscape and Irrigation

Design Pending
Design Pending

00 60 00

SUBCONTRACT FORMS

00 60 01 SUBCONTRACT AGREEMENT
00 60 02A MANHATTAN GENERAL PROVISIONS
00 60 02B OKLAHOMA RIDER
00 60 03 EXHIBIT A – Scope of Work
00 60 04 EXHIBIT B – Subcontractor Performance and Payment Bonds
00 60 05 EXHIBIT C – Insurance
00 60 06 EXHIBIT D – Documents Listing **REV 2**
00 60 07 EXHIBIT E – Special Conditions
00 60 08 EXHIBIT F – Schedule
00 60 09 EXHIBIT G – Tax Exempt – O.D.P.I.
00 60 10 EXHIBIT H – Manhattan Additional Safety Requirements

00 61 00

PURCHASE ORDER FORMS

00 61 01 P.O. AGREEMENT
00 61 02 EXHIBIT A – PO Scope of Work
00 61 03 EXHIBIT B – Supplier Contract Bond
00 61 04 EXHIBIT C - Insurance
00 61 04A EXHIBIT C - Insurance Sample
00 61 05 EXHIBIT D – Document Listing - - (See 00 60 06 Exhibit D)
00 61 07 EXHIBIT F – Schedule - - (See 00 60 08 Exhibit F)
00 61 08 EXHIBIT G – Tax Exempt – O.D.P.I.
00 61 09 EXHIBIT H – Manhattan Additional Safety Requirements
00 61 10 EXHIBIT I – Indemnification

00 70 00

CONTRACT MANAGER CONTRACT REQUIREMENTS

00 70 19 PROJECT SPECIFIC SAFETY PROGRAM
00 70 20 OPERATION ZERO STATEMENT
00 70 30 CM PAYMENT PROCEDURES
00 70 50 CM SHOP DRAWINGS, PRODUCT DATA AND SAMPLES

BID PACKAGE – CNE Tahlequah Casino: SCOPE PACKAGE 06.02 REV 2 – Theming Millwork

Submitted by (Company Name per W-9 Form): _____

Provide the following *Lump Sum Proposal* as requested in accordance with all scope items listed in Scope of Work.

BASE BID – Theming Millwork: \$ _____

BID ALTERNATES:

Alternate No. 1: Additional Ceiling Elements (Ref Attached Sketch)

Provide linear ceiling elements identified as Theming Millwork Ceiling Alternate 1 on North end of casino.

Alternate No. 1 – NET CHANGEADD / DEDUCT \$ _____ / LS

Alternate No. 2: Weaving Ceiling Elements (Ref Attached Sketch)

Provide linear ceiling elements identified as Theming Millwork Ceiling Alternate 2 on South end of casino.

Alternate No. 2 – NET CHANGEADD / DEDUCT \$ _____ / LS

Alternate No. 3: Additional Ceiling Elements (Ref Attached Sketch)

Provide linear ceiling elements identified as Theming Millwork Ceiling Alternate 3 on South end of casino.

Alternate No. 3 – NET CHANGEADD / DEDUCT \$ _____ / LS

~~**Alternate No. 4: Backlit Letter Signage**~~

~~Provide and install all backlit letter signage in casino, Complete. Including but not limited to “CASHIER”, “REWARDS”, “BEVERAGES”, “W”, & “M”~~

~~**THIS ALTERNATE ELIMINATED THROUGH CLARIFICATION #13**~~

Other Comments:

Contact Name:

Address:

Phone/Fax:

Email:

Signature:

By acknowledging items below, bidder certifies acceptance of these documents and that all associated costs have been included in the proposal amount. Any and all exceptions/comments to these documents must be attached to this proposal. Comments or requested revisions to these documents will not be accepted after this proposal date.

TERO bidders must supply a copy of TERO Certificate, front of back	<input type="text" value="Initial:"/>
Non-Collusion Affidavit	<input type="text" value="Initial:"/>
Business Relationship Affidavit	<input type="text" value="Initial:"/>
Acknowledge all scope of work items listed under scope of work (See Exhibit A)	<input type="text" value="Initial:"/>
Acknowledge Exhibits B, C, D, E, F, G, H	<input type="text" value="Initial:"/>
Addenda Included	<input type="text" value="#s:"/>
MCC Clarifications Included	<input type="text" value="#s:"/>
Acknowledge and agree to Foreman Manhattan Standard Subcontract Agreement/Special Terms and Conditions as per Exhibit E	<input type="text" value="Initial:"/>
Acknowledge and agree to Manhattan General Provisions as Included in the Bid Documents	<input type="text" value="Initial:"/>
SCHEDULE/EXPEDITING/SUBMITTALS Foreman Manhattan Construction Target Schedule is attached. Please verify supplier is able to meet Foreman Manhattan required installation dates.	<input type="text" value="Initial:"/>

Sales Tax

All bids must be submitted exclusive of Federal Excise Tax and Oklahoma State Sales Tax. The Cherokee Nation is exempt from Oklahoma State Sales Tax and Federal Excise Tax under authority of § Okla. Stat. Supp. 1994 Section 1356. Bidder is to include and pay all other applicable sales tax and use taxes as required. Applications for payment shall be broken down as required by the Owner or Construction Manager.

Specific Project Requirements for the process, approval, and payment of Owner-Direct Payment Items (ODPI) are identified in section 00 60 09:

EXHIBIT "G" Tax Exempt / Owner Direct Paid Invoice (ODPI) Payment Process

Tribal Employment Rights Office.

SUBCONTRACTOR IS TO COMPLY WITH ALL CHEROKEE NATION, TRIBAL EMPLOYMENT RIGHTS OFFICE (TERO), NATIONAL INDIAN GAMING ASSOCIATION (NIGA), AND ALL BUREAU OF INDIAN AFFAIR'S (BIA) RULES, REGULATIONS, AND LICENSING REQUIREMENTS INCLUDING ALL FEES AND ASSESSMENTS, ASSESSMENT, APPLICABLE TO THIS PROJECT.

11.1.1 - TERO document "An Act" Legislative Act 01-14 dated February 10, 2014.
This Document is ACT AMENDING LA 30-12, "CHEROKEE NATION EMPLOYMENT RIGHTS ACT"

11.1.2 - Subcontractors are to EXCLUDE the cost for Section; Title 40, § 1011; T.
To assess an Employee Rights Fee of one-half (1/2) of one percent (1%) on all covered contracts. This cost will be paid by the Construction Manager.

11.1.3 - The Work Permits paragraph of the Tribal Employment Rights Office (TERO) Project Labor Agreement - Master Agreement LA 01-14 states: No person who is not a member of a federally recognized tribe shall be employed by a covered employer until he or she has obtained a work permit from the TERO at a cost of twenty-five dollars (\$25) per day, per permit. Subcontractors are to INCLUDE in their proposed price for the work, all costs associated with the twenty-five (\$25) per day work permit for every non-Indian individual employed on this project.

Performance and Payment Bond Requirements: (Subcontractor contracts Only)

Costs for performance and payment bonds **shall be included in your base bid and any applicable alternates or unit prices.**

All exterior envelope Bid Packages (Trades) will be required to bond. In addition, all base bids, combination base Bid and including all alternates of \$100,000 or above will require Performance and Payment Bond equal to one hundred percent (100%) of the contract amount. Reference Section 00 60 04 – Exhibit B of the C.M. Bid Manual.

No obligation shall be incurred by the Owner or Foreman Manhattan Construction Team to any Bidder by reason of the issuance of these written instructions, by any notification relating to this bid, or by any act other than the execution of a written Subcontract Agreement between Foreman Manhattan Construction Team and the Bidder.

APPLICABLE SPECIFICATIONS:

DIVISION 00 – Foreman Manhattan’s Construction Manager’s Bid Manual	Complete
<u>BID PACKAGE 01 (March 6, 2018)</u>	
DIVISION 00 – Procurement Requirements and Contracting Requirements	As Applicable
DIVISION 01 – General Requirements	As Applicable
DIVISION 03 – Concrete	As Applicable
DIVISION 31 – Earthwork	As Applicable
DIVISION 32 – Site Improvements	As Applicable
DIVISION 33 – Utilities	As Applicable
Legends, Notes and Schedules per Plans and Specifications	As Applicable
Geotechnical Engineering Report by Building & Earth Sciences, Inc. dated January 17, 2018	As Applicable
<u>BID PACKAGE 02 (March 27, 2018)</u>	
DIVISION 07 – THERMAL AND MOISTURE PROTECTION	As Applicable
DIVISION 22 – PLUMBING	As Applicable
DIVISION 23 – HEATING, VENTING, AND AIR CONDITIONING	As Applicable
DIVISION 26 – ELECTRICAL	As Applicable
DIVISION 31 – EARTHWORK	As Applicable
<u>BID PACKAGE 03 (April 16, 2018)</u>	
DIVISION 03 – CONCRETE	As Applicable
DIVISION 04 – MASONRY	As Applicable
DIVISION 05 – METALS	As Applicable
DIVISION 06 – WOOD, PLASTICS, AND COMPOSITES	As Applicable
DIVISION 07 – THERMAL AND MOISTURE PROTECTION	As Applicable
DIVISION 08 – OPENINGS	As Applicable
DIVISION 09 – FINISHES	As Applicable
DIVISION 10 – SPECIALTIES	As Applicable
DIVISION 11 – EQUIPMENT	As Applicable
<u>BID PACKAGE 04 (April 20, 2018)</u>	
DIVISION 32 – EXTERIOR IMPROVEMENTS	As Applicable
<u>BID PACKAGE 05 (May 3, 2018)</u>	
DIVISION 6 – WOODS, PLASTICS AND COMPOSITES	As Applicable
06 2000 – Finish Carpentry	Complete
06 4100 – Architectural Wood Casework	Complete
06 8300 – High Pressure Decorative Laminates	Complete
DIVISION 8 – OPENINGS	As Applicable
DIVISION 9 – FINISHES	As Applicable
DIVISION 10 – SPECIALTIES	As Applicable
DIVISION 11 – EQUIPMENT	As Applicable
DIVISION 22 – PLUMBING	As Applicable
DIVISION 23 – HEATING VENTILATING AND AIR-CONDITIONING (HVAC)	As Applicable
DIVISION 26 – ELECTRICAL	As Applicable
DIVISION 28 – ELECTRONIC SAFETY AND SECURITY	As Applicable

BID PACKAGE 06 (June 22, 2018)

DIVISION 6 – WOODS, PLASTICS AND COMPOSITES

06 6100 – Simulated Stone Fabrication

06 8300 – High Pressure Decorative Laminates, Plastic Panels, Metal Panels, and Laminated Panels

DIVISION 9 – FINISHES

As Applicable

As Applicable

Complete

As Applicable

Terminology:

Contractor and/or Subcontractor shall mean Scope Package Bidder.

Construction Manager (CM) shall mean Foreman Manhattan Construction Team.

SCOPE OF WORK:

Includes, but is not limited to, providing all the necessary labor, materials, tools, supplies, supervision, insurance, equipment, scaffolding, hoisting, fees, etc. necessary to provide the **Theming Millwork at the CNE Tahlequah Casino**, Tahlequah, Oklahoma in accordance with the Contract Documents. It is further understood and agreed that this Subcontract also includes the furnishing and installation of the below listed items regardless of whether or not they are in the listed specification section(s) or any other specification section(s), or shown on the plans. This scope listing is to be used as a guideline and should not be considered as an all-inclusive list of items required to provide a complete scope of work under this proposal. Drawing and detail references are provided for reference only and are not to be considered as all-inclusive of Contract Documents for the particular items referenced. **(Please note: The word “provide” when used herein shall mean furnish and install completely, including all costs for labor, materials, equipment, hoisting, layout, scaffolding, ladders, staging, tools, rigging and any other appurtenances necessary to complete the Work”.)** Subcontractor has familiarized himself with the documents and has included those items of work shown and noted on the documents and all other equipment, devices and components that are not shown or noted, but required to provide a complete, functional and working system that is in compliance with all Federal, state and local codes.

1. Provide all architectural woodwork, millwork, casework, countertops and special countertops as required by the contract documents. All work to be furnished and installed with materials as indicated, specified, in accordance with best practice, and as required to make a complete system.
2. Provide all wood and plastic laminate cabinets, including base cabinets, wall cabinets, full height cabinets, etc., complete.
3. Provide all countertops, counters, and transaction tops including back, end, and side splashes (Full height and partial), as indicated, specified and as required including but not limited to plastic laminate, quartz, granite, stone, stainless steel, or solid surface tops.
4. Provide all wood base, Complete.
5. Refer to all applicable millwork elevations and sections. E.G. A8.0; A8.1; A8.2; A8.3; A8.4; A8.5; A8.6; A8.7; A8.8; A8.9; A8.10; A8.11; A8.12, A8.13, A8.14; A8.15,
6. Provide all concrete countertops, Complete. Include cast-in drink rail where applicable.
7. Provide all decorative metal panels, Complete. E.G. Moz panels or others.
8. Provide all plastic laminates in public spaces, Complete.
9. Provide all ledges above doorways and counters, Complete. E.G. A2.11
10. Provide Cherokee Syllabary element around casino, meeting rooms, etc, Complete. Include all plastic laminate or metal panel background, vinyl cut letters, laminate trim, and print elements. E.G. A6.21
11. Provide all metal bands and trim on millwork as required.
12. Provide Cashier cage/screen, Complete. E.G. 1/A2.11
13. Provide any plastic laminate chair rail or decorative bands.
14. Provide all plastic laminate casings at cased openings, Complete. E.G. 5,6,7/A5.4
15. Provide all millwork and cabinetry in casino, including but not limited to cashier, rewards, beverages, and other locations, Complete.
16. Provide restaurant booth divider walls as a complete, shop-fabricated element. E.G. 1, 2, 3, 8/A2.14
17. Provide all restaurant millwork and decorative panels, complete.
18. Provide all metal, wood, or plastic laminate column cover elements, complete. If possible, fabricate column covers as a complete shop fabricated unit. Coordinate with other trades as required.
19. Provide 4'x4' Shadow Box(es), Complete. E.G. 1/A2.16
20. Provide all plastic laminate, solid surface, stone and similar finish items with the color and pattern specified.
21. Provide any adjustable shelving including all standards and brackets as specified, indicated and required.
22. Provide all grommets for openings as indicated, as located by the Owner on the shop drawings, and as needed after casework installation.
23. Provide all millwork hardware, pulls, hinges, glides, sliders, rails, brackets, stops, trim strips, locks, latches, cam locks, tabs, tight-joints, bullet catches, wire management raceways, shelf standards, etc. as required for a complete millwork package
24. Provide all plumbing and electrical cut-outs, (i.e. sinks, fixtures, outlets, switches, etc.) as indicated, specified and required. Coordinate all countertop penetrations with associated trades.
25. All sides of drawers and drawer edges shall receive plastic laminate. Additionally, all cabinet doors shall receive plastic laminate on the interior and exterior face as well as edge bands.
26. Provide all wood framing and blocking, including base and wall blocking, and surface mounted wall furring strips, etc. which are required for complete installation (Note: All in-wall backup blocking is by others).

27. Provide all wood finishes, wood paneling, wood casing, standing & running trim, acrylic panels and themed millwork as required by the Contract Documents.
28. Provide all staining or sealing of all items included in this package. All items to be factory stained or finished if possible.
29. Provide any backing noted as required by millwork contractor.
30. Provide all wood door casings.
31. Provide all millwork cosmetic caulking to adjacent finishes.
32. Provide detailed on-site blocking layout prior to drywall installation for in-wall blocking & backing installation by others.
33. Provide protection of adjacent surfaces and finishes.
34. Provide any solid surface window sills, if required.
35. Reception Desks, Information Desks, Cashier Desks, etc. Complete.
36. All quartz and granite countertops, complete.
37. Any glass countertops or transaction tops, complete
38. Any stainless steel countertops, transaction tops, pass through countertops/shelves complete.
39. Any tempered glass elements attached to millwork including hardware, standoffs, etc. complete.
40. All cabinetry and countertops indicated on millwork elevations, complete.
41. Any steel structure to support millwork or countertops
42. All countertop supports of all types
43. Any trash cans, storage bins, or shelves identified within millwork.
44. Decorative wall panels at millwork, complete, including but not limited to brackets, hardware, and trim.
45. Any required surface mounted blocking for paneling or millwork, complete.
46. Provide millwork at Reception Stations, Display Units, and other millwork elements in Casino, Complete.
47. Provide all Bar Millwork and Countertop, Complete
48. Provide Bar as a complete, shop fabricated item including all framing. Plywood can be used in lieu of gyp board. Provide any required FRP, steel tube supports, etc. E.G. 1/A3.7
49. Provide Stainless Steel footrests, Complete.
50. Provide any steel grab bars at Bar, Complete.
51. Provide Low Walls at Casino Floor, Bar, & Restaurant, Complete, Including framing, gyp/drywall, paint, decorative panels, etc. Complete unit to be shop fabricated and installed on site as a single unit. Wood materials can be used in lieu of light gauge framing where practical.
52. Provide all back bar millwork, Complete.
53. Provide trash chute in bar millwork, Complete. E.G. 3/A8.13
54. Provide all required purse hooks at bar(s).
55. Provide provisions for fans at bar top game locations. E.G. 5/A8.12
56. Comply with all applicable Finish Notes.
57. Provide all shop drawings, product data, sample and other pertinent submittals for the work of this Subcontract. Provide engineering and printing costs for all shop drawings, coordination drawings, and product submittals for architect approval as required to properly coordinate the work included in this Subcontract with other trades. Include costs for revising and resubmitting shop/ coordination drawings as needed. Provide shop drawing showing locations, elevations and details of the required in-wall blocking.
58. All bidders shall include cleanup of all debris created by the work of their scope as directed.
59. Provide temporary fire extinguishers for equipment on-site and during welding operations per OSHA requirements.
60. Contractor shall pay special attention to site logistics plan when planning deliveries. Site access and truck maneuverability is limited.
61. This subcontractor shall coordinate and work with the Electrical Subcontractor to install the LED Lights in wood ceiling elements
62. Include pricing associated with RFI responses included below. (Added through Clarification #13)

GENERAL ITEMS

63. Provide all shop drawings, product data, sample and other pertinent submittals for the work of this Subcontract. Provide engineering and printing costs for all shop drawings, coordination drawings, and product submittals for architect approval as required to properly coordinate the work included in this Subcontract with other trades. Include costs for revising and resubmitting shop/ coordination drawings as needed.
64. Subcontractor will assist Foreman Manhattan with providing material quantities and cost breakdowns as required for the Owner's and Foreman Manhattan's budget requirements. All breakouts specified in this subcontract will be used for accounting purposes and tracking only.
65. Contractor shall provide a complete installation that complies with all applicable codes, ordinances and satisfying all Authorities Having Jurisdiction.
66. Provide all required pedestrian protection, traffic control and protection including flagman, barricades, signage, etc. as required for the work, and as may be required for protection for equipment access, deliveries and loading.
67. Subcontractor is required to comply with requirements to control Dust and Airborne Contaminants. No waste materials or debris shall be allowed to accumulate.
68. It is mutually understood and agreed that this subcontractor will coordinate all of the scheduled deliveries of these items being furnished by others with the Foreman Manhattan designated representative. This includes the on or off site storage, staging, inventory control, and shipping to the site. All damages or shortages are to be reported within 24 hours of delivery.
69. Subcontractor agrees to be bound by the Welcome Package issued by the Foreman Manhattan Field staff.
70. **Revise paragraph 1.2.3 of section 00 60 02A Manhattan General Provisions as contained in the Construction Manager's Bid manual as follows:**

Until Subcontractor's obligations under this Subcontract are completely fulfilled, Subcontractor agrees not to perform any *changes to the work* directly for Owner or any of its tenants, or deal directly with Owner's representatives *with respect to the work and/or changes to the work*, in connection with the Project, unless approved in writing by Foreman Manhattan. *Foreman Manhattan understands that the Owner and specifically TERO shall communicate directly with the subcontractor to maintain a spirit of cooperation and also to utilize the TERO Job Bank to the fullest extent giving first hire priority rights to Cherokee Citizens.*

71. The Owner requirements for funding for work in progress is to provide payment less retainage of ten percent (10%), which shall be withheld and paid, without interest, upon final completion of the entire project.
72. The terms and conditions contained in the following documents including General Provisions, Article 2.5, "Indemnification" as included within the contract documents; are incorporated herein by reference as if fully written out;
 - Foreman Manhattan General Provisions 2012
 - Exhibit A – (Scope of Work)
 - Exhibit B – (Bond Forms)
 - Exhibit C – (Insurance Requirements / Sample)
 - Exhibit D – (Contract Documents)
 - Exhibit E – (Special Conditions)
 - Exhibit F – (Project Schedule)
 - Exhibit G – Tax Exempt – O.D.P.I.
 - Exhibit H – (Foreman Manhattan Additional Safety Requirements)

SCOPE OF WORK EXCLUSIONS:

The following items are excluded from this Subcontract:

1. Millwork included in Scope Package 06.01 Basic Millwork

RFI RESPONSES:

Please include all pricing associated Pre-Bid RFI Responses Below (Added through Clarification #13)

1. Line item 10, calls for Syllabary Element A6.21. Is this vinyl cut lettering applied to the M-1? Does the architect have a cad drawing of this, so we can get pricing from a vendor? **Letters on M-1 to be etched and painted. CAD file is not available at this time.**
2. Line item 12, calls for us to supply the cashier cage/screen. Can we get some kind of detail that shows dimensions & type of material/finish? **Material/finish to be consistent with other Cherokee nation casinos.**
3. Line item 19, Shadow boxes. Can we get some details as to sections and material/finish? **Shadow boxes will be owner provided, only blocking will be required.**
4. Line item 25, calls for plastic laminate interiors and exterior of casework including drawers, please confirm.
This is confirmed.
5. Line item 46, calls for supply complete displays, I assume that is the ones on sheet A2.10. Please provide details along with materials/finish. **All exposed finished to be plastic laminate. Provide 4 full length adjustable shelves per display case.**
6. Alternate # 4 calls for Backlit Letter Signage, please provide details, electrical specifications, and materials/finish.
This will be part of the signage package.
7. Drawings A8.9 and A8.13 conflict as to the back bar. The elevations on A8.9 show a two-tier bottle shelf with stainless steel tops and 8.13 shows three tier that is underlit with what appears to be acrylic or resin tops. **A8.9 needs to match the section on A8.13**
8. A8.13 also appears to call for a glass shelf in the recess for TV's. **This can be omitted.**
9. Please also clarify what material is to be used for the bottle shelf surfaces.
Mirrors should be used on the face of bottle shelves. The horizontal surfaces are to be acrylic to allow color changing LED lighting to shine through.
10. A2.7 Elev. 10. Is the bench BOH Millwork? If not, can you please tell me what it is finish wise? **Stainless Steel Finish.**
11. A6.10 Ceiling Symbols call out MOZ Panel – 1 but not on the Enlarged RCP Plans. If there is to be MOZ Panel at the ceiling, how is it attached. I don't find a section for it. Please clarify.
Sheet A8.14, WD-1 on the bar front is a typo the correct call out is WDP-1.
12. What material / finish is applied to the backlit letter signage (Cashier, Rewards, Beverages, W, M) **These have been excluded from this scope of work.**
13. Drawing A1.2 shows some curved walls in the lounge and grab & go area. Are these in fact die walls or are they something else? **These are to be die walls.**
14. If they are walls are they to match the elevations 9, 10, & 11 on A2.21? **Yes, these should match those elevations.**
15. Do they get a concrete cap as shown on detail 2/A8.13? **Yes, all are to received a concrete cap.**
16. Do these have curved countertops on one side like appears to be indicated on A1.0? **No, the curving lines shown are modular booths to be provided by others.**
17. Drawings (EG A8.14) call for WD-1 on the front of the bar, however this is not in the finish schedule. Should this be wood to match PL-3 or WDP-1 or something else? **Use wood paneling WDP-1 at locations identified as WD-1.**
18. Elev. 2 & 3 Display Cases? I'm assuming not millwork. Is this correct? These are included in this scope package.

19. Elev. 7 & 8 Chair Rail Area. Is this for BOH Millwork to pick up? How does a 2x6 work for top and bottom of HIWC? I'm assuming this isn't ours to pick up but need to ask. **Do not include the 2x6 chair rail in this scope package.**
20. Elev. 10 – 13. Is Plywood to be picked up by Theming Millwork? **Do not include plywood on the walls.**
21. Elev. 1 – 4. Is plywood to be picked up by Theming Millwork? **Do not include plywood on the walls.**

Value Analysis Suggestions:

Please write in the box below any suggestions for cost savings / value analysis which were discovered during the course of bidding this project, along with a dollar value for each item. VA Suggestions may be included in the criteria considered for successful subcontractor selection. Attach additional sheet(s) if necessary.

1. < \$_____ > Savings
Description:

2. < \$_____ > Savings
Description:

3. < \$_____ > Savings
Description:

4. < \$_____ > Savings
Description:

5. < \$_____ > Savings
Description:



James R. Childers
Architect, Inc.
46 South 4th Street
Fort Smith, AR 72701
479-782-5462
www.jrchildersarchitect.com



CONSULTANT LOGO



CHEROKEE NATION ENTERTAINMENT
TAHLEQUAH CASINO
TAHLEQUAH, OKLAHOMA


PROJECT PHASE
BID PACKAGE 6

NO.	DATE	REVISION	DESCRIPTION


DATE: 06/22/18 JOB NUMBER: 17-06

PROJECT NUMBER: A6.19

ENLARGED REFLECTED CEILING PLAN


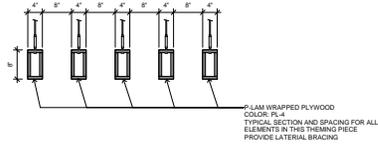


3 CURVED THEMING ELEMENT SECTION
3/4" = 1'-0"

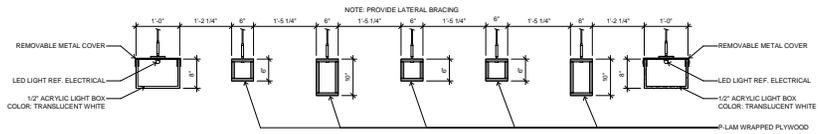

2 WEAVING THEMING ELEMENT SECTION
3/4" = 1'-0"

Alternate 2
Ceiling
Element

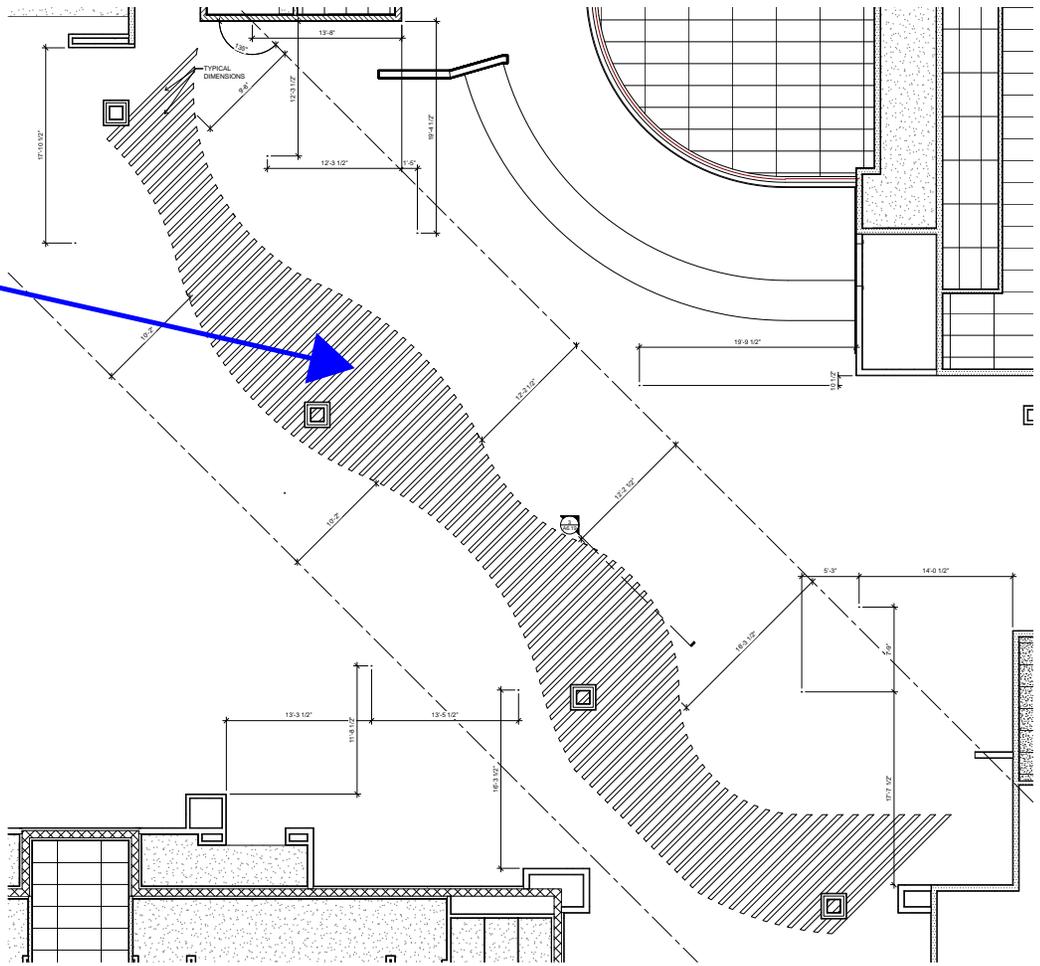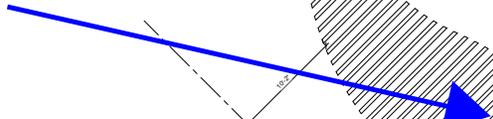

1 ENLARGED REFLECTED CEILING PLAN
3/16" = 1'-0"



BID PACKAGE – CNE Tahlequah Casino:
SCOPE PACKAGE 10.02 REV 2 – Awnings (Issued with CM Clarification #013)

Submitted by (Company Name per W-9 Form): _____

Provide the following *Lump Sum Proposal* as requested in accordance with all scope items listed in Scope of Work.

BASE BID – Fabric Awnings (Per Spec): \$ _____

BID ALTERNATES:

Alternates shall be inclusive of all required labor, materials and equipment in accordance with all general scope items listed in the Exhibit "A" Scope of Work:

Alternate No. 1: Metal Awnings

Provide and install COMPLETE Metal / Aluminum Awnings in lieu of the Base Bid Fabric Awnings. Alternate #1 Awnings to be of Manufacturer's Standard Enamel Finishes.

Alternate No. 1 – NET CHANGE **ADD / DEDUCT \$** _____ **/ LS**

Other Comments:

Contact Name: _____

Address: _____

Phone/Fax: _____

Email: _____

Signature: _____

By acknowledging items below, bidder certifies acceptance of these documents and that all associated costs have been included in the proposal amount. Any and all exceptions/comments to these documents must be attached to this proposal. Comments or requested revisions to these documents will not be accepted after this proposal date.

TERO bidders must supply a copy of TERO Certificate, front of back Initial:

Non-Collusion Affidavit Initial:

Business Relationship Affidavit Initial:

Acknowledge all scope of work items listed under scope of work (See Exhibit A) Initial:

Acknowledge Exhibits B, C, D, E, F, G, H Initial:

Addenda Included #s:

MCC Clarifications Included #s:

Acknowledge and agree to Foreman Manhattan Standard Subcontract Agreement/Special Terms and Conditions as per Exhibit E Initial:

Acknowledge and agree to Manhattan General Provisions as Included in the Bid Documents Initial:

SCHEDULE/EXPEDITING/SUBMITTALS
Foreman Manhattan Construction Target Schedule is attached. Please verify supplier is able to meet Foreman Manhattan required installation dates. Initial:

Sales Tax

All bids must be submitted exclusive of Federal Excise Tax and Oklahoma State Sales Tax. The Cherokee Nation is exempt from Oklahoma State Sales Tax and Federal Excise Tax under authority of § Okla. Stat. Supp. 1994 Section 1356. Bidder is to include and pay all other applicable sales tax and use taxes as required. Applications for payment shall be broken down as required by the Owner or Construction Manager.

Specific Project Requirements for the process, approval, and payment of Owner-Direct Payment Items (ODPI) are identified in section 00 60 09:

EXHIBIT “G” Tax Exempt / Owner Direct Paid Invoice (ODPI) Payment Process

Tribal Employment Rights Office.

SUBCONTRACTOR IS TO COMPLY WITH ALL CHEROKEE NATION, TRIBAL EMPLOYMENT RIGHTS OFFICE (TERO), NATIONAL INDIAN GAMING ASSOCIATION (NIGA), AND ALL BUREAU OF INDIAN AFFAIR'S (BIA) RULES, REGULATIONS, AND LICENSING REQUIREMENTS INCLUDING ALL FEES AND ASSESSMENTS, ASSESSMENT, APPLICABLE TO THIS PROJECT.

11.1.1 - TERO document “An Act” Legislative Act 01-14 dated February 10, 2014.
This Document is ACT AMENDING LA 30-12, "CHEROKEE NATION EMPLOYMENT RIGHTS ACT"

11.1.2 - Subcontractors are to EXCLUDE the cost for Section; Title 40, § 1011; T.
To assess an Employee Rights Fee of one-half (1/2) of one percent (1%) on all covered contracts. This cost will be paid by the Construction Manager.

11.1.3 - The Work Permits paragraph of the Tribal Employment Rights Office (TERO) Project Labor Agreement - Master Agreement LA 01-14 states: No person who is not a member of a federally recognized tribe shall be employed by a covered employer until he or she has obtained a work permit from the TERO at a cost of twenty-five dollars (\$25) per day, per permit. Subcontractors are to INCLUDE in their proposed price for the work, all costs associated with the twenty-five (\$25) per day work permit for every non-Indian individual employed on this project.

Performance and Payment Bond Requirements: (Subcontractor contracts Only)

Costs for performance and payment bonds **shall be included in your base bid and any applicable alternates or unit prices.**
All exterior envelope Bid Packages (Trades) will be required to bond. In addition, all base bids, combination base Bid and including all alternates of \$100,000 or above will require Performance and Payment Bond equal to one hundred percent (100%) of the contract amount. Reference Section 00 60 04 – Exhibit B of the C.M. Bid Manual.

No obligation shall be incurred by the Owner or Foreman Manhattan Construction Team to any Bidder by reason of the issuance of these written instructions, by any notification relating to this bid, or by any act other than the execution of a written Subcontract Agreement between Foreman Manhattan Construction Team and the Bidder.

APPLICABLE SPECIFICATIONS:

DIVISION 00 – Foreman Manhattan's Construction Manager's Bid Manual

Complete

BID PACKAGE 01 (March 6, 2018)

DIVISION 00 – Procurement Requirements and Contracting Requirements	As Applicable
DIVISION 01 – General Requirements	As Applicable
DIVISION 03 – Concrete	As Applicable
DIVISION 31 – Earthwork	As Applicable
DIVISION 32 – Site Improvements	As Applicable
DIVISION 33 – Utilities	As Applicable
Legends, Notes and Schedules per Plans and Specifications	As Applicable
Geotechnical Engineering Report by Building & Earth Sciences, Inc. dated January 17, 2018	As Applicable

BID PACKAGE 02 (March 27, 2018)

DIVISION 07 – THERMAL AND MOISTURE PROTECTION	As Applicable
DIVISION 22 – PLUMBING	As Applicable
DIVISION 23 – HEATING, VENTING, AND AIR CONDITIONING	As Applicable
DIVISION 26 – ELECTRICAL	As Applicable
DIVISION 31 – EARTHWORK	As Applicable

BID PACKAGE 03 (April 16, 2018)

DIVISION 03 – CONCRETE	As Applicable
DIVISION 04 – MASONRY	As Applicable
DIVISION 05 – METALS	As Applicable
DIVISION 06 – WOOD, PLASTICS, AND COMPOSITES	As Applicable
DIVISION 07 – THERMAL AND MOISTURE PROTECTION	As Applicable
DIVISION 08 – OPENINGS	As Applicable
DIVISION 09 – FINISHES	As Applicable

DIVISION 10 – SPECIALTIES
DIVISION 11 – EQUIPMENT

As Applicable
As Applicable

BID PACKAGE 04 (April 20, 2018)

DIVISION 32 – EXTERIOR IMPROVEMENTS

As Applicable

BID PACKAGE 05 (May 3, 2018)

DIVISION 6 – WOODS, PLASTICS AND COMPOSITES
DIVISION 8 – OPENINGS
DIVISION 9 – FINISHES
DIVISION 10 – SPECIALTIES
DIVISION 11 – EQUIPMENT
DIVISION 22 – PLUMBING
DIVISION 23 – HEATING VENTILATING AND AIR-CONDITIONING (HVAC)
DIVISION 26 – ELECTRICAL
DIVISION 28 – ELECTRONIC SAFETY AND SECURITY

As Applicable
As Applicable

ADDENDUM #11 (June 1, 2018)

Division 10 – Specialties
10 7313 – Awnings

COMPLETE

BID PACKAGE 06 (June 22, 2018)

DIVISION 6 – WOODS, PLASTICS AND COMPOSITES
DIVISION 9 – FINISHES

As Applicable
As Applicable

Terminology:

Contractor and/or Subcontractor shall mean Scope Package Bidder.

Construction Manager (CM) shall mean Foreman Manhattan Construction Team.

SCOPE OF WORK:

Includes, but is not limited to, providing all the necessary labor, materials, tools, supplies, supervision, insurance, equipment, scaffolding, hoisting, fees, etc. necessary to provide the **Awnings at the CNE Tahlequah Casino**, Tahlequah, Oklahoma in accordance with the Contract Documents. It is further understood and agreed that this Subcontract also includes the furnishing and installation of the below listed items regardless of whether or not they are in the listed specification section(s) or any other specification section(s), or shown on the plans. This scope listing is to be used as a guideline and should not be considered as an all-inclusive list of items required to provide a complete scope of work under this proposal. Drawing and detail references are provided for reference only and are not to be considered as all-inclusive of Contract Documents for the particular items referenced. **(Please note: The word “provide” when used herein shall mean furnish and install completely, including all costs for labor, materials, equipment, hoisting, layout, scaffolding, ladders, staging, tools, rigging and any other appurtenances necessary to complete the Work”.)** Subcontractor has familiarized himself with the documents and has included those items of work shown and noted on the documents and all other equipment, devices and components that are not shown or noted, but required to provide a complete, functional and working system that is in compliance with all Federal, state and local codes.

1. Provide all pre-engineered awning systems including all framing, wall plates, fabric and accessories needed for a complete install. **Reference the attached drawing for locations of awning systems.**
2. Provide all engineering and design as per the Contract Documents including all Wind Loads per S0.1. This design is inclusive of the components, members and attachment systems required in order to provide a complete awning system.
3. Submit all design engineering documents and shop drawings for approval and review to Manhattan, Architect and Engineer prior to the commencement of their work. **The design engineering drawings and shop drawings/submittals shall be submitted within two (2) weeks from contract date as to not negatively impact the progress of this Subcontractor’s work and / or the project schedule.**
4. Provide shipping of awnings to jobsite and final installation of awnings.

GENERAL ITEMS

5. Provide all shop drawings, product data, sample and other pertinent submittals for the work of this Subcontract. Provide engineering and printing costs for all shop drawings, coordination drawings, and product submittals for architect approval as required to properly coordinate the work included in this Subcontract with other trades. Include costs for revising and resubmitting shop/ coordination drawings as needed.
6. Subcontractor will assist Foreman Manhattan with providing material quantities and cost breakdowns as required for the Owner’s and Foreman Manhattan’s budget requirements. All breakouts specified in this subcontract will be used for accounting purposes and tracking only.
7. Contractor shall provide a complete installation that complies with all applicable codes, ordinances and satisfying all Authorities Having Jurisdiction.


8. Provide all required pedestrian protection, traffic control and protection including flagman, barricades, signage, etc. as required for the work, and as may be required for protection for equipment access, deliveries and loading.
9. Subcontractor is required to comply with requirements to control Dust and Airborne Contaminants. No waste materials or debris shall be allowed to accumulate.
10. It is mutually understood and agreed that this subcontractor will coordinate all of the scheduled deliveries of these items being furnished by others with the Foreman Manhattan designated representative. This includes the on or off site storage, staging, inventory control, and shipping to the site. All damages or shortages are to be reported within 24 hours of delivery.
11. Subcontractor agrees to be bound by the Welcome Package issued by the Foreman Manhattan Field staff.
12. **Revise paragraph 1.2.3 of section 00 60 02A Manhattan General Provisions as contained in the Construction Manager's Bid manual as follows:**
Until Subcontractor's obligations under this Subcontract are completely fulfilled, Subcontractor agrees not to perform any changes to the work directly for Owner or any of its tenants, or deal directly with Owner's representatives with respect to the work and/or changes to the work, in connection with the Project, unless approved in writing by Foreman Manhattan. Foreman Manhattan understands that the Owner and specifically TERO shall communicate directly with the subcontractor to maintain a spirit of cooperation and also to utilize the TERO Job Bank to the fullest extent giving first hire priority rights to Cherokee Citizens.
13. **The Owner requirements for funding for work in progress is to provide payment less retainage of ten percent (10%), which shall be withheld and paid, without interest, upon final completion of the entire project.**
14. The terms and conditions contained in the following documents including General Provisions, Article 2.5, "Indemnification" as included within the contract documents; are incorporated herein by reference as if fully written out;
 - Foreman Manhattan General Provisions 2012
 - Exhibit A – (Scope of Work)
 - Exhibit B – (Bond Forms)
 - Exhibit C – (Insurance Requirements / Sample)
 - Exhibit D – (Contract Documents)
 - Exhibit E – (Special Conditions)
 - Exhibit F – (Project Schedule)
 - Exhibit G – Tax Exempt – O.D.P.I.
 - Exhibit H – (Foreman Manhattan Additional Safety Requirements)

SCOPE OF WORK EXCLUSIONS:


The following items are excluded from this Subcontract:

1. Tax


Sheet A2.0 EXTERIOR ELEVATIONS

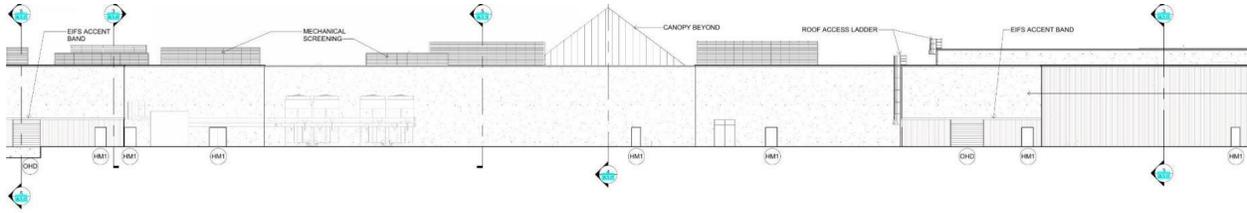

2 EXTERIOR ELEVATION
3/64" = 1'-0" EAST

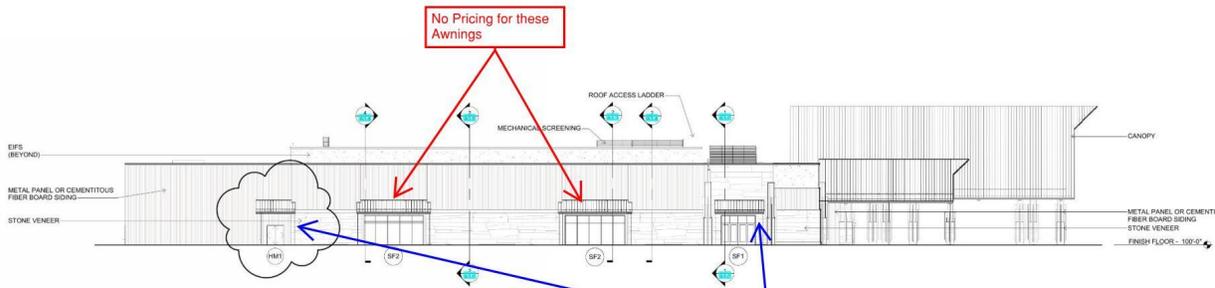

3 EXTERIOR ELEVATION
3/64" = 1'-0" NORTH

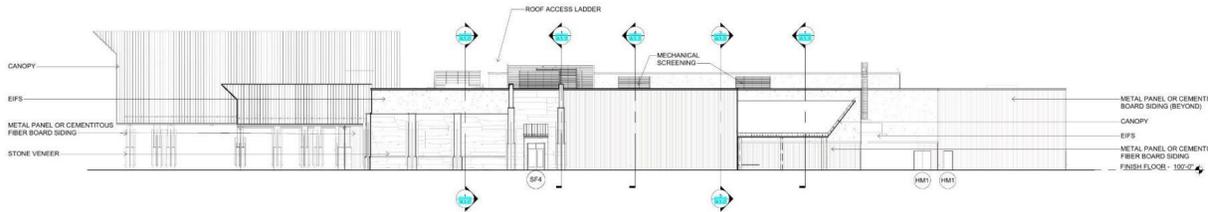

Value Analysis Suggestions:

Please write in the box below any suggestions for cost savings / value analysis which were discovered during the course of bidding this project, along with a dollar value for each item. VA Suggestions may be included in the criteria considered for successful subcontractor selection. Attach additional sheet(s) if necessary.

1. < \$_____ > Savings
Description:

2. < \$_____ > Savings
Description:

3. < \$_____ > Savings
Description:

4. < \$_____ > Savings
Description:

5. < \$_____ > Savings
Description:

BID PACKAGE – CNE Tahlequah Casino:
SCOPE PACKAGE 10.04 REV 2 – Toilet Compartments and Toilet Accessories

Submitted by (Company Name per W-9 Form): _____

Provide the following *Lump Sum Proposal* as requested in accordance with all scope items listed in Scope of Work.

BASE BID:

Toilet Compartments	\$ _____
Toilet Accessories	\$ _____
Total	\$ _____

BID ALTERNATES:

Alternate No. 1: Installation

Install all Toilet Compartments and Toilet Accessories

Alternate No. 1 – NET CHANGEADD / DEDUCT \$ _____ / LS

Other Comments:

Contact Name: _____

Address: _____

Phone/Fax: _____

Email: _____

Signature: _____

By acknowledging items below, bidder certifies acceptance of these documents and that all associated costs have been included in the proposal amount. Any and all exceptions/comments to these documents must be attached to this proposal. Comments or requested revisions to these documents will not be accepted after this proposal date.

TERO bidders must supply a copy of TERO Certificate, front of back

Initial:

Non-Collusion Affidavit

Initial:

Business Relationship Affidavit

Initial:

Acknowledge all scope of work items listed under scope of work (See Exhibit A)

Initial:

Acknowledge Exhibits B, C, D, E, F, G, H

Initial:

Addenda Included

#'s:

MCC Clarifications Included

#'s:

Acknowledge and agree to Foreman Manhattan Standard Subcontract Agreement/Special Terms and Conditions as per Exhibit E

Initial:

Acknowledge and agree to Manhattan General Provisions as Included in the Bid Documents

Initial:

SCHEDULE/EXPEDITING/SUBMITTALS

Foreman Manhattan Construction Target Schedule is attached. Please verify supplier is able to meet Foreman Manhattan required installation dates.

Initial:

Sales Tax

All bids must be submitted exclusive of Federal Excise Tax and Oklahoma State Sales Tax. The Cherokee Nation is exempt from Oklahoma State Sales Tax and Federal Excise Tax under authority of § Okla. Stat. Supp. 1994 Section 1356. Bidder is to include and pay all other applicable sales tax and use taxes as required. Applications for payment shall be broken down as required by the Owner or Construction Manager.

Specific Project Requirements for the process, approval, and payment of Owner-Direct Payment Items (ODPI) are identified in section 00 60 09:

EXHIBIT "G" Tax Exempt / Owner Direct Paid Invoice (ODPI) Payment Process

Tribal Employment Rights Office.

SUBCONTRACTOR IS TO COMPLY WITH ALL CHEROKEE NATION, TRIBAL EMPLOYMENT RIGHTS OFFICE (TERO), NATIONAL INDIAN GAMING ASSOCIATION (NIGA), AND ALL BUREAU OF INDIAN AFFAIRS (BIA) RULES, REGULATIONS, AND LICENSING REQUIREMENTS INCLUDING ALL FEES AND ASSESSMENTS, ASSESSMENT, APPLICABLE TO THIS PROJECT.

11.1.1 - TERO document "An Act" Legislative Act 01-14 dated February 10, 2014.
This Document is ACT AMENDING LA 30-12, "CHEROKEE NATION EMPLOYMENT RIGHTS ACT"

11.1.2 - Subcontractors are to EXCLUDE the cost for Section; Title 40, § 1011; T.
To assess an Employee Rights Fee of one-half (1/2) of one percent (1%) on all covered contracts. This cost will be paid by the Construction Manager.

11.1.3 - The Work Permits paragraph of the Tribal Employment Rights Office (TERO) Project Labor Agreement - Master Agreement LA 01-14 states: No person who is not a member of a federally recognized tribe shall be employed by a covered employer until he or she has obtained a work permit from the TERO at a cost of twenty-five dollars (\$25) per day, per permit. Subcontractors are to INCLUDE in their proposed price for the work, all costs associated with the twenty-five (\$25) per day work permit for every non-Indian individual employed on this project.

Performance and Payment Bond Requirements: (Subcontractor contracts Only)

Costs for performance and payment bonds **shall be included in your base bid and any applicable alternates or unit prices.** All exterior envelope Bid Packages (Trades) will be required to bond. In addition, all base bids, combination base Bid and including all alternates of \$100,000 or above will require Performance and Payment Bond equal to one hundred percent (100%) of the contract amount. Reference Section 00 60 04 – Exhibit B of the C.M. Bid Manual.

No obligation shall be incurred by the Owner or Foreman Manhattan Construction Team to any Bidder by reason of the issuance of these written instructions, by any notification relating to this bid, or by any act other than the execution of a written Subcontract Agreement between Foreman Manhattan Construction Team and the Bidder.

APPLICABLE SPECIFICATIONS:

DIVISION 00 – Foreman Manhattan’s Construction Manager’s Bid Manual	Complete
<u>BID PACKAGE 01 (March 6, 2018)</u>	
DIVISION 00 – Procurement Requirements and Contracting Requirements	As Applicable
DIVISION 01 – General Requirements	As Applicable
DIVISION 03 – Concrete	As Applicable
DIVISION 31 – EARTHWORK	As Applicable
DIVISION 32 – SITE IMPROVEMENTS	As Applicable
DIVISION 33 – UTILITIES	As Applicable
Legends, Notes and Schedules per Plans and Specifications	As Applicable
Geotechnical Engineering Report by Building & Earth Sciences, Inc. dated January 17, 2018	As Applicable
<u>BID PACKAGE 02 (March 27, 2018)</u>	
DIVISION 07 – THERMAL AND MOISTURE PROTECTION	As Applicable
DIVISION 22 – PLUMBING	As Applicable
DIVISION 23 – HEATING, VENTING, AND AIR CONDITIONING	As Applicable
DIVISION 26 – ELECTRICAL	As Applicable
DIVISION 31 – EARTHWORK	As Applicable
<u>BID PACKAGE 03 (April 16, 2018)</u>	
DIVISION 03 - CONCRETE	As Applicable

DIVISION 04 - MASONRY	As Applicable
DIVISION 05 - METALS	As Applicable
DIVISION 06 - WOOD, PLASTICS, AND COMPOSITES	As Applicable
DIVISION 07 - THERMAL AND MOISTURE PROTECTION	As Applicable
DIVISION 08 - OPENINGS	As Applicable
DIVISION 09 - FINISHES	As Applicable
DIVISION 10 - SPECIALTIES	As Applicable
DIVISION 11 - EQUIPMENT	As Applicable

BID PACKAGE 04 (April 20, 2018)

DIVISION 32 - EXTERIOR IMPROVEMENTS	As Applicable
-------------------------------------	---------------

BID PACKAGE 05 (May 3, 2018)

DIVISION 6 - WOODS, PLASTICS AND COMPOSITES	As Applicable
DIVISION 8 - OPENINGS	As Applicable
DIVISION 9 - FINISHES	As Applicable
DIVISION 10 - SPECIALTIES	COMPLETE
10 2113 PLASTIC TOILET COMPARTMENTS	As Applicable
10 2601 WALL AND CORNER GUARDS	As Applicable
10 2615 HIGH IMPACT WALL COVERING	As Applicable
10 2800 TOILET ACCESSORIES	COMPLETE
10 4400 FIRE PROTECTION SPECIALTIES	As Applicable
10 5100 LOCKERS	As Applicable
DIVISION 11 - EQUIPMENT	As Applicable
DIVISION 22 - PLUMBING	As Applicable
DIVISION 23 - HEATING VENTILATING AND AIR-CONDITIONING (HVAC)	As Applicable
DIVISION 26 - ELECTRICAL	As Applicable
DIVISION 28 - ELECTRONIC SAFETY AND SECURITY	As Applicable

BID PACKAGE 06 (June 22, 2018)

DIVISION 6 - WOODS, PLASTICS AND COMPOSITES	As Applicable
DIVISION 9 - FINISHES	As Applicable

Terminology:

Contractor and/or Subcontractor shall mean Scope Package Bidder.

Construction Manager (CM) shall mean Foreman Manhattan Construction Team.

SCOPE OF WORK:

Includes, but is not limited to, providing all the necessary labor, materials, tools, supplies, supervision, insurance, equipment, scaffolding, hoisting, fees, etc. necessary to provide the **Toilet Compartments and Toilet Accessories at the CNE Tahlequah Casino**, Tahlequah, Oklahoma in accordance with the Contract Documents. It is further understood and agreed that this Subcontract also includes the furnishing and installation of the below listed items regardless of whether or not they are in the listed specification section(s) or any other specification section(s), or shown on the plans. This scope listing is to be used as a guideline and should not be considered as an all-inclusive list of items required to provide a complete scope of work under this proposal. Drawing and detail references are provided for reference only and are not to be considered as all-inclusive of Contract Documents for the particular items referenced. **(Please note: The word "provide" when used herein shall mean furnish and install completely, including all costs for labor, materials, equipment, hoisting, layout, scaffolding, ladders, staging, tools, rigging and any other appurtenances necessary to complete the Work".)** Subcontractor has familiarized himself with the documents and has included those items of work shown and noted on the documents and all other equipment, devices and components that are not shown or noted, but required to provide a complete, functional and working system that is in compliance with all Federal, state and local codes.

1. Furnish all Plastic Toilet Compartments according to applicable drawings, notes, and documents.
2. Furnish all Toilet, Bath, & Laundry Accessories, Complete per specifications and drawings, including but not limited to:
 - a. Hand Dryers
 - b. Grab Bars
 - c. Sanitary Napkin Disposals
 - d. Sanitary Waste Receptacle
 - e. Robe Hooks
 - f. Custodial Shelves and Mop Rack
 - g. Baby Changing Station
 - h. Lighted Mirrors
3. Provide detailed drawings indicating in-wall blocking or other support requirements for installation.
4. Furnish all necessary fasteners, hardware, adhesives, and brackets required for a complete installation.

ALTERNATE

5. Provide installation of all Plastic Toilet Compartments and Toilet Accessories.
6. Provide all unloading, protecting and conveying of all Toilet Compartments and Toilet Accessories as per the Contract Documents.

GENERAL ITEMS

7. Include separate mobilizations / demobilizations as required by the Project Schedule and Phasing Plans.
8. Provide all shop drawings, product data, sample and other pertinent submittals for the work of this Subcontract. Provide engineering and printing costs for all shop drawings, coordination drawings, and product submittals for architect approval as required to properly coordinate the work included in this Subcontract with other trades. Include costs for revising and resubmitting shop/ coordination drawings as needed.
9. Subcontractor will assist Foreman Manhattan with providing material quantities and cost breakdowns as required for the Owner's and Foreman Manhattan's budget requirements. All breakouts specified in this subcontract will be used for accounting purposes and tracking only.
10. Contractor shall provide a complete installation that complies with all applicable codes, ordinances and satisfying all Authorities Having Jurisdiction.
11. Provide all field engineering and layout from benchmarks and base building control (benchmarks and baseline control is furnished by others). This Subcontractor is responsible for replacement of any damaged benchmarks, base line control or layout work of other trades/packages damaged or destroyed by the work of this work package.
12. Provide all required pedestrian protection, traffic control and protection including flagman, barricades, signage, etc. as required for the work, and as may be required for protection for equipment access, deliveries and loading.
13. Subcontractor is required to comply with requirements to control Dust and Airborne Contaminants. No waste materials or debris shall be allowed to accumulate.
14. Provide coordination, assistance, and necessary access for the Owner's furnished Testing Laboratory, including notification, obtaining samples and data gathering as required for scope of work. Costs for retesting due to failed tests and/or for Subcontractor's unpreparedness, will be paid by this Subcontractor.
15. It is mutually understood and agreed that this subcontractor will coordinate all of the scheduled deliveries of these items being furnished by others with the Foreman Manhattan designated representative. This includes the on or off site storage, staging, inventory control, and shipping to the site. All damages or shortages are to be reported within 24 hours of delivery.
16. Subcontractor agrees to be bound by the Welcome Package issued by the Foreman Manhattan Field staff.
17. **Revise paragraph 1.2.3 of section 00 60 02A Manhattan General Provisions as contained in the Construction Manager's Bid manual as follows:**
Until Subcontractor's obligations under this Subcontract are completely fulfilled, Subcontractor agrees not to perform any changes to the work directly for Owner or any of its tenants, or deal directly with Owner's representatives with respect to the work and/or changes to the work, in connection with the Project, unless approved in writing by Foreman Manhattan. Foreman Manhattan understands that the Owner and specifically TERO shall communicate directly with the subcontractor to maintain a spirit of cooperation and also to utilize the TERO Job Bank to the fullest extent giving first hire priority rights to Cherokee Citizens.
18. **The Owner requirements for funding for work in progress is to provide payment less retainage of ten percent (10%), which shall be withheld and paid, without interest, upon final completion of the entire project.**
19. The terms and conditions contained in the following documents including General Provisions, Article 2.5, "Indemnification" as included within the contract documents; are incorporated herein by reference as if fully written out;
Foreman Manhattan General Provisions 2012
Exhibit A – (Scope of Work)
Exhibit B – (Bond Forms)
Exhibit C – (Insurance Requirements / Sample)
Exhibit D – (Contract Documents)
Exhibit E – (Special Conditions)
Exhibit F – (Project Schedule)
Exhibit G – Tax Exempt – O.D.P.I.
Exhibit H – (Foreman Manhattan Additional Safety Requirements)

SCOPE OF WORK EXCLUSIONS:

The following items are excluded from this Subcontract:

1. General Building Permit.
2. Cost of Dumpsters.
3. Wood Blocking by others.

Value Analysis Suggestions:

Please write in the box below any suggestions for cost savings / value analysis which were discovered during the course of bidding this project, along with a dollar value for each item. VA Suggestions may be included in the criteria considered for successful subcontractor selection. Attach additional sheet(s) if necessary.

1. < \$_____ > Savings
Description:

2. < \$_____ > Savings
Description:

3. < \$_____ > Savings
Description:

4. < \$_____ > Savings
Description:

5. < \$_____ > Savings
Description:

BID PACKAGE – CNE Tahlequah Casino:
SCOPE PACKAGE 32.01 **REV 1** – ASPHALT PAVING (Issued with CM Clarification #013)

Submitted by (Company Name per W-9 Form): _____

Provide the following *Lump Sum Proposal* as requested in accordance with all scope items listed in Scope of Work.

BASE BID – ASPHALT PAVING:

1. Heavy Duty Asphalt Paving Per **Section A4** 02/C9.15c and Section 32 1216 / 32 1313 of the Project Specifications:

\$ _____

2. Light Duty Asphalt Paving Per **Section A8** 02/C9.15c and Section 32 1216 / 32 1313 of the Project Specifications:

\$ _____

TOTAL BASE BID (1+2):

\$ _____

BID ALTERNATES:

Alternates shall be inclusive of all required labor, materials and equipment in accordance with all general scope items listed in the Exhibit "A" Scope of Work:

Alternate No. 1:

Alternate 4 (Four) Inch Asphalt Paving Thickness for Section A8: Light Duty Flexible Paving with Structural Fill Subgrade

Provide and install 2" Base Coarse and a 2" Surface Course, for a total asphalt assembly of 4 Inches, rather than the 4.5 Inches total shown in Section A8, 02/C9.15c.

Alternate No. 1 – NET CHANGEADD / DEDUCT \$ _____ / LS

Alternate No. 2:

Alternate 5 (Five) Inch Asphalt Paving Thickness for Section A4: Heavy Duty Flexible Paving with Structural Fill Subgrade

Provide and install 3" Base Coarse and a 2" Surface Course, for a total asphalt assembly of 5 Inches, rather than the 6 Inches total shown in Section A4, 02/C9.15c.

Alternate No. 2 – NET CHANGEADD / DEDUCT \$ _____ / LS

UNIT PRICING:

UP-001: Provide aggregate base material under paving including delivery, compaction in-place, and fine grading:

\$ _____ / Cubic Yard

UP-002: Provide HEAVY DUTY asphalt paving in accordance with plan details:

\$ _____ / Square Yard

UP-003: Provide LIGHT DUTY asphalt paving in accordance with plan details:

\$ _____ / Square Yard

Other Comments:

Contact Name:

Address:

Phone/Fax:

Email:

Signature:

By acknowledging items below, bidder certifies acceptance of these documents and that all associated costs have been included in the proposal amount. Any and all exceptions/comments to these documents must be attached to this proposal. Comments or requested revisions to these documents will not be accepted after this proposal date.

TERO bidders must supply a copy of TERO Certificate, front of back	<input type="text" value="Initial:"/>
Non-Collusion Affidavit	<input type="text" value="Initial:"/>
Business Relationship Affidavit	<input type="text" value="Initial:"/>
Acknowledge all scope of work items listed under scope of work (See Exhibit A)	<input type="text" value="Initial:"/>
Acknowledge Exhibits B, C, D, E, F, G, H	<input type="text" value="Initial:"/>
Addenda Included	<input type="text" value="#s:"/>
MCC Clarifications Included	<input type="text" value="#s:"/>
Acknowledge and agree to Foreman Manhattan Standard Subcontract Agreement/Special Terms and Conditions as per Exhibit E	<input type="text" value="Initial:"/>
Acknowledge and agree to Manhattan General Provisions as Included in the Bid Documents	<input type="text" value="Initial:"/>
SCHEDULE/EXPEDITING/SUBMITTALS Foreman Manhattan Construction Target Schedule is attached. Please verify supplier is able to meet Foreman Manhattan required installation dates.	<input type="text" value="Initial:"/>

Sales Tax

All bids must be submitted exclusive of Federal Excise Tax and Oklahoma State Sales Tax. The Cherokee Nation is exempt from Oklahoma State Sales Tax and Federal Excise Tax under authority of § Okla. Stat. Supp. 1994 Section 1356. Bidder is to include and pay all other applicable sales tax and use taxes as required. Applications for payment shall be broken down as required by the Owner or Construction Manager.

Specific Project Requirements for the process, approval, and payment of Owner-Direct Payment Items (ODPI) are identified in section 00 60 09:

EXHIBIT “G” Tax Exempt / Owner Direct Paid Invoice (ODPI) Payment Process

Tribal Employment Rights Office.

SUBCONTRACTOR IS TO COMPLY WITH ALL CHEROKEE NATION, TRIBAL EMPLOYMENT RIGHTS OFFICE (TERO), NATIONAL INDIAN GAMING ASSOCIATION (NIGA), AND ALL BUREAU OF INDIAN AFFAIR'S (BIA) RULES, REGULATIONS, AND LICENSING REQUIREMENTS INCLUDING ALL FEES AND ASSESSMENTS, ASSESSMENT, APPLICABLE TO THIS PROJECT.

11.1.1 - TERO document “An Act” Legislative Act 01-14 dated February 10, 2014.
This Document is ACT AMENDING LA 30-12, "CHEROKEE NATION EMPLOYMENT RIGHTS ACT"

11.1.2 - Subcontractors are to EXCLUDE the cost for Section; Title 40, § 1011; T.
To assess an Employee Rights Fee of one-half (1/2) of one percent (1%) on all covered contracts. This cost will be paid by the Construction Manager.

11.1.3 - The Work Permits paragraph of the Tribal Employment Rights Office (TERO) Project Labor Agreement - Master Agreement LA 01-14 states: No person who is not a member of a federally recognized tribe shall be employed by a covered employer until he or she has obtained a work permit from the TERO at a cost of twenty-five dollars (\$25) per day, per permit. Subcontractors are to INCLUDE in their proposed price for the work, all costs associated with the twenty-five (\$25) per day work permit for every non-Indian individual employed on this project.

Performance and Payment Bond Requirements: (Subcontractor contracts Only)

Costs for performance and payment bonds **shall be included in your base bid and any applicable alternates or unit prices.**

All exterior envelope Bid Packages (Trades) will be required to bond. In addition, all base bids, combination base Bid and including all alternates of \$100,000 or above will require Performance and Payment Bond equal to one hundred percent (100%) of the contract amount. Reference Section 00 60 04 – Exhibit B of the C.M. Bid Manual.

No obligation shall be incurred by the Owner or Foreman Manhattan Construction Team to any Bidder by reason of the issuance of these written instructions, by any notification relating to this bid, or by any act other than the execution of a written Subcontract Agreement between Foreman Manhattan Construction Team and the Bidder.

APPLICABLE SPECIFICATIONS:

DIVISION 00 – Foreman Manhattan's Construction Manager's Bid Manual

Complete

BID PACKAGE 01 (March 6, 2018)

DIVISION 00 – Procurement Requirements and Contracting Requirements	As Applicable
DIVISION 01 – General Requirements	As Applicable
DIVISION 03 – Concrete	As Applicable
DIVISION 31 – EARTHWORK	As Applicable
DIVISION 32 – SITE IMPROVEMENTS	As Applicable
DIVISION 33 – UTILITIES	As Applicable
Legends, Notes and Schedules per Plans and Specifications	As Applicable
Geotechnical Engineering Report by Building & Earth Sciences, Inc. dated January 17, 2018	As Applicable

BID PACKAGE 02 (March 27, 2018)

DIVISION 07 – THERMAL AND MOISTURE PROTECTION	As Applicable
DIVISION 22 – PLUMBING	As Applicable
DIVISION 23 – HEATING, VENTING, AND AIR CONDITIONING	As Applicable
DIVISION 26 – ELECTRICAL	As Applicable
DIVISION 31 – EARTHWORK	As Applicable

BID PACKAGE 03 (April 16, 2018)

DIVISION 03 - CONCRETE	As Applicable
DIVISION 04 - MASONRY	As Applicable
DIVISION 05 - METALS	As Applicable
DIVISION 06 - WOOD, PLASTICS, AND COMPOSITES	As Applicable
DIVISION 07 - THERMAL AND MOISTURE PROTECTION	As Applicable
DIVISION 08 - OPENINGS	As Applicable
DIVISION 09 – FINISHES	As Applicable
DIVISION 10 – SPECIALTIES	As Applicable
DIVISION 11 - EQUIPMENT	As Applicable

BID PACKAGE 04 (April 20, 2018)

DIVISION 32 – EXTERIOR IMPROVEMENTS	As Applicable
Section 32 1216 ASPHALT PAVING	COMPLETE

BID PACKAGE 05 (May 3, 2018)

DIVISION 6 –WOODS, PLASTICS AND COMPOSITES	As Applicable
DIVISION 8 –OPENINGS	As Applicable
DIVISION 9 –FINISHES	As Applicable
DIVISION 10 –SPECIALTIES	
DIVISION 11 –EQUIPMENT	As Applicable
DIVISION 22 – PLUMBING	As Applicable
DIVISION 23 – HEATING VENTILATING AND AIR-CONDITIONING (HVAC)	As Applicable
DIVISION 26 – ELECTRICAL	As Applicable
DIVISION 28 – ELECTRONIC SAFETY AND SECURITY	As Applicable

BID PACKAGE 06 (June 22, 2018)

DIVISION 6 – WOODS, PLASTICS AND COMPOSITES	As Applicable
---------------------------------------------	---------------

DIVISION 9 – FINISHES

As Applicable

Terminology:

Contractor and/or Subcontractor shall mean Scope Package Bidder.

Construction Manager (CM) shall mean Foreman Manhattan Construction Team.

SCOPE OF WORK:

Includes, but is not limited to, providing all the necessary labor, materials, tools, supplies, supervision, insurance, equipment, scaffolding, hoisting, fees, etc. necessary to provide the **ASPHALT PAVING at the CNE Tahlequah Casino**, Tahlequah, Oklahoma in accordance with the Contract Documents. It is further understood and agreed that this Subcontract also includes the furnishing and installation of the below listed items regardless of whether or not they are in the listed specification section(s) or any other specification section(s), or shown on the plans. This scope listing is to be used as a guideline and should not be considered as an all-inclusive list of items required to provide a complete scope of work under this proposal. Drawing and detail references are provided for reference only and are not to be considered as all-inclusive of Contract Documents for the particular items referenced. **(Please note: The word “provide” when used herein shall mean furnish and install completely, including all costs for labor, materials, equipment, hoisting, layout, scaffolding, ladders, staging, tools, rigging and any other appurtenances necessary to complete the Work”.)** Subcontractor has familiarized himself with the documents and has included those items of work shown and noted on the documents and all other equipment, devices and components that are not shown or noted, but required to provide a complete, functional and working system that is in compliance with all Federal, state and local codes.

1. Provide all “Light Duty” and “Heavy Duty” asphalt paving in accordance with section 321216, Asphalt Paving as specified, indicated, and as required.
2. Subcontractor shall receive all asphalt sub-grade from others such that the **Aggregate Base shall be blue topped to +/- 1/2 of 1-inch balanced to zero** of required sub-grade elevations. Subcontractor shall adjust (add/remove) sub-grade, compact and fine grade to specified tolerances in accordance with Division 31 specifications and as required by the soils report prior to placement of pavements. (Aggregate base furnished by Earthwork contractor.)
3. Roll and compact paving as necessary to evenly surface drain run-off to storm inlets, drains, etc. Provide handwork at tight areas and around light pole bases, bollards, etc. as required to achieve smooth and uniform paved surfaces.
4. Clean pavement area of dirt, vegetation and loose debris prior to placement of asphalt and upon completion.
5. Remove and legally dispose off-site, all related waste, excess, spoil and unacceptable materials generated from work of this contract. Excess dirt and spoils removal is to be included as part of base bid.
6. Provide all field layout required.
7. There will be no escalation/de-escalation factors for Liquid asphalt (AC) in bid. Contractor is to include any and all pending and/or unanticipated increases/decreases. No adjustments will be allowed as required per schedule.
8. All contractors are to provide and include all required components for mock-ups including their installation as indicated, specified and required.
9. Provide as applicable, all Storm Water Pollution control as most specifically indicated and as required per EPA guidelines.
10. Provide in compliance with all rules and regulations, all coordination, obtaining, and payment for all permits, licenses, testing, inspections, approvals, certifications, etc. as may be required for work of this contract including all Infrastructure Development (IDP) work.
11. Contractor shall be responsible for all required daily clean-up, protection and restoration of all public and private property during the performance of Contractor’s work. Restore areas as indicated per documents and/or in accordance with jurisdictional requirements immediately following completion of the work.
12. In accordance with local jurisdictions and to the satisfaction of the Construction Manager, provide as applicable, and on a regular bases, all required street cleaning during the course of operation of this scope of work. Clean streets as required such that roadways remain clean at all times. Provide street sweeper as needed.
13. Include at no additional cost to The Project, cleaning of first coat asphalt surface after construction use, prior to installation of final top coat asphalt surface.
14. Light Duty Flexible Paving to be bid per Section A8 on 02/C9.15c – Light Duty Flexible Paving with Structural Fill Subgrade.
Heavy Duty Flexible Paving to be bid per Section A4 on 02/C9.15c – Heavy Duty Flexible Paving with Structural Fill Subgrade.

GENERAL ITEMS

15. Include separate mobilizations / demobilizations as required by the Project Schedule and Phasing Plans.
16. Provide all shop drawings, product data, sample and other pertinent submittals for the work of this Subcontract. Provide engineering and printing costs for all shop drawings, coordination drawings, and product submittals for architect approval as required to properly coordinate the work included in this Subcontract with other trades. Include costs for revising and resubmitting shop/ coordination drawings as needed.
17. Subcontractor will assist Foreman Manhattan with providing material quantities and cost breakdowns as required for the Owner’s and Foreman Manhattan’s budget requirements. All breakouts specified in this subcontract will be used for accounting purposes and tracking only.
18. Contractor shall provide a complete installation that complies with all applicable codes, ordinances and satisfying all Authorities Having Jurisdiction.
19. Provide all field engineering and layout from benchmarks and base building control (benchmarks and baseline control is furnished by others). This Subcontractor is responsible for replacement of any damaged benchmarks, base line control or layout work of other trades/packages damaged or destroyed by the work of this work package.

20. Provide all required pedestrian protection, traffic control and protection including flagman, barricades, signage, etc. as required for the work, and as may be required for protection for equipment access, deliveries and loading.
21. Subcontractor is required to comply with requirements to control Dust and Airborne Contaminants. No waste materials or debris shall be allowed to accumulate.
22. Provide coordination, assistance, and necessary access for the Owner's furnished Testing Laboratory, including notification, obtaining samples and data gathering as required for scope of work. Costs for retesting due to failed tests and/or for Subcontractor's unpreparedness, will be paid by this Subcontractor.
23. It is mutually understood and agreed that this subcontractor will coordinate all of the scheduled deliveries of these items being furnished by others with the Foreman Manhattan designated representative. This includes the on or off site storage, staging, inventory control, and shipping to the site. All damages or shortages are to be reported within 24 hours of delivery.
24. Subcontractor agrees to be bound by the Welcome Package issued by the Foreman Manhattan Field staff.
25. **Revise paragraph 1.2.3 of section 00 60 02A Manhattan General Provisions as contained in the Construction Manager's Bid manual as follows:**
Until Subcontractor's obligations under this Subcontract are completely fulfilled, Subcontractor agrees not to perform any changes to the work directly for Owner or any of its tenants, or deal directly with Owner's representatives with respect to the work and/or changes to the work, in connection with the Project, unless approved in writing by Foreman Manhattan. Foreman Manhattan understands that the Owner and specifically TERO shall communicate directly with the subcontractor to maintain a spirit of cooperation and also to utilize the TERO Job Bank to the fullest extent giving first hire priority rights to Cherokee Citizens.
26. **The Owner requirements for funding for work in progress is to provide payment less retainage of ten percent (10%), which shall be withheld and paid, without interest, upon final completion of the entire project.**
27. The terms and conditions contained in the following documents including General Provisions, Article 2.5, "Indemnification" as included within the contract documents; are incorporated herein by reference as if fully written out;
 - Foreman Manhattan General Provisions 2012
 - Exhibit A – (Scope of Work)
 - Exhibit B – (Bond Forms)
 - Exhibit C – (Insurance Requirements / Sample)
 - Exhibit D – (Contract Documents)
 - Exhibit E – (Special Conditions)
 - Exhibit F – (Project Schedule)
 - Exhibit G – Tax Exempt – O.D.P.I.
 - Exhibit H – (Foreman Manhattan Additional Safety Requirements)

SCOPE OF WORK EXCLUSIONS:

The following items are excluded from this Subcontract:

1. Aggregate base.
2. Joint Sealants.
3. Curb and gutter.
4. Concrete sidewalks.
5. Concrete, Asphalt, and Heavy Duty Pavement markings.
6. Traffic, ADA/Handicap, way finding, and site code signage.

Value Analysis Suggestions:

Please write in the box below any suggestions for cost savings / value analysis which were discovered during the course of bidding this project, along with a dollar value for each item. VA Suggestions may be included in the criteria considered for successful subcontractor selection. Attach additional sheet(s) if necessary.

1. < \$ _____ > Savings
Description:

2. < \$ _____ > Savings
Description:

3. < \$ _____ > Savings
Description:

4. < \$ _____ > Savings
Description:

5. < \$ _____ > Savings
Description:

BID PACKAGE – CNE Tahlequah Casino:
SCOPE PACKAGE 32.02 REV 1 – SITE CONCRETE (Issued with CM Clarification #13)

Submitted by (Company Name per W-9 Form): _____

Provide the following *Lump Sum Proposal* as requested in accordance with all scope items listed in Scope of Work.

BASE BID – SITE CONCRETE:

1. Proposed PC Concrete Sidewalk / Patio per 03/C9.05c and Section 32 1313 of the Project Specifications:
\$ _____

2. Heavy Duty Concrete Paving (Rigid) per 02/C9.15c and Section 32 1216 / 32 1313 of the Project Specifications:
\$ _____

3. Light Duty Concrete Paving (Rigid) per 02/C9.15c and Section 32 1216 / 32 1313 of the Project Specifications:
\$ _____

4. Reinforced Concrete Paving per 02/C9.15c and Section 32 1313 of the Project Specifications:
\$ _____

5. Curbs and Gutters:
\$ _____

6. Other Site Concrete Work;
Trickle Channels, Spillways, Retaining Walls, Rip Rap, Flumes, Sleeves, Bollards, Etc.
\$ _____

TOTAL BASE BID (Sum of 1 thru 6 above):

\$ _____

UNIT PRICING:

UP-001: Proposed Concrete Sidewalk as in Base Bid Item 1: \$ _____ / Square Foot

UP-002: Heavy Duty Concrete Paving as in Base Bid Item 2: \$ _____ / Square Yard

UP-003: Light Duty Concrete Paving as in Base Bid Item 3: \$ _____ / Square Yard

UP-004: Reinforced Concrete Paving as in Base Bid Item 4: \$ _____ / Square Yard

UP-005: Curbs and Gutters as in Base Bid Item 5: \$ _____ / Linear Foot

Other Comments:

Contact Name: _____

Address: _____

Phone/Fax: _____

Email: _____

Signature: _____

By acknowledging items below, bidder certifies acceptance of these documents and that all associated costs have been included in the proposal amount. Any and all exceptions/comments to these documents must be attached to this proposal. Comments or requested revisions to these documents will not be accepted after this proposal date.

TERO bidders must supply a copy of TERO Certificate, front of back

Initial:

Non-Collusion Affidavit

Initial:

Business Relationship Affidavit

Initial:

Acknowledge all scope of work items listed under scope of work (See Exhibit A)

Initial:

Acknowledge Exhibits B, C, D, E, F, G, H

Initial:

Addenda Included

#'s:

MCC Clarifications Included

#'s:

Acknowledge and agree to Foreman Manhattan Standard Subcontract Agreement/Special Terms and Conditions as per Exhibit E

Initial:

Acknowledge and agree to Manhattan General Provisions as Included in the Bid Documents

Initial:

SCHEDULE/EXPEDITING/SUBMITTALS

Foreman Manhattan Construction Target Schedule is attached. Please verify supplier is able to meet Foreman Manhattan required installation dates.

Initial:

Sales Tax

All bids must be submitted exclusive of Federal Excise Tax and Oklahoma State Sales Tax. The Cherokee Nation is exempt from Oklahoma State Sales Tax and Federal Excise Tax under authority of § Okla. Stat. Supp. 1994 Section 1356. Bidder is to include and pay all other applicable sales tax and use taxes as required. Applications for payment shall be broken down as required by the Owner or Construction Manager.

Specific Project Requirements for the process, approval, and payment of Owner-Direct Payment Items (ODPI) are identified in section 00 60 09:

EXHIBIT “G” Tax Exempt / Owner Direct Paid Invoice (ODPI) Payment Process

Tribal Employment Rights Office.

SUBCONTRACTOR IS TO COMPLY WITH ALL CHEROKEE NATION, TRIBAL EMPLOYMENT RIGHTS OFFICE (TERO), NATIONAL INDIAN GAMING ASSOCIATION (NIGA), AND ALL BUREAU OF INDIAN AFFAIR'S (BIA) RULES, REGULATIONS, AND LICENSING REQUIREMENTS INCLUDING ALL FEES AND ASSESSMENTS, ASSESSMENT, APPLICABLE TO THIS PROJECT.

11.1.1 - TERO document “An Act” Legislative Act 01-14 dated February 10, 2014.
This Document is ACT AMENDING LA 30-12, "CHEROKEE NATION EMPLOYMENT RIGHTS ACT"

11.1.2 - Subcontractors are to EXCLUDE the cost for Section; Title 40, § 1011; T.
To assess an Employee Rights Fee of one-half (1/2) of one percent (1%) on all covered contracts. This cost will be paid by the Construction Manager.

11.1.3 - The Work Permits paragraph of the Tribal Employment Rights Office (TERO) Project Labor Agreement - Master Agreement LA 01-14 states: No person who is not a member of a federally recognized tribe shall be employed by a covered employer until he or she has obtained a work permit from the TERO at a cost of twenty-five dollars (\$25) per day, per permit. Subcontractors are to INCLUDE in their proposed price for the work, all costs associated with the twenty-five (\$25) per day work permit for every non-Indian individual employed on this project.

Performance and Payment Bond Requirements: (Subcontractor contracts Only)

Costs for performance and payment bonds **shall be included in your base bid and any applicable alternates or unit prices.** All exterior envelope Bid Packages (Trades) will be required to bond. In addition, all base bids, combination base Bid and including all alternates of \$100,000 or above will require Performance and Payment Bond equal to one hundred percent (100%) of the contract amount. Reference Section 00 60 04 – Exhibit B of the C.M. Bid Manual.

No obligation shall be incurred by the Owner or Foreman Manhattan Construction Team to any Bidder by reason of the issuance of these written instructions, by any notification relating to this bid, or by any act other than the execution of a written Subcontract Agreement between Foreman Manhattan Construction Team and the Bidder.

APPLICABLE SPECIFICATIONS:

DIVISION 00 – Foreman Manhattan’s Construction Manager’s Bid Manual

Complete

BID PACKAGE 01 (March 6, 2018)

DIVISION 00 – Procurement Requirements and Contracting Requirements	As Applicable
DIVISION 01 – General Requirements	As Applicable
DIVISION 03 – Concrete	As Applicable
DIVISION 31 – EARTHWORK	As Applicable
DIVISION 32 – SITE IMPROVEMENTS	As Applicable
DIVISION 33 – UTILITIES	As Applicable
Legends, Notes and Schedules per Plans and Specifications	As Applicable
Geotechnical Engineering Report by Building & Earth Sciences, Inc. dated January 17, 2018	As Applicable

BID PACKAGE 02 (March 27, 2018)

DIVISION 07 – THERMAL AND MOISTURE PROTECTION	As Applicable
DIVISION 22 – PLUMBING	As Applicable
DIVISION 23 – HEATING, VENTING, AND AIR CONDITIONING	As Applicable
DIVISION 26 – ELECTRICAL	As Applicable
DIVISION 31 – EARTHWORK	As Applicable

BID PACKAGE 03 (April 16, 2018)

DIVISION 03 - CONCRETE	As Applicable
DIVISION 04 - MASONRY	As Applicable
DIVISION 05 - METALS	As Applicable
DIVISION 06 - WOOD, PLASTICS, AND COMPOSITES	As Applicable
DIVISION 07 - THERMAL AND MOISTURE PROTECTION	As Applicable
DIVISION 08 - OPENINGS	As Applicable
DIVISION 09 - FINISHES	As Applicable
DIVISION 10 - SPECIALTIES	As Applicable
DIVISION 11 - EQUIPMENT	As Applicable

BID PACKAGE 04 (April 20, 2018)

DIVISION 32 - EXTERIOR IMPROVEMENTS	As Applicable
Section 32 1313 - Concrete Paving	COMPLETE

BID PACKAGE 05 (May 3, 2018)

DIVISION 6 - WOODS, PLASTICS AND COMPOSITES	As Applicable
DIVISION 8 - OPENINGS	As Applicable
DIVISION 9 - FINISHES	As Applicable
DIVISION 10 - SPECIALTIES	
DIVISION 11 - EQUIPMENT	As Applicable
DIVISION 22 - PLUMBING	As Applicable
DIVISION 23 - HEATING VENTILATING AND AIR-CONDITIONING (HVAC)	As Applicable
DIVISION 26 - ELECTRICAL	As Applicable
DIVISION 28 - ELECTRONIC SAFETY AND SECURITY	As Applicable

BID PACKAGE 06 (June 22, 2018)

DIVISION 6 - WOODS, PLASTICS AND COMPOSITES	As Applicable
DIVISION 9 - FINISHES	As Applicable

Terminology:

Contractor and/or Subcontractor shall mean Scope Package Bidder.

Construction Manager (CM) shall mean Foreman Manhattan Construction Team.

SCOPE OF WORK:

Includes, but is not limited to, providing all the necessary labor, materials, tools, supplies, supervision, insurance, equipment, scaffolding, hoisting, fees, etc. necessary to provide the **SITE CONCRETE at the CNE Tahlequah Casino**, Tahlequah, Oklahoma in accordance with the Contract Documents. It is further understood and agreed that this Subcontract also includes the furnishing and installation of the below listed items regardless of whether or not they are in the listed specification section(s) or any other specification section(s), or shown on the plans. This scope listing is to be used as a guideline and should not be considered as an all-inclusive list of items required to provide a complete scope of work under this proposal. Drawing and detail references are provided for reference only and are not to be considered as all-inclusive of Contract Documents for the particular items referenced. **(Please note: The word "provide" when used herein shall mean furnish and install completely, including all costs for labor, materials, equipment, hoisting, layout, scaffolding, ladders, staging, tools, rigging and any other appurtenances necessary to complete the Work".)** Subcontractor has familiarized himself with the documents and has included those items of work shown and noted on the documents and all other equipment, devices and components that are not shown or noted, but required to provide a complete, functional and working system that is in compliance with all Federal, state and local codes.

1. Provide all site concrete as required by the Construction Documents. This bid package is intended to be all inclusive of labor, material, and equipment required for the site concrete work required by the contract documents for a complete project.
2. Provide all excavation, concrete, and backfill work indicated on contract documents to for all Site Concrete, including but not limited to:
 - a. Provide All sidewalks, ramps, steps, handicapped ramps with non-slip surfaces (ADA), splash blocks, etc.
 - b. Concrete associated with the cast-in-place stairs/steps, planter walls, ramps, etc.
 - c. Provide and Install all bollards. Provide all bollard footings and any specified bollard concrete fill.
 - d. All site light pole concrete bases. Install light pole anchor bolts provided by others, grout between light pole base plate and concrete base, clean and repair areas prior to grouting, and provide grout drain as required. For light poles located in paved areas, provide block-out in paving and pea gravel infill as required.
 - e. Provide Concrete Retaining Wall (Site Plan Keynotes 1.40a, 1.40b, 1.40c)
 - f. Provide Concrete Flume at Civil Area 05 from Paving Surface ONLY - All other Flumes by others (See CM Sketch Below)
 - g. Provide Concrete Cut-off Wall at Flume Termination (Site Plan Keynotes 1.90)
 - h. Provide Rip-Rap at storm water outfalls (Site Plan Keynotes 1.91a, 1.91b)

- i. **Provide Concrete Spillway (Site Plan Keynotes 1.93)**
3. Provide all fine grading, concrete, and reinforcing work for all Site Concrete Paving, including but not limited to:
 - a. All concrete pavement roadways, surface lots, and drives.
 - b. All Trickle Channels
 - c. All curbs and gutters, pavement transitions, etc. as required.
 4. Subcontractor shall receive all concrete paving sub-grade from others such that the **Aggregate Base shall be blue topped to +/- ½ of 1-inch balanced to zero** of required sub-grade elevations. Subcontractor shall adjust (add/remove) sub-grade, compact and fine grade to specified tolerances in accordance with Division 31 specifications and as required by the soils report prior to placement of pavements. (Aggregate base furnished by Earthwork contractor.)
 5. All concrete formwork including all required bracing, supports, all supplementary formwork for construction joints, depressions, box-outs, brick ledges, block outs, expansion joints, recesses, raised areas, chamfer, and all miscellaneous formwork as required by the Construction Documents.
 6. All concrete accessories including bonding agents; contraction, construction, control, expansion and isolation joints and fillers; compressible fillers, bond breakers, curing compounds, etc. as required by the Construction Documents.
 7. Provide all saw-cutting of existing and new concrete pavements as required by the Construction Documents.
 8. All related concrete reinforcing steel, dowels, wire mesh, lenton couplers, smooth dowels, grease, slip caps, form savers and required supports, bolsters, hangers, chairs, runners, spacers, etc. including all drilling, epoxy adhesives, etc. as required by the Construction Documents.
 9. Install all anchor bolts, steel assemblies, bollards, and all embedded items or anchors including required templates. All costs to correct omitted or misplaced anchor bolts or embeds shall be borne by this contractor.
 10. Provide concrete mix designs as specified. Provide all concrete materials, additives, and admixtures as required.
 11. Provide all concrete finishes as required including broomed, troweled, scored, brushed, smooth form, rubbed, grout finished, rough formed, etc. and all concrete surface repairs as indicated, specified, or required.
 12. In the event concrete is placed on the project, does not meet the tests or tolerances as specified, is found to be non-conforming by an independent laboratory, and C.M. is required to remove such non-conforming concrete, all costs of removal and replacement of this non-conforming concrete, including all removal and replacement of other work or materials related to the non-conforming concrete, shall be borne by this contractor.
 13. Provide all concrete curing and protection as required.
 14. Provide all cold or hot weather protection (for all concrete work as specified), including hot water, ice, enclosures, fog sprayers, protection, temporary heating, fire watch, etc. and maintenance therefore as necessary and required.
 15. Schedule major concrete pours through the CM.
 16. Provide self-contained waste concrete and concrete truck wash-out bins at location(s)/area(s) approved in writing by the Construction Manager and periodically cleaned and removed offsite no less than weekly, or as directed by CM. Additionally, upon completion, remove and legally dispose all concrete bins waste, excess, spoil and unacceptable materials from site and restore truck wash out area in accordance with documents and/or as acceptable to the CM.
 17. Provide all related cutting, patching and repair as required for work in accordance with documents and jurisdictional entities. Provide patching of all pavements and components whether new, existing or temporary, including curb/gutter and sidewalk in accordance with documents, Owner and CM requirements.
 18. Contractor shall be responsible to re-establish all existing grades disturbed by this work including replacement and maintenance of new sod, plantings, and irrigation systems as required at disturbed areas.
 19. Provide all traffic control measures (vehicular and pedestrian), safety and security protection as needed to complete the work. This is to include all barricades, fencing, flagging, signage, flagmen, temporary striping, removal of striping, cones, or other necessary measures required to complete the work. Coordinate with CM and Owner, and get approvals for placement locations of all items.
 20. Open excavations shall be barricaded and protected at all times as required by OSHA, all authorities having jurisdiction and the CM.
 21. All cleanup, haul-off and legal disposal of all excess rebar, formwork, pump spoil concrete and other debris resulting from work of this Subcontract.
 22. Contractor shall clean and remove all concrete spillage, drippings, laitance, dried concrete fins, etc. caused during placing of concrete or stripping of forms. All concrete work is to be broom cleaned of all debris, and broom cleaned again at completion of concrete work.
 23. Provide Sch 40 PVC Sleeves as shown on Civil Site Plans. Example: Civil Site Plans Keynotes 1.33.
 24. Provide concrete transformer pad(s); layout to be provided by Electrical Subcontractor. (Site Plan Keynote 1.37).
 25. Provide concrete generator pad(s); layout to be provided by Electrical Subcontractor. (Site Plan Keynote 1.38).
 26. Provide HVAC Equipment Pad(s); layout to be provided by HVAC Subcontractor.
 27. Provide all bollards. Example Site Plan Keynote 1.39.
 28. **Light Duty Rigid Paving to be bid per Section A7 on 02/C9.15c – Light Duty Rigid Paving with Structural Fill Subgrade.**
Heavy Duty Rigid Paving to be bid per Section A3 on 02/C9.15c – Heavy Duty Rigid Paving with Structural Fill Subgrade.
Reinforced Concrete Paving to be bid per Section A9 on 02/C9.15c – Reinforced Rigid Paving with Structural Fill Subgrade.

GENERAL ITEMS

29. Include separate mobilizations / demobilizations as required by the Project Schedule and Phasing Plans.


30. Provide all shop drawings, product data, sample and other pertinent submittals for the work of this Subcontract. Provide engineering and printing costs for all shop drawings, coordination drawings, and product submittals for architect approval as required to properly coordinate the work included in this Subcontract with other trades. Include costs for revising and resubmitting shop/ coordination drawings as needed.
31. Subcontractor will assist Foreman Manhattan with providing material quantities and cost breakdowns as required for the Owner's and Foreman Manhattan's budget requirements. All breakouts specified in this subcontract will be used for accounting purposes and tracking only.
32. Contractor shall provide a complete installation that complies with all applicable codes, ordinances and satisfying all Authorities Having Jurisdiction.
33. Provide all field engineering and layout from benchmarks and base building control (benchmarks and baseline control is furnished by others). This Subcontractor is responsible for replacement of any damaged benchmarks, base line control or layout work of other trades/packages damaged or destroyed by the work of this work package.
34. Provide all required pedestrian protection, traffic control and protection including flagman, barricades, signage, etc. as required for the work, and as may be required for protection for equipment access, deliveries and loading.
35. Subcontractor is required to comply with requirements to control Dust and Airborne Contaminants. No waste materials or debris shall be allowed to accumulate.
36. Provide coordination, assistance, and necessary access for the Owner's furnished Testing Laboratory, including notification, obtaining samples and data gathering as required for scope of work. Costs for retesting due to failed tests and/or for Subcontractor's unpreparedness, will be paid by this Subcontractor.
37. It is mutually understood and agreed that this subcontractor will coordinate all of the scheduled deliveries of these items being furnished by others with the Foreman Manhattan designated representative. This includes the on or off site storage, staging, inventory control, and shipping to the site. All damages or shortages are to be reported within 24 hours of delivery.
38. Subcontractor agrees to be bound by the Welcome Package issued by the Foreman Manhattan Field staff.
39. **Revise paragraph 1.2.3 of section 00 60 02A Manhattan General Provisions as contained in the Construction Manager's Bid manual as follows:**
Until Subcontractor's obligations under this Subcontract are completely fulfilled, Subcontractor agrees not to perform any changes to the work directly for Owner or any of its tenants, or deal directly with Owner's representatives with respect to the work and/or changes to the work, in connection with the Project, unless approved in writing by Foreman Manhattan. Foreman Manhattan understands that the Owner and specifically TERO shall communicate directly with the subcontractor to maintain a spirit of cooperation and also to utilize the TERO Job Bank to the fullest extent giving first hire priority rights to Cherokee Citizens.
40. **The Owner requirements for funding for work in progress is to provide payment less retainage of ten percent (10%), which shall be withheld and paid, without interest, upon final completion of the entire project.**
41. The terms and conditions contained in the following documents including General Provisions, Article 2.5, "Indemnification" as included within the contract documents; are incorporated herein by reference as if fully written out;
 - Foreman Manhattan General Provisions 2012
 - Exhibit A – (Scope of Work)
 - Exhibit B – (Bond Forms)
 - Exhibit C – (Insurance Requirements / Sample)
 - Exhibit D – (Contract Documents)
 - Exhibit E – (Special Conditions)
 - Exhibit F – (Project Schedule)
 - Exhibit G – Tax Exempt – O.D.P.I.
 - Exhibit H – (Foreman Manhattan Additional Safety Requirements)

SCOPE OF WORK EXCLUSIONS:

The following items are excluded from this Subcontract:

1. Building Concrete
2. Precast or cast-in-place concrete structures for site utilities
3. Joint sealants
4. Pavement Markings
5. Asphalt Paving
6. Large Concrete Flume (Civil Area 05 and 10 – see sketch below)
7. Concrete Cut-off Wall at Flume Termination (Site Plan Keynotes 1.90)
8. Rip-Rap at storm water outfalls (Site Plan Keynotes 1.91a, 1.91b)
9. Concrete Spillway (Site Plan Keynotes 1.93)

CM Sketch provided below to clarify Bid Package Scope (From Sheet C 1.05c):

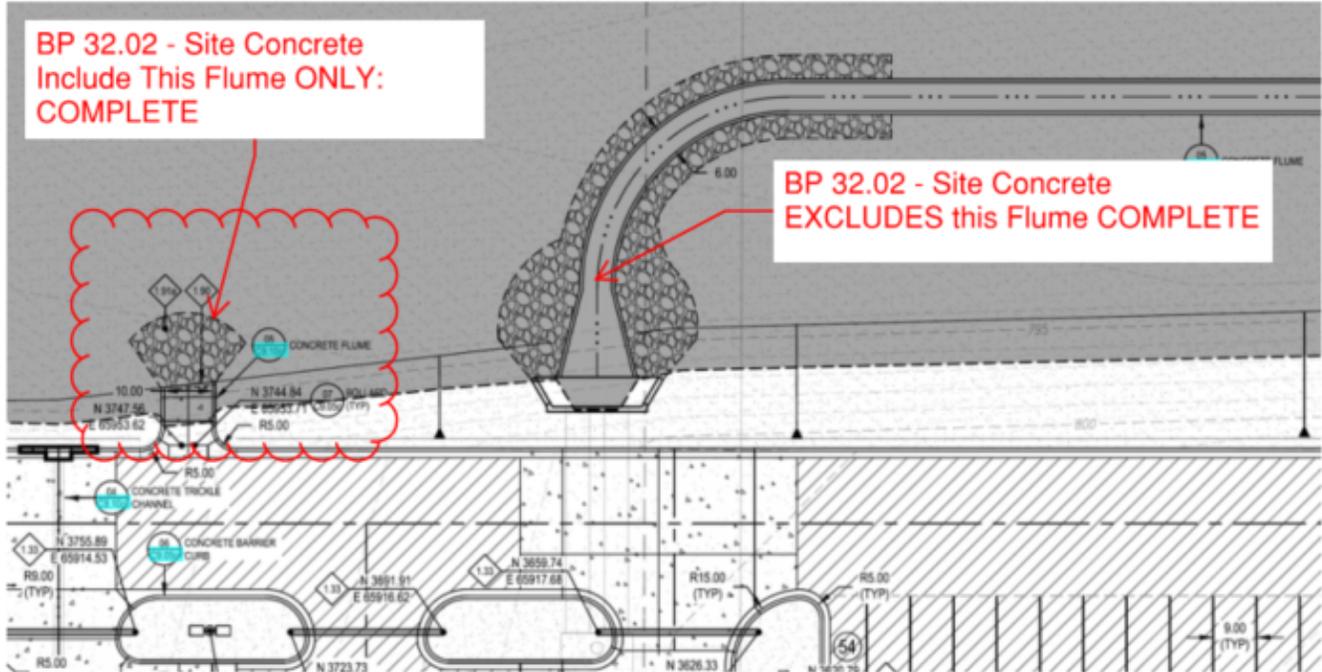

Value Analysis Suggestions:

Please write in the box below any suggestions for cost savings / value analysis which were discovered during the course of bidding this project, along with a dollar value for each item. VA Suggestions may be included in the criteria considered for successful subcontractor selection. Attach additional sheet(s) if necessary.

1. < \$ _____ > Savings
Description:

2. < \$ _____ > Savings
Description:

3. < \$ _____ > Savings
Description:

4. < \$ _____ > Savings
Description:

5. < \$ _____ > Savings
Description:

1. The Subcontract Agreement (including all attached and referenced Exhibits).
2. Manhattan General Provisions.
3. The Agreement between Manhattan and the Owner ("Agreement").
4. General Conditions of the Contract.
5. Supplementary and other Conditions.
6. Exhibits and Riders enumerated and attached to the Agreement.
7. All Addenda issued prior to and all modifications issued after execution of the Agreement.
8. Alternates as selected and incorporated herein.
9. Unit Prices.
10. Plans and Specifications as follows:

BIDDING & CONTRACTING REQUIREMENTS: Bid and Contracting Manual, as prepared by Manhattan Construction, dated April 23, 2018

GEOTECH REPORT: CNE Tahlequah Casino as prepared by Building & Earth (*Project No. OK170293*) dated January 17th, 2018

SPECIFICATIONS:

CNE Tahlequah Casino Bid Package 01: As prepared by James R. Childers dated March 6th, 2018
CNE Tahlequah Casino Bid Package 02: As prepared by James R. Childers dated March 27th, 2018
CNE Tahlequah Casino Bid Package 03: As prepared by James R. Childers dated April 16th, 2018
CNE Tahlequah Casino Bid Package 04: As prepared by James R. Childers dated April 20th, 2018
CNE Tahlequah Casino Bid Package 05: As prepared by James R. Childers dated May 3rd, 2018
CNE Tahlequah Casino Bid Package 06: As prepared by James R. Childers dated June 22nd, 2018

DRAWINGS:

CNE Tahlequah Casino Bid Package 01: As prepared by James R. Childers dated March 6th, 2018
CNE Tahlequah Casino Bid Package 02: As prepared by James R. Childers dated March 27th, 2018
CNE Tahlequah Casino Bid Package 03: As prepared by James R. Childers dated April 16th, 2018
CNE Tahlequah Casino Bid Package 04: As prepared by James R. Childers dated April 20th, 2018
CNE Tahlequah Casino Bid Package 05: As prepared by James R. Childers dated May 3rd, 2018
CNE Tahlequah Casino Bid Package 06: As prepared by James R. Childers dated June 22nd, 2018

SWPPP: CNE Tahlequah Casino as prepared by ADG dated March 6th, 2018

ADDENDA/AMENDMENTS:

Addendum #001: As prepared by James R. Childers dated April 9th, 2018
Addendum #002: As prepared by James R. Childers dated April 9th, 2018
Addendum #003: As prepared by James R. Childers dated April 16th, 2018
Addendum #004: As prepared by James R. Childers dated April 18th, 2018
Addendum #005: As prepared by James R. Childers dated April 27th, 2018
Addendum #006: As prepared by James R. Childers dated May 4th, 2018

Addendum #007: As prepared by James R. Childers dated May 8th, 2018
Addendum #008: As prepared by James R. Childers dated May 11th, 2018
Addendum #009: As prepared by James R. Childers dated May 14th, 2018
Addendum #010: As prepared by James R. Childers dated May 22nd, 2018
Addendum #011: As prepared by James R. Childers dated June 1st, 2018
Addendum #012: As prepared by James R. Childers dated June 8th, 2018
Addendum #013: As prepared by James R. Childers dated June 15th, 2018
Addendum #014: As prepared by James R. Childers dated July 11th, 2018
Addendum #015: As prepared by James R. Childers dated July 13th, 2018
Addendum #016: As prepared by James R. Childers dated July 18th, 2018
Addendum #017: As prepared by James R. Childers dated July 20th, 2018

CM CLARIFICATIONS:

CM Clarification #001:	3/27/18
CM Clarification #002:	3/28/18
CM Clarification #003:	4/6/18
CM Clarification #004:	4/9/18
CM Clarification #005:	4/16/18
CM Clarification #006:	4/19/18
CM Clarification #007:	4/25/18
CM Clarification #008:	5/7/18
CM Clarification #009:	5/23/18
CM Clarification #010:	5/25/18
CM Clarification #011:	7/11/18
CM Clarification #012:	7/16/18
CM Clarification #013:	7/25/18

***SEE ATTACHED:**

- EXHIBIT D - "CURRENT DRAWINGS" LOG, and
- EXHIBIT D - "CURRENT SPECIFICATIONS" LOG

*Logs are current through all document issues listed above (To July 25, 2018)

~ END OF EXHIBIT D ~

Current Drawings

Drawing No.	Drawing Title	Revision No.	Drawing Date	Received Date	Set
Architectural					
---	ABBREVIATIONS, SYMBOLS, & INDEX	5	06/22/2018	06/25/2018	Bid Package 06 (06/22/18)
A1.0	OVERALL FLOOR PLAN	5	07/18/2018	07/18/2018	Addendum 016 (07/18/18)
A1.1	ENLARGED FLOOR PLAN - GAMING	4	07/18/2018	07/18/2018	Addendum 016 (07/18/18)
A1.2	ENLARGED FLOOR PLAN - SOUTH	4	07/18/2018	07/18/2018	Addendum 016 (07/18/18)
A1.3	ENLARGED FLOOR PLAN - BOH	4	07/18/2018	07/18/2018	Addendum 016 (07/18/18)
A1.4	ENLARGED FLOOR PLAN - BANQUET BOH	6	07/20/2018	07/20/2018	Addendum 017 (07/20/18)
A1.5	ENLARGED FLOOR PLAN - NORTH	5	07/18/2018	07/18/2018	Addendum 016 (07/18/18)
A1.6	ENLARGED FLOOR PLAN - CANOPY	1	05/11/2018	05/11/2018	Addendum 08 (05/11/18)
A1.7	ENLARGED FLOOR PLAN - CANOPY	1	05/11/2018	05/11/2018	Addendum 08 (05/11/18)
A1.8	ENLARGED TOILET PLANS	3	07/02/2018	07/02/2018	RFI 096 (07/02/18)
A1.9	ENLARGED TOILET PLANS	3	07/02/2018	07/02/2018	RFI 096 (07/02/18)
A1.10	ENLARGED TOILET PLANS	3	07/02/2018	07/02/2018	RFI 096 (07/02/18)
A1.11	PARTITIONS TYPES	1	05/03/2018	05/03/2018	Bid Package 05 (05/03/18)
A1.12	PARTITION TYPES & DETAILS	1	05/03/2018	05/03/2018	Bid Package 05 (05/03/18)
A1.13	INTERIOR FINISH LEGEND	1	06/22/2018	06/25/2018	Bid Package 06 (06/22/18)
A2.0	EXTERIOR ELEVATIONS	3	06/01/2018	06/01/2018	Addendum 011 (06/01/18)
A2.1	TOILET ELEVATIONS	1	06/22/2018	06/25/2018	Bid Package 06 (06/22/18)
A2.2	TOILET ELEVATIONS	1	06/22/2018	06/25/2018	Bid Package 06 (06/22/18)
A2.3	TOILET ELEVATIONS	1	06/22/2018	06/25/2018	Bid Package 06 (06/22/18)
A2.4	TOILET ELEVATIONS	1	06/22/2018	06/25/2018	Bid Package 06 (06/22/18)
A2.5	TOILET & EVS ELEVATIONS	1	06/22/2018	06/25/2018	Bid Package 06 (06/22/18)
A2.6	EVS ELEVATIONS	1	06/22/2018	06/25/2018	Bid Package 06 (06/22/18)
A2.7	INTERIOR ELEVATIONS	1	06/22/2018	06/25/2018	Bid Package 06 (06/22/18)
A2.8	INTERIOR ELEVATIONS	1	06/22/2018	06/25/2018	Bid Package 06 (06/22/18)
A2.9	INTERIOR ELEVATIONS	1	06/22/2018	06/25/2018	Bid Package 06 (06/22/18)
A2.10	INTERIOR ELEVATIONS	2	07/18/2018	07/18/2018	Addendum 016 (07/18/18)
A2.11	INTERIOR ELEVATIONS	1	07/18/2018	07/18/2018	Addendum 016 (07/18/18)
A2.12	INTERIOR ELEVATIONS	1	07/18/2018	07/18/2018	Addendum 016 (07/18/18)
A2.13	INTERIOR ELEVATIONS	1	07/18/2018	07/18/2018	Addendum 016 (07/18/18)
A2.14	INTERIOR ELEVATIONS	1	07/18/2018	07/18/2018	Addendum 016 (07/18/18)
A2.15	INTERIOR ELEVATIONS	1	07/18/2018	07/18/2018	Addendum 016 (07/18/18)
A2.16	INTERIOR ELEVATIONS	1	07/18/2018	07/18/2018	Addendum 016 (07/18/18)
A2.17	INTERIOR ELEVATIONS	1	07/18/2018	07/18/2018	Addendum 016 (07/18/18)
A2.18	INTERIOR ELEVATIONS	1	07/18/2018	07/18/2018	Addendum 016 (07/18/18)
A2.19	INTERIOR ELEVATIONS	2	07/18/2018	07/18/2018	Addendum 016 (07/18/18)

Drawing No.	Drawing Title	Revision No.	Drawing Date	Received Date	Set
A2.20	INTERIOR ELEVATIONS	2	07/18/2018	07/18/2018	Addendum 016 (07/18/18)
A2.21	INTERIOR ELEVATIONS	2	07/18/2018	07/18/2018	Addendum 016 (07/18/18)
A3.0	BUILDING SECTIONS	2	05/11/2018	05/11/2018	Addendum 08 (05/11/18)
A3.1	WALL SECTIONS	1	05/03/2018	05/03/2018	Bid Package 05 (05/03/18)
A3.2	WALL SECTIONS	2	05/11/2018	05/11/2018	Addendum 08 (05/11/18)
A3.3	WALL SECTIONS	1	05/03/2018	05/03/2018	Bid Package 05 (05/03/18)
A3.4	WALL SECTIONS	1	05/03/2018	05/03/2018	Bid Package 05 (05/03/18)
A3.5	WALL SECTIONS	1	05/03/2018	05/03/2018	Bid Package 05 (05/03/18)
A3.6	WALL SECTIONS	1	05/03/2018	05/03/2018	Bid Package 05 (05/03/18)
A3.7	STAGE SECTION	3	06/22/2018	06/25/2018	Bid Package 06 (06/22/18)
A3.8	WALL SECTION DETAILS	1	05/03/2018	05/03/2018	Bid Package 05 (05/03/18)
A3.9	WALL SECTION DETAILS	2	05/22/2018	05/23/2018	Addendum 10 (05/22/18)
A3.10	CANOPY SECTIONS	2	05/11/2018	05/11/2018	Addendum 08 (05/11/18)
A3.11	CANOPY SECTIONS	2	05/11/2018	05/11/2018	Addendum 08 (05/11/18)
A3.12	CANOPY SECTION DETAILS	1	07/18/2018	07/18/2018	Addendum 016 (07/18/18)
A3.13	COLUMN DETAILS & PRECAST PROFILES	0	05/03/2018	05/03/2018	Bid Package 05 (05/03/18)
A3.14	COLUMN LIGHTING FIXTURE	0	05/03/2018	05/03/2018	Bid Package 05 (05/03/18)
A3.15	PLAN DETAILS	1	05/03/2018	05/03/2018	Bid Package 05 (05/03/18)
A3.16	STAGE SECTION	0	05/03/2018	05/03/2018	Bid Package 05 (05/03/18)
A4.0	ROOF PLAN	5	06/08/2018	06/08/2018	Addendum 012 (06/08/18)
A5.0	DOOR SCHEDULE DOOR AND WINDOW ELEVATIONS	4	07/18/2018	07/18/2018	Addendum 016 (07/18/18)
A5.1	STOREFRONT ELEVATIONS	3	07/18/2018	07/18/2018	Addendum 016 (07/18/18)
A5.2	STOREFRONT SECTIONS	1	05/03/2018	05/03/2018	Bid Package 05 (05/03/18)
A5.3	STOREFRONT DETAILS	0	05/03/2018	05/03/2018	Bid Package 05 (05/03/18)
A5.4	DOOR DETAILS	0	05/03/2018	05/03/2018	Bid Package 05 (05/03/18)
A6.0	OVERALL FLOOR COVERING PLAN	4	07/18/2018	07/18/2018	Addendum 016 (07/18/18)
A6.1	ENLARGED FLOOR COVERING PLAN - GAMING	4	07/18/2018	07/18/2018	Addendum 016 (07/18/18)
A6.2	ENLARGED FLOOR COVERING PLAN - SOUTH	4	07/18/2018	07/18/2018	Addendum 016 (07/18/18)
A6.3	ENLARGED FLOOR COVERING PLAN - BOH	4	07/18/2018	07/18/2018	Addendum 016 (07/18/18)
A6.4	ENLARGED FLOOR COVERING PLAN - BANQUET BOH	4	07/18/2018	07/18/2018	Addendum 016 (07/18/18)
A6.5	ENLARGED FLOOR COVERING PLAN - NORTH	4	07/18/2018	07/18/2018	Addendum 016 (07/18/18)
A6.10	OVERALL REFLECTED CEILING PLAN	3	07/18/2018	07/18/2018	Addendum 016 (07/18/18)
A6.11	ENLARGED REFLECTED CEILING PLAN - GAMING	4	07/18/2018	07/18/2018	Addendum 016 (07/18/18)
A6.12	ENLARGED REFLECTED CEILING PLAN - SOUTH	3	07/18/2018	07/18/2018	Addendum 016 (07/18/18)
A6.13	ENLARGED REFLECTED CEILING PLAN - BOH	3	07/18/2018	07/18/2018	Addendum 016 (07/18/18)
A6.14	ENLARGED REFLECTED CEILING PLAN - BANQUET BOH	4	07/18/2018	07/18/2018	Addendum 016 (07/18/18)
A6.15	ENLARGED REFLECTED CEILING PLAN - NORTH	4	07/18/2018	07/18/2018	Addendum 016 (07/18/18)
A6.16	CANOPY REFLECTED CEILING PLAN	0	05/03/2018	05/03/2018	Bid Package 05 (05/03/18)
A6.17	CANOPY REFLECTED CEILING PLAN	0	05/03/2018	05/03/2018	Bid Package 05 (05/03/18)

Drawing No.	Drawing Title	Revision No.	Drawing Date	Received Date	Set
A6.18	ENLARGED REFLECTED CEILING PLAN	2	06/22/2018	06/25/2018	Bid Package 06 (06/22/18)
A6.19	ENLARGED REFLECTED CEILING PLAN	0	06/22/2018	06/25/2018	Bid Package 06 (06/22/18)
A6.20	THEMING COLUMN AND CEILING DETAILS	0	06/22/2018	06/25/2018	Bid Package 06 (06/22/18)
A6.21	THEMING WALL ELEMENT	0	06/22/2018	06/25/2018	Bid Package 06 (06/22/18)
A7.0	MISCELLANEOUS DETAILS	1	05/03/2018	05/03/2018	Bid Package 05 (05/03/18)
A8.0	MILLWORK ELEVATIONS	1	06/22/2018	06/25/2018	Bid Package 06 (06/22/18)
A8.1	MILLWORK ELEVATIONS	2	07/18/2018	07/18/2018	Addendum 016 (07/18/18)
A8.2	MILLWORK ELEVATIONS	1	06/22/2018	06/25/2018	Bid Package 06 (06/22/18)
A8.3	MILLWORK SECTIONS	2	07/18/2018	07/18/2018	Addendum 016 (07/18/18)
A8.4	MILLWORK SECTIONS	1	06/22/2018	06/25/2018	Bid Package 06 (06/22/18)
A8.5	MILLWORK PLANS & ELEVATIONS	1	07/18/2018	07/18/2018	Addendum 016 (07/18/18)
A8.6	MILLWORK PLANS & ELEVATIONS	1	07/18/2018	07/18/2018	Addendum 016 (07/18/18)
A8.7	MILLWORK PLANS & ELEVATIONS	0	06/22/2018	06/25/2018	Bid Package 06 (06/22/18)
A8.8	MILLWORK PLANS & ELEVATIONS	1	07/18/2018	07/18/2018	Addendum 016 (07/18/18)
A8.9	MILLWORK PLANS & ELEVATIONS	0	06/22/2018	06/25/2018	Bid Package 06 (06/22/18)
A8.10	MILLWORK SECTIONS	1	07/18/2018	07/18/2018	Addendum 016 (07/18/18)
A8.11	MILLWORK SECTIONS	0	06/22/2018	06/25/2018	Bid Package 06 (06/22/18)
A8.12	MILLWORK PLAN DETAILS	0	06/22/2018	06/25/2018	Bid Package 06 (06/22/18)
A8.13	MILLWORK SECTIONS	0	06/22/2018	06/25/2018	Bid Package 06 (06/22/18)
A8.14	MILLWORK SECTIONS	0	06/22/2018	06/25/2018	Bid Package 06 (06/22/18)
A8.15	MILLWORK SECTIONS	0	06/22/2018	06/25/2018	Bid Package 06 (06/22/18)
A9.0	OVERALL LIFE SAFETY PLAN	0	06/01/2018	06/01/2018	Addendum 011 (06/01/18)
A10.0	EMERGENCY EGRESS PLAN	0	06/01/2018	06/01/2018	Addendum 011 (06/01/18)
A11.1	ENLARGED ACCENT COLOR PLAN	1	06/22/2018	06/25/2018	Bid Package 06 (06/22/18)
A11.2	ENLARGED ACCENT COLOR PLAN	1	06/22/2018	06/25/2018	Bid Package 06 (06/22/18)
A11.3	ENLARGED ACCENT COLOR PLAN	1	06/22/2018	06/25/2018	Bid Package 06 (06/22/18)
A11.4	ENLARGED ACCENT COLOR PLAN	1	06/22/2018	06/25/2018	Bid Package 06 (06/22/18)
A11.5	ENLARGED ACCENT COLOR PLAN	1	06/22/2018	06/25/2018	Bid Package 06 (06/22/18)
Civil					
C0.01a	INDEX AND GENERAL CONSTRUCTION NOTES	0	03/06/2018	03/06/2018	Bid Package 01 (03/06/18)
C0.01b	INDEX AND GENERAL CONSTRUCTION NOTES	1	04/16/2018		Addendum 03 (04/16/18)
C0.01c	INDEX AND GENERAL CONSTRUCTION NOTES	3	06/01/2018	06/01/2018	Addendum 011 (06/01/18)
C0.02a	PLAT OF TOPOGRAPHIC MAPPING 1 OF 2	0	03/06/2018	03/06/2018	Bid Package 01 (03/06/18)
C0.02b	PLAT OF TOPOGRAPHIC MAPPING 1 OF 2	0	03/27/2018	03/27/2018	Bid Package 02 (03/27/18)
C0.02c	PLAT OF TOPOGRAPHIC MAPPING 1 OF 2	0	04/20/2018	04/20/2018	Bid Package 04 (04/20/18)
C0.03a	PLAT OF TOPOGRAPHIC MAPPING (2 OF 2)	0	03/06/2018	03/06/2018	Bid Package 01 (03/06/18)
C0.03b	PLAT OF TOPOGRAPHIC MAPPING (2 OF 2)	0	03/27/2018	03/27/2018	Bid Package 02 (03/27/18)
C0.03c	PLAT OF TOPOGRAPHIC MAPPING 2 OF 2	0	04/20/2018	04/20/2018	Bid Package 04 (04/20/18)
C1.00a	CIVIL SITE PLAN - OVERVIEW	0	03/06/2018	03/06/2018	Bid Package 01 (03/06/18)

Drawing No.	Drawing Title	Revision No.	Drawing Date	Received Date	Set
C1.00c	CIVIL SITE PLAN - OVERVIEW	0	04/20/2018	04/20/2018	Bid Package 04 (04/20/18)
C1.02a	CIVIL SITE PLAN	0	03/06/2018	03/06/2018	Bid Package 01 (03/06/18)
C1.02c	CIVIL SITE PLAN INDEX	3	07/11/2018	07/11/2018	Addendum 014 (07/11/18)
C1.05c	CIVIL SITE PLAN - AREA 05	3	07/11/2018	07/11/2018	Addendum 014 (07/11/18)
C1.10c	CIVIL SITE PLAN - AREA 10	3	07/11/2018	07/11/2018	Addendum 014 (07/11/18)
C1.15c	CIVIL SITE PLAN - AREA 15	1	05/04/2018	05/04/2018	Addendum 006 (05/04/18)
C1.20c	CIVIL SITE PLAN - AREA 20	3	07/11/2018	07/11/2018	Addendum 014 (07/11/18)
C1.25c	CIVIL SITE PLAN - AREA 25	4	07/11/2018	07/11/2018	Addendum 014 (07/11/18)
C1.30c	CIVIL SITE PLAN - AREA 30	3	07/11/2018	07/11/2018	Addendum 014 (07/11/18)
C1.35c	CIVIL SITE PLAN - AREA 35	3	07/11/2018	07/11/2018	Addendum 014 (07/11/18)
C1.40c	CIVIL SITE PLAN - AREA 40	3	07/11/2018	07/11/2018	Addendum 014 (07/11/18)
C1.45c	CIVIL SITE PLAN - AREA 45	3	07/11/2018	07/11/2018	Addendum 014 (07/11/18)
C2.02a	UTILITY PLAN INDEX	0	03/06/2018	03/06/2018	Bid Package 01 (03/06/18)
C2.02b	UTILITY PLAN INDEX	4	07/13/2018	07/13/2018	Addendum 015 (07/13/18)
C3.02a	EROSION CONTROL PLAN	0	03/06/2018	03/06/2018	Bid Package 01 (03/06/18)
C3.02c	EROSION CONTROL PLAN	2	07/11/2018	07/11/2018	Addendum 014 (07/11/18)
C4.00c	PRE-DEVELOPMENT DRAINAGE MAP - OVERVIEW	0	04/20/2018	04/20/2018	Bid Package 04 (04/20/18)
C4.05c	POST-DEVELOPMENT DRAINAGE MAP - OVERVIEW	0	04/20/2018	04/20/2018	Bid Package 04 (04/20/18)
C4.10c	POST-DEVELOPMENT DRAINAGE MAP - INSET	0	04/20/2018	04/20/2018	Bid Package 04 (04/20/18)
C5.02b	STORM SEWER INDEX	4	07/11/2018	07/11/2018	Addendum 014 (07/11/18)
C5.05a	STORM SEWER LINE A - PLAN AND PROFILE	2	06/01/2018	06/01/2018	Addendum 011 (06/01/18)
C5.05b	STORM SEWER PROFILES	0	04/27/2018	04/27/2018	Addendum 005 (04/27/18)
C5.10a	STORM SEWER LINE A - PLAN AND PROFILE (CONT)	2	06/01/2018	06/01/2018	Addendum 011 (06/01/18)
C5.10b	STORM SEWER PROFILES	1	07/11/2018	07/11/2018	Addendum 014 (07/11/18)
C5.15b	STORM SEWER PROFILES	3	07/11/2018	07/11/2018	Addendum 014 (07/11/18)
C6.02b	SANITARY SEWER INDEX	1	04/27/2018	04/27/2018	Addendum 005 (04/27/18)
C6.05b	SANITARY SEWER PLAN AND PROFILE - LINE A	1	04/27/2018	04/27/2018	Addendum 005 (04/27/18)
C6.10b	SANITARY SEWER PLAN AND PROFILE - LINE A (CONT)	1	04/27/2018	04/27/2018	Addendum 005 (04/27/18)
C6.15b	SANITARY SEWER PLAN AND PROFILE - LINE A (CONT)	1	04/27/2018	04/27/2018	Addendum 005 (04/27/18)
C6.20b	SANITARY SEWER PLAN AND PROFILE - LINE A (CONT)	1	04/27/2018	04/27/2018	Addendum 005 (04/27/18)
C6.25b	SANITARY SEWER PLAN AND PROFILE - LINE B	1	04/27/2018	04/27/2018	Addendum 005 (04/27/18)
C6.30b	SANITARY SEWER PLAN AND PROFILE - LINE B (CONT)	1	04/27/2018	04/27/2018	Addendum 005 (04/27/18)
C6.35b	EAST SIDE SANITARY SEWER PLAN	0	04/27/2018	04/27/2018	Addendum 005 (04/27/18)
C7.02b	WATER INDEX	3	07/11/2018	07/11/2018	Addendum 014 (07/11/18)
C7.05b	WATER LINE PLAN AND PROFILE - LINE A	2	07/11/2018	07/11/2018	Addendum 014 (07/11/18)
C7.10b	WATER LINE PLAN AND PROFILE - LINE A (CONT)	1	04/27/2018	04/27/2018	Addendum 005 (04/27/18)
C7.15b	WATER LINE PLAN AND PROFILE - LINE B	1	04/27/2018	04/27/2018	Addendum 005 (04/27/18)
C7.20b	WATER LINE PLAN AND PROFILE - LINE B (CONT)	1	04/27/2018	04/27/2018	Addendum 005 (04/27/18)
C7.25b	WATER LINE PLAN AND PROFILE - LINE C	2	06/01/2018	06/01/2018	Addendum 011 (06/01/18)

Drawing No.	Drawing Title	Revision No.	Drawing Date	Received Date	Set
C7.30b	WATER LINE PLAN A AND PROFILE - LINE C (CONT)	1	04/27/2018	04/27/2018	Addendum 005 (04/27/18)
C7.35b	WATER LINE PLAN AND PROFILE - LINE D	1	04/27/2018	04/27/2018	Addendum 005 (04/27/18)
C7.40b	WATER LINE PLAN AND PROFILE - LINE D (CONT)	0	04/27/2018	04/27/2018	Addendum 005 (04/27/18)
C8.02a	ROUGH GRADING PLAN	0	03/06/2018	03/06/2018	Bid Package 01 (03/06/18)
C8.02c	FINISHED GRADING PLAN - INDEX	3	07/11/2018	07/11/2018	Addendum 014 (07/11/18)
C8.05c	FINISHED GRADING PLAN - AREA 05	1	05/04/2018	05/04/2018	Addendum 006 (05/04/18)
C8.10c	FINISHED GRADING PLAN - AREA 10	1	05/04/2018	05/04/2018	Addendum 006 (05/04/18)
C8.15c	FINISHED GRADING PLAN - AREA 15	2	07/11/2018	07/11/2018	Addendum 014 (07/11/18)
C8.20c	FINISHED GRADING PLAN - AREA 20	2	05/04/2018	05/04/2018	Addendum 006 (05/04/18)
C8.25c	FINISHED GRADING PLAN - AREA 25	2	05/04/2018	05/04/2018	Addendum 006 (05/04/18)
C8.30c	FINISHED GRADING PLAN - AREA 30	2	07/11/2018	07/11/2018	Addendum 014 (07/11/18)
C8.35c	FINISHED GRADING PLAN - AREA 35	1	05/04/2018	05/04/2018	Addendum 006 (05/04/18)
C8.40c	FINISHED GRADING PLAN - AREA 40	3	07/11/2018	07/11/2018	Addendum 014 (07/11/18)
C8.45c	FINISHED GRADING PLAN - AREA 45	2	07/11/2018	07/11/2018	Addendum 014 (07/11/18)
C9.00a	CIVIL CONSTRUCTION DETAILS	0	03/06/2018	03/06/2018	Bid Package 01 (03/06/18)
C9.00c	CIVIL CONSTRUCTION DETAILS	0	05/15/2018	05/15/2018	RFI 041 (05/15/18)
C9.05a	CIVIL CONSTRUCTION DETAILS	0	03/06/2018	03/06/2018	Bid Package 01 (03/06/18)
C9.05c	CIVIL CONSTRUCTION DETAILS	1	05/04/2018	05/04/2018	Addendum 006 (05/04/18)
C9.10a	CIVIL CONSTRUCTION DETAILS	0	04/27/2018	04/27/2018	Addendum 005 (04/27/18)
C9.10b	CIVIL CONSTRUCTION DETAILS	0	03/27/2018	03/27/2018	Bid Package 02 (03/27/18)
C9.10c	CIVIL CONSTRUCTION DETAILS	0	04/20/2018	04/20/2018	Bid Package 04 (04/20/18)
C9.15a	CIVIL CONSTRUCTION DETAILS	0	04/27/2018	04/27/2018	Addendum 005 (04/27/18)
C9.15b	CIVIL CONSTRUCTION DETAILS	0	03/27/2018	03/27/2018	Bid Package 02 (03/27/18)
C9.15c	CIVIL CONSTRUCTION DETAILS	1	05/04/2018	05/04/2018	Addendum 006 (05/04/18)
C9.16a	CIVIL CONSTRUCTION DETAILS	0	06/01/2018	06/01/2018	Addendum 011 (06/01/18)
C9.20b	CIVIL CONSTRUCTION DETAILS	0	03/27/2018	03/27/2018	Bid Package 02 (03/27/18)
C9.20c	CIVIL CONSTRUCTION DETAILS	0	04/20/2018	04/20/2018	Bid Package 04 (04/20/18)
C9.25b	CIVIL CONSTRUCTION DETAILS	0	04/16/2018		Addendum 03 (04/16/18)
C9.30b	CIVIL CONSTRUCTION DETAILS	1	04/27/2018	04/27/2018	Addendum 005 (04/27/18)
C9.35b	CIVIL CONSTRUCTION DETAILS	0	06/01/2018	06/01/2018	Addendum 011 (06/01/18)
PLAT SHEET 1 OF 2	Plat of Topographic Mapping	0	03/06/2018	03/06/2018	Bid Package 01 (03/06/18)
Cover					
-	COVER	1	03/27/2018	03/27/2018	Bid Package 02 (03/27/18)
--	COVER	3	06/22/2018	06/25/2018	Bid Package 06 (06/22/18)
Electrical					
E0.0	SYMBOL LIST	5	07/20/2018	07/20/2018	Addendum 017 (07/20/18)
E0.1	GENERAL NOTES	2	06/01/2018	06/01/2018	Addendum 011 (06/01/18)
E0.2	SINGLE LINE AND FOOD SERVICE SYSTEM NOTES	2	06/01/2018	06/01/2018	Addendum 011 (06/01/18)
E0.3	SCHEDULES	2	07/13/2018	07/13/2018	Addendum 015 (07/13/18)

Drawing No.	Drawing Title	Revision No.	Drawing Date	Received Date	Set
E0.4	ELECTRICAL DIAGRAM	1	05/03/2018	05/03/2018	Bid Package 05 (05/03/18)
E0.10	SINGLE LINE DIAGRAM - MAIN SERVICE SWITCHBOARD 'TCMSA'	5	07/20/2018	07/20/2018	Addendum 017 (07/20/18)
E0.10 - Addendum 04	SINGLE LINE DIAGRAM - MAIN SERVICE SWITCHBOARDS	0	04/18/2018	04/18/2018	Addendum 004 (04/18/18)
E0.11	PARTIAL SINGLE LINE DIAGRAM	4	07/20/2018	07/20/2018	Addendum 017 (07/20/18)
E0.12	SINGLE LINE DIAGRAM - MAIN SERVICE SWITCHBOARD TCMSB	5	07/20/2018	07/20/2018	Addendum 017 (07/20/18)
E0.13	PARTIAL SINGLE LINE DIAGRAM	5	07/20/2018	07/20/2018	Addendum 017 (07/20/18)
E0.14	PARTIAL SINGLE LINE DIAGRAM	4	07/20/2018	07/20/2018	Addendum 017 (07/20/18)
E0.15	PARTIAL SINGLE LINE DIAGRAM	1	07/20/2018	07/20/2018	Addendum 017 (07/20/18)
E0.20	PANEL SCHEDULES	3	07/20/2018	07/20/2018	Addendum 017 (07/20/18)
E0.21	PANEL SCHEDULES	4	07/20/2018	07/20/2018	Addendum 017 (07/20/18)
E0.22	PANEL SCHEDULES	2	07/13/2018	07/13/2018	Addendum 015 (07/13/18)
E0.23	PANEL SCHEDULES	2	07/20/2018	07/20/2018	Addendum 017 (07/20/18)
E0.24	PANEL SCHEDULES	3	07/20/2018	07/20/2018	Addendum 017 (07/20/18)
E0.25	PANEL SCHEDULES	2	07/20/2018	07/20/2018	Addendum 017 (07/20/18)
E0.26	PANEL SCHEDULES	3	07/20/2018	07/20/2018	Addendum 017 (07/20/18)
E0.30	DIMMER SCHEDULES	3	07/20/2018	07/20/2018	Addendum 017 (07/20/18)
E0.31	DIMMER SCHEDULES	2	07/20/2018	07/20/2018	Addendum 017 (07/20/18)
E0.40	LIGHTING FIXTURE SCHEDULE	2	05/22/2018	05/23/2018	Addendum 10 (05/22/18)
E0.41	LIGHTING FIXTURE SCHEDULE	1	07/20/2018	07/20/2018	Addendum 017 (07/20/18)
E1.0	ELECTRICAL OVERVIEW PLAN	4	07/20/2018	07/20/2018	Addendum 017 (07/20/18)
E1.1	ENLARGED POWER PLAN - GAMING	4	07/20/2018	07/20/2018	Addendum 017 (07/20/18)
E1.1A	ENLARGED POWER PLAN - EAST	1	07/13/2018	07/13/2018	Addendum 015 (07/13/18)
E1.1AM	ENLARGED MECHANICAL POWER PLAN - EAST	2	07/13/2018	07/13/2018	Addendum 015 (07/13/18)
E1.1M	ENLARGED MECHANICAL POWER PLAN - GAMING	2	07/13/2018	07/13/2018	Addendum 015 (07/13/18)
E1.2	ENLARGED POWER PLAN - SOUTH	4	07/20/2018	07/20/2018	Addendum 017 (07/20/18)
E1.2M	ENLARGED MECHANICAL POWER PLAN - SOUTH	3	07/20/2018	07/20/2018	Addendum 017 (07/20/18)
E1.3	ENLARGED POWER PLAN - BOH	3	07/20/2018	07/20/2018	Addendum 017 (07/20/18)
E1.3M	ENLARGED MECHANICAL POWER PLAN - BOH	3	07/20/2018	07/20/2018	Addendum 017 (07/20/18)
E1.4	ENLARGED POWER PLAN - BANQUET BOH	4	07/20/2018	07/20/2018	Addendum 017 (07/20/18)
E1.5	ENLARGED POWER PLAN - NORTH	3	07/20/2018	07/20/2018	Addendum 017 (07/20/18)
E1.5M	ENLARGED MECHANICAL POWER PLAN - NORTH	1	07/13/2018	07/13/2018	Addendum 015 (07/13/18)
E1.6	POWER PLAN - ROOF	2	07/20/2018	07/20/2018	Addendum 017 (07/20/18)
E3.1	ENLARGED ELECTRICAL ROOM PLAN	2	07/13/2018	07/13/2018	Addendum 015 (07/13/18)
E3.2	ENLARGED ELECTRICAL ROOM PLANS	3	07/13/2018	07/13/2018	Addendum 015 (07/13/18)
E3.3	ENLARGED PLANS	2	07/13/2018	07/13/2018	Addendum 015 (07/13/18)
E6.1	ENLARGED LIGHTING PLAN - GAMING	2	07/20/2018	07/20/2018	Addendum 017 (07/20/18)
E6.1A	ENLARGED LIGHTING PLAN - EAST	1	07/13/2018	07/13/2018	Addendum 015 (07/13/18)
E6.2	ENLARGED LIGHTING PLAN - SOUTH	2	07/20/2018	07/20/2018	Addendum 017 (07/20/18)
E6.3	ENLARGED LIGHTING PLAN - BOH	1	07/20/2018	07/20/2018	Addendum 017 (07/20/18)

Drawing No.	Drawing Title	Revision No.	Drawing Date	Received Date	Set
E6.4	ENLARGED LIGHTING PLAN - BANQUET BOH	3	07/20/2018	07/20/2018	Addendum 017 (07/20/18)
E6.5	ENLARGED LIGHTING PLAN - NORTH	3	07/20/2018	07/20/2018	Addendum 017 (07/20/18)
E7.1	ENLARGED EXTERIOR LIGHTING PLAN	2	07/13/2018	07/13/2018	Addendum 015 (07/13/18)
E7.2	ENLARGED EXTERIOR LIGHTING PLAN	1	07/13/2018	07/13/2018	Addendum 015 (07/13/18)
E7.3	ENLARGED EXTERIOR LIGHTING PLAN	2	07/13/2018	07/13/2018	Addendum 015 (07/13/18)
E7.4	ENLARGED EXTERIOR LIGHTING PLAN	2	07/13/2018	07/13/2018	Addendum 015 (07/13/18)
E7.5	ENLARGED EXTERIOR LIGHTING PLAN	1	07/13/2018	07/13/2018	Addendum 015 (07/13/18)
E7.6	ENLARGED EXTERIOR LIGHTING PLAN	2	07/13/2018	07/13/2018	Addendum 015 (07/13/18)
E7.7	ELECTRICAL ELEVATION WEST	1	07/13/2018	07/13/2018	Addendum 015 (07/13/18)
E7.8	ELECTRICAL ELEVATIONS NORTH AND SOUTH	1	07/13/2018	07/13/2018	Addendum 015 (07/13/18)
EFS112	FOODSERVICE ELECTRICAL CONNECTION PLAN	0	03/27/2018	03/27/2018	Bid Package 02 (03/27/18)
EFS113	FOODSERVICE ELECTRICAL CONNECTION PLAN	0	03/27/2018	03/27/2018	Bid Package 02 (03/27/18)
EFS115	FOODSERVICE ELECTRICAL CONNECTION PLAN	0	03/27/2018	03/27/2018	Bid Package 02 (03/27/18)
EFS120	ELECTRICAL CONNECTION PLAN	1	07/20/2018	07/20/2018	Addendum 017 (07/20/18)
EFS121	FOODSERVICE ELECTRICAL CONNECTION PLAN	2	07/20/2018	07/20/2018	Addendum 017 (07/20/18)
EFS122	FOODSERVICE ELECTRICAL CONNECTION PLAN	1	07/20/2018	07/20/2018	Addendum 017 (07/20/18)
EFS123	FOODSERVICE ELECTRICAL CONNECTION PLAN	1	07/20/2018	07/20/2018	Addendum 017 (07/20/18)
EFS124	FOODSERVICE ELECTRICAL CONNECTION PLAN	1	07/20/2018	07/20/2018	Addendum 017 (07/20/18)
ES1.0	ELECTRICAL SITE PLAN	0	07/20/2018	07/20/2018	Addendum 017 (07/20/18)
ES1.0	ELECTRICAL SITE PLAN	3	07/13/2018	07/13/2018	Addendum 015 (07/13/18)
ES1.0A	ELECTRICAL SITE PLAN - CCTV INFRASTRUCTURE	2	07/13/2018	07/13/2018	Addendum 015 (07/13/18)
ESK-002	ELECTRICAL EXHIBITS	0	03/06/2018	03/06/2018	Bid Package 01 (03/06/18)
Fire Alarm					
FA-100	FIRE ALARM LEGEND, ABBREVIATIONS & MOUNTING DETAILS	1	06/15/2018	06/15/2018	Addendum 013 (06/15/18)
FA-101	FIRST FLOOR FIRE ALARM PLAN AREA 1	1	06/15/2018	06/15/2018	Addendum 013 (06/15/18)
FA-102	FIRST FLOOR FIRE ALARM PLAN AREA 2	1	06/15/2018	06/15/2018	Addendum 013 (06/15/18)
FA-103	FIRST FLOOR FIRE ALARM PLAN AREA 3	2	07/13/2018	07/13/2018	Addendum 015 (07/13/18)
FA-104	FIRST FLOOR FIRE ALARM PLAN AREA 4	2	07/13/2018	07/13/2018	Addendum 015 (07/13/18)
FA-105	FIRST FLOOR FIRE ALARM PLAN AREA 5	2	07/13/2018	07/13/2018	Addendum 015 (07/13/18)
FA-106	FIRE ALARM PLAN RISER DIAGRAM	1	06/15/2018	06/15/2018	Addendum 013 (06/15/18)
FA-107	F.A. & EMERGENCY COMMUNICATIONS INPUT/OUTPUT MATRIX	1	06/15/2018	06/15/2018	Addendum 013 (06/15/18)
Food Service					
FS100	FOODSERVICE EQUIPMENT OVERVIEW	1	05/03/2018	05/03/2018	Bid Package 05 (05/03/18)
FS101	FOODSERVICE EQUIPMENT ARRANGEMENT PLAN	4	07/20/2018	07/20/2018	Addendum 017 (07/20/18)
FS102	FOODSERVICE EQUIPMENT ARRANGEMENT PLAN	4	07/20/2018	07/20/2018	Addendum 017 (07/20/18)
FS103	FOODSERVICE EQUIPMENT ARRANGEMENT PLAN	2	05/03/2018	05/03/2018	Bid Package 05 (05/03/18)
FS104	FOODSERVICE EQUIPMENT ARRANGEMENT PLAN	3	07/20/2018	07/20/2018	Addendum 017 (07/20/18)
FS105	FOODSERVICE EQUIPMENT ARRANGEMENT PLAN	3	06/01/2018	06/01/2018	Addendum 011 (06/01/18)
FS106	FOODSERVICE EQUIPMENT SPECIAL COND. PLAN	3	07/20/2018	07/20/2018	Addendum 017 (07/20/18)
FS107	FOODSERVICE EQUIPMENT SPECIAL COND. PLAN	4	07/20/2018	07/20/2018	Addendum 017 (07/20/18)

Drawing No.	Drawing Title	Revision No.	Drawing Date	Received Date	Set
FS108	FOODSERVICE EQUIPMENT SPECIAL COND. PLAN	3	07/20/2018	07/20/2018	Addendum 017 (07/20/18)
FS109	FOODSERVICE EQUIPMENT SPECIAL COND. PLAN	3	07/20/2018	07/20/2018	Addendum 017 (07/20/18)
FS110	FOODSERVICE EQUIPMENT SLAB-RECESS PLAN	4	07/20/2018	07/20/2018	Addendum 017 (07/20/18)
FS111	FOODSERVICE EQUIPMENT PLUMBING CONNECTION PLAN	1	05/03/2018	05/03/2018	Bid Package 05 (05/03/18)
FS112	FOODSERVICE EQUIPMENT PLUMBING CONNECTION PLAN	2	06/01/2018	06/01/2018	Addendum 011 (06/01/18)
FS113	FOODSERVICE EQUIPMENT PLUMBING CONNECTION PLAN	1	05/03/2018	05/03/2018	Bid Package 05 (05/03/18)
FS114	FOODSERVICE EQUIPMENT PLUMBING CONNECTION PLAN	2	06/01/2018	06/01/2018	Addendum 011 (06/01/18)
FS115	FOODSERVICE EQUIPMENT PRELIM. M.E.P. CONNECTION PLAN	2	06/01/2018	06/01/2018	Addendum 011 (06/01/18)
FS116	FOODSERVICE EQUIPMENT PLUMB. & MECH. CONN. SCHEDULE	1	05/03/2018	05/03/2018	Bid Package 05 (05/03/18)
FS117	FOODSERVICE EQUIPMENT MECHANICAL CONNECTION PLAN	0	05/03/2018	05/03/2018	Bid Package 05 (05/03/18)
FS118	FOODSERVICE EQUIPMENT MECHANICAL CONNECTION PLAN	0	05/03/2018	05/03/2018	Bid Package 05 (05/03/18)
FS119	FOODSERVICE EQUIPMENT MECHANICAL CONNECTION PLAN	0	05/03/2018	05/03/2018	Bid Package 05 (05/03/18)
FS120	FOODSERVICE EQUIPMENT ELECTRICAL CONNECTION PLAN	0	05/03/2018	05/03/2018	Bid Package 05 (05/03/18)
FS121	FOODSERVICE EQUIPMENT ELECTRICAL CONNECTION PLAN	2	06/01/2018	06/01/2018	Addendum 011 (06/01/18)
FS122	FOODSERVICE EQUIPMENT ELECTRICAL CONNECTION PLAN	0	05/03/2018	05/03/2018	Bid Package 05 (05/03/18)
FS123	FOODSERVICE EQUIPMENT ELECTRICAL CONNECTION PLAN	0	05/03/2018	05/03/2018	Bid Package 05 (05/03/18)
FS124	FOODSERVICE EQUIPMENT ELECTRICAL CONNECTION PLAN	0	05/03/2018	05/03/2018	Bid Package 05 (05/03/18)
FS125	FOODSERVICE EQUIPMENT ELECTRICAL CONN. SCHEDULE	2	06/01/2018	06/01/2018	Addendum 011 (06/01/18)
FS126	FOODSERVICE EQUIPMENT BEVERAGE LINE RUN PLAN	1	05/03/2018	05/03/2018	Bid Package 05 (05/03/18)
FS127	FOODSERVICE EQUIPMENT VENTILATION CONNECTION PLAN	0	05/03/2018	05/03/2018	Bid Package 05 (05/03/18)
FS128	FOODSERVICE EQUIPMENT VENTILATION CONNECTION PLAN	0	05/03/2018	05/03/2018	Bid Package 05 (05/03/18)
FS129	FOODSERVICE EQUIPMENT VENTILATION CONNECTION PLAN	0	05/03/2018	05/03/2018	Bid Package 05 (05/03/18)
FS130	FOODSERVICE EQUIPMENT VENTILATION CONNECTION PLAN	0	05/03/2018	05/03/2018	Bid Package 05 (05/03/18)
FS131	FOODSERVICE EQUIPMENT VENTILATION CONNECTION PLAN	0	05/03/2018	05/03/2018	Bid Package 05 (05/03/18)
FS132	FOODSERVICE EQUIPMENT VENTILATION CONNECTION PLAN	0	05/03/2018	05/03/2018	Bid Package 05 (05/03/18)
FS133	FOODSERVICE EQUIPMENT VENTILATION CONNECTION PLAN	0	05/03/2018	05/03/2018	Bid Package 05 (05/03/18)
FS134	FOODSERVICE EQUIPMENT VENTILATION CONNECTION PLAN	0	05/03/2018	05/03/2018	Bid Package 05 (05/03/18)
FS135	FOODSERVICE EQUIPMENT VENTILATION CONNECTION PLAN	0	05/03/2018	05/03/2018	Bid Package 05 (05/03/18)
FS136	FOODSERVICE EQUIPMENT VENTILATION CONNECTION PLAN	0	05/03/2018	05/03/2018	Bid Package 05 (05/03/18)
FS137	FOODSERVICE EQUIPMENT VENTILATION CONNECTION PLAN	0	05/03/2018	05/03/2018	Bid Package 05 (05/03/18)
FS138	FOODSERVICE EQUIPMENT VENTILATION CONNECTION PLAN	0	05/03/2018	05/03/2018	Bid Package 05 (05/03/18)
FS139	FOODSERVICE EQUIPMENT VENTILATION CONNECTION PLAN	1	07/20/2018	07/20/2018	Addendum 017 (07/20/18)
FS140	FOODSERVICE EQUIPMENT VENTILATION CONNECTION PLAN	1	07/20/2018	07/20/2018	Addendum 017 (07/20/18)
FS141	FOODSERVICE EQUIPMENT VENTILATION CONNECTION PLAN	1	07/20/2018	07/20/2018	Addendum 017 (07/20/18)
FS142	FOODSERVICE EQUIPMENT VENTILATION CONNECTION PLAN	1	07/20/2018	07/20/2018	Addendum 017 (07/20/18)
FS143	FOODSERVICE EQUIPMENT VENTILATION CONNECTION PLAN	1	05/03/2018	05/03/2018	Bid Package 05 (05/03/18)
FS201	FOODSERVICE EQUIPMENT ELEVATIONS	3	07/20/2018	07/20/2018	Addendum 017 (07/20/18)
FS501	FOODSERVICE EQUIPMENT DETAILS	2	07/20/2018	07/20/2018	Addendum 017 (07/20/18)
FS502	FOODSERVICE EQUIPMENT DETAILS	3	07/20/2018	07/20/2018	Addendum 017 (07/20/18)

Drawing No.	Drawing Title	Revision No.	Drawing Date	Received Date	Set
FS503	FOODSERVICE EQUIPMENT DETAILS	3	07/20/2018	07/20/2018	Addendum 017 (07/20/18)
FS504	FOODSERVICE EQUIPMENT DETAILS	2	07/20/2018	07/20/2018	Addendum 017 (07/20/18)
FS505	FOODSERVICE EQUIPMENT DETAILS	2	07/20/2018	07/20/2018	Addendum 017 (07/20/18)
FS506	FOODSERVICE EQUIPMENT DETAILS	1	07/20/2018	07/20/2018	Addendum 017 (07/20/18)
FS507	FOODSERVICE EQUIPMENT DETAILS	2	07/20/2018	07/20/2018	Addendum 017 (07/20/18)
FS508	FOODSERVICE EQUIPMENT DETAILS	2	07/20/2018	07/20/2018	Addendum 017 (07/20/18)
FS509	FOODSERVICE EQUIPMENT DETAILS	2	07/20/2018	07/20/2018	Addendum 017 (07/20/18)
FS510	FOODSERVICE EQUIPMENT DETAILS	3	07/20/2018	07/20/2018	Addendum 017 (07/20/18)
Interior					
ITS004C	LOW VOLTAGE CONDUIT SITE PLAN	0	07/13/2018	07/13/2018	Addendum 015 (07/13/18)
Landscape					
L1.1	LANDSCAPE PLAN	1	07/13/2018	07/13/2018	Addendum 015 (07/13/18)
L1.2	LANDSCAPE PLAN	1	07/13/2018	07/13/2018	Addendum 015 (07/13/18)
L1.3	LANDSCAPE PLAN	1	07/13/2018	07/13/2018	Addendum 015 (07/13/18)
L1.4	LANDSCAPE PLAN	1	07/13/2018	07/13/2018	Addendum 015 (07/13/18)
L1.5	LANDSCAPE PLAN	1	07/13/2018	07/13/2018	Addendum 015 (07/13/18)
L1.6	IRRIGATION NOTES AND DETAILS	1	07/13/2018	07/13/2018	Addendum 015 (07/13/18)
Low Voltage					
ITAV001	AV RACK ELEVATIONS	0	06/15/2018	06/15/2018	Addendum 013 (06/15/18)
ITAV002	WIRING DIAGRAM ETHERNET SWITCHES	0	06/15/2018	06/15/2018	Addendum 013 (06/15/18)
ITAV003	WIRING DIAGRAM DTV VIDEO SOURCES	0	06/15/2018	06/15/2018	Addendum 013 (06/15/18)
ITAV004A	WIRING DIAGRAM VIDEO DISPLAYS	0	06/15/2018	06/15/2018	Addendum 013 (06/15/18)
ITAV004B	WIRING DIAGRAM VIDEO DISPLAYS	0	06/15/2018	06/15/2018	Addendum 013 (06/15/18)
ITAV005	WIRING DIAGRAM DIGITAL SIGNAGE PLAYERS & AV CONTROL	0	06/15/2018	06/15/2018	Addendum 013 (06/15/18)
ITAV006	WIRING DIAGRAM AUDIO DSP & DISTRIBUTION	0	06/15/2018	06/15/2018	Addendum 013 (06/15/18)
ITAV007	WIRING DIAGRAM AUDIO DISTRIBUTION	2	07/18/2018	07/18/2018	Addendum 016 (07/18/18)
ITAV008	WIRING DIAGRAM BALLROOM AUDIO DISTRIBUTION	1	07/13/2018	07/13/2018	Addendum 015 (07/13/18)
ITAV009	WIRING DIAGRAM BALLROOM AV DISTRIBUTION	1	07/13/2018	07/13/2018	Addendum 015 (07/13/18)
ITAV010	WIRING DIAGRAM WIRELESS MIC SYSTEMS	0	06/15/2018	06/15/2018	Addendum 013 (06/15/18)
ITAV011	WIRING DIAGRAM STAGE AUDIO & LIGHTING	0	06/15/2018	06/15/2018	Addendum 013 (06/15/18)
ITAV012	WIRING DIAGRAM BOH CONFERENCE, VIP EVENT & DINING ROOMS	0	06/15/2018	06/15/2018	Addendum 013 (06/15/18)
ITAV013	WIRING DIAGRAM AV WALL PLATES	0	06/15/2018	06/15/2018	Addendum 013 (06/15/18)
ITAV100	AV SITE PLAN	1	07/13/2018	07/13/2018	Addendum 015 (07/13/18)
ITAV101	CEILING AV PLAN AREA 1	2	07/18/2018	07/18/2018	Addendum 016 (07/18/18)
ITAV102	CEILING AV PLAN AREA 2	0	06/15/2018	06/15/2018	Addendum 013 (06/15/18)
ITAV201	AV PLAN - AREA 1	1	07/13/2018	07/13/2018	Addendum 015 (07/13/18)
ITAV202	AV PLAN - AREA 2	1	07/13/2018	07/13/2018	Addendum 015 (07/13/18)
ITAV203	AV PLAN - AREA 3	0	06/15/2018	06/15/2018	Addendum 013 (06/15/18)
ITAV204	AV PLAN - AREA 4	0	06/15/2018	06/15/2018	Addendum 013 (06/15/18)
ITAV205	AV PLAN - AREA 5	0	06/15/2018	06/15/2018	Addendum 013 (06/15/18)

Drawing No.	Drawing Title	Revision No.	Drawing Date	Received Date	Set
ITS000A	SYMBOLS LIST AND DRAWING INDEX	1	06/15/2018	06/15/2018	Addendum 013 (06/15/18)
ITS000B	GENERAL NOTES, SPECIFICATIONS AND SCHEDULES	1	06/15/2018	06/15/2018	Addendum 013 (06/15/18)
ITS001	SECURITY PLAN DIAGRAMS	2	06/15/2018	06/15/2018	Addendum 013 (06/15/18)
ITS002	SECURITY PLAN DIAGRAMS	1	06/15/2018	06/15/2018	Addendum 013 (06/15/18)
ITS003	SECURITY PLAN DIAGRAMS	2	06/15/2018	06/15/2018	Addendum 013 (06/15/18)
ITS004A	LOW VOLTAGE CONDUIT PLAN AREA 1	3	07/13/2018	07/13/2018	Addendum 015 (07/13/18)
ITS004B	LOW VOLTAGE CONDUIT PLAN AREA 2	4	07/18/2018	07/18/2018	Addendum 016 (07/18/18)
ITS100	SECURITY SITE PLAN	2	07/13/2018	07/13/2018	Addendum 015 (07/13/18)
ITS101	FIRST FLOOR SECURITY PLAN - AREA 1	3	06/15/2018	06/15/2018	Addendum 013 (06/15/18)
ITS102	FIRST FLOOR SECURITY PLAN - AREA 2	3	06/15/2018	06/15/2018	Addendum 013 (06/15/18)
ITS103	FIRST FLOOR SECURITY PLAN - AREA 3	1	06/15/2018	06/15/2018	Addendum 013 (06/15/18)
ITS104	FIRST FLOOR SECURITY PLAN - AREA 4	2	07/18/2018	07/18/2018	Addendum 016 (07/18/18)
ITS105	FIRST FLOOR SECURITY PLAN - AREA 5	2	07/18/2018	07/18/2018	Addendum 016 (07/18/18)
ITS200A	OVERVIEW PLAN RAISED FLOOR PATHWAYS	1	06/15/2018	06/15/2018	Addendum 013 (06/15/18)
ITS200B	OVERVIEW PLAN CEILING PATHWAYS	1	06/15/2018	06/15/2018	Addendum 013 (06/15/18)
ITS200C	WAP OVERVIEW PLAN	1	06/15/2018	06/15/2018	Addendum 013 (06/15/18)
ITS201	DATA PLAN - AREA 1	2	07/18/2018	07/18/2018	Addendum 016 (07/18/18)
ITS202	DATA PLAN - AREA 2	2	07/18/2018	07/18/2018	Addendum 016 (07/18/18)
ITS203	DATA PLAN - AREA 3	1	06/15/2018	06/15/2018	Addendum 013 (06/15/18)
ITS204	DATA PLAN - AREA 4	2	07/18/2018	07/18/2018	Addendum 016 (07/18/18)
ITS205	DATA PLAN - AREA 5	2	07/18/2018	07/18/2018	Addendum 016 (07/18/18)
ITS300	ENLARGE ER 52 ELEVATIONS	1	06/15/2018	06/15/2018	Addendum 013 (06/15/18)
ITS301	ENLARGE ER 52 DIAGRAMS	1	06/15/2018	06/15/2018	Addendum 013 (06/15/18)
ITS302	ENLARGE TR 05 DIAGRAMS	1	06/15/2018	06/15/2018	Addendum 013 (06/15/18)
ITS303	ENLARGE TR 27 DIAGRAMS	1	06/15/2018	06/15/2018	Addendum 013 (06/15/18)
ITS304	ENLARGE TR 70 DIAGRAMS	1	06/15/2018	06/15/2018	Addendum 013 (06/15/18)
Mechanical					
M0.1	MECHANICAL ABBREVIATIONS AND SYMBOLS LIST	3	07/20/2018	07/20/2018	Addendum 017 (07/20/18)
M0.2	MECHANICAL SPECIFICATIONS	2	07/13/2018	07/13/2018	Addendum 015 (07/13/18)
M0.3	MECHANICAL SCHEDULES	2	07/13/2018	07/13/2018	Addendum 015 (07/13/18)
M0.4	MECHANICAL SCHEDULES	3	07/20/2018	07/20/2018	Addendum 017 (07/20/18)
M0.5	MECHANICAL SCHEDULES	3	07/20/2018	07/20/2018	Addendum 017 (07/20/18)
M0.6	MECHANICAL SCHEDULES	2	07/13/2018	07/13/2018	Addendum 015 (07/13/18)
M0.7	MECHANICAL SCHEDULES	3	07/20/2018	07/20/2018	Addendum 017 (07/20/18)
M0.8	MECHANICAL DIAGRAMS	2	07/13/2018	07/13/2018	Addendum 015 (07/13/18)
M0.9	MECHANICAL DIAGRAMS	2	07/13/2018	07/13/2018	Addendum 015 (07/13/18)
M0.10	MECHANICAL CONTROLS DIAGRAMS	2	07/13/2018	07/13/2018	Addendum 015 (07/13/18)
M0.11	MECHANICAL CONTROLS SEQUENCES	2	07/13/2018	07/13/2018	Addendum 015 (07/13/18)
M0.12	MECHANICAL CONTROLS POINTS	2	07/13/2018	07/13/2018	Addendum 015 (07/13/18)

Drawing No.	Drawing Title	Revision No.	Drawing Date	Received Date	Set
M0.13	MECHANICAL PIPING DIAGRAMS	2	07/13/2018	07/13/2018	Addendum 015 (07/13/18)
M0.14	MECHANICAL PIPING DIAGRAMS	0	07/13/2018	07/13/2018	Addendum 015 (07/13/18)
M1.0	MECHANICAL OVERALL FLOOR PLAN	2	07/13/2018	07/13/2018	Addendum 015 (07/13/18)
M1.1	MECHANICAL ENLARGED FLOOR PLAN - GAMING	3	07/20/2018	07/20/2018	Addendum 017 (07/20/18)
M1.2	MECHANICAL ENLARGED FLOOR PLAN - SOUTH	3	07/20/2018	07/20/2018	Addendum 017 (07/20/18)
M1.3	MECHANICAL ENLARGED FLOOR PLAN - BOH	2	07/13/2018	07/13/2018	Addendum 015 (07/13/18)
M1.4	MECHANICAL ENLARGED FLOOR PLAN - BANQUET BOH	3	07/20/2018	07/20/2018	Addendum 017 (07/20/18)
M1.5	MECHANICAL ENLARGED FLOOR PLAN - NORTH	3	07/20/2018	07/20/2018	Addendum 017 (07/20/18)
M4.1	MECHANICAL PIPING ENLARGED FLOOR PLAN - GAMING	3	07/20/2018	07/20/2018	Addendum 017 (07/20/18)
M4.2	MECHANICAL PIPING ENLARGED PLAN - SOUTH	3	07/20/2018	07/20/2018	Addendum 017 (07/20/18)
M4.3	MECHANICAL PIPING ENLARGED PLAN - BOH	3	07/20/2018	07/20/2018	Addendum 017 (07/20/18)
M4.4	MECHANICAL PIPING ENLARGED PLAN - BANQUET BOH	3	07/20/2018	07/20/2018	Addendum 017 (07/20/18)
M4.5	MECHANICAL PIPING ENLARGED PLAN - NORTH	2	07/13/2018	07/13/2018	Addendum 015 (07/13/18)
M6.1	MECHANICAL ROOF PLAN	3	07/20/2018	07/20/2018	Addendum 017 (07/20/18)
MSK-001	MECHANICAL SCHEDULES	0	03/06/2018	03/06/2018	Bid Package 01 (03/06/18)
MSK-002	MECHANICAL ROOF PLAN	0	03/06/2018	03/06/2018	Bid Package 01 (03/06/18)
Plumbing					
P0.1	PLUMBING ABBREVIATIONS AND SYMBOLS LIST	2	07/20/2018	07/20/2018	Addendum 017 (07/20/18)
P0.2	PLUMBING SPECIFICATIONS	1	05/22/2018	05/23/2018	Addendum 10 (05/22/18)
P0.3	PLUMBING SCHEDULES	2	07/20/2018	07/20/2018	Addendum 017 (07/20/18)
P0.5	PLUMBING DIAGRAMS	1	05/22/2018	05/23/2018	Addendum 10 (05/22/18)
P0.6	GAS ISOMETRIC DIAGRAM	2	07/20/2018	07/20/2018	Addendum 017 (07/20/18)
P1.0	PLUMBING OVERALL FLOOR PLAN	1	05/22/2018	05/23/2018	Addendum 10 (05/22/18)
P1.01	PLUMBING SITE PLAN	2	07/20/2018	07/20/2018	Addendum 017 (07/20/18)
P1.1	PLUMBING ENLARGED FLOOR PLAN - GAMING	2	07/20/2018	07/20/2018	Addendum 017 (07/20/18)
P1.2	PLUMBING ENLARGED FLOOR PLAN - SOUTH	2	07/20/2018	07/20/2018	Addendum 017 (07/20/18)
P1.3	PLUMBING ENLARGED FLOOR PLAN - BOH	2	07/20/2018	07/20/2018	Addendum 017 (07/20/18)
P1.4	PLUMBING ENLARGED FLOOR PLAN - BANQUET BOH	2	07/20/2018	07/20/2018	Addendum 017 (07/20/18)
P1.5	PLUMBING ENLARGED FLOOR PLAN - NORTH	1	05/22/2018	05/23/2018	Addendum 10 (05/22/18)
P1.6	PLUMBING ENLARGED PLANS - WATER & GAS	1	05/22/2018	05/23/2018	Addendum 10 (05/22/18)
P1.7	PLUMBING ENLARGED PLANS - WATER & GAS	1	05/22/2018	05/23/2018	Addendum 10 (05/22/18)
P1.8	PLUMBING ENLARGED PLANS - DW & V	1	05/22/2018	05/23/2018	Addendum 10 (05/22/18)
P1.9	PLUMBING ENLARGED PLANS - DW & V	1	05/22/2018	05/23/2018	Addendum 10 (05/22/18)
P6.1	PLUMBING ROOF PLAN	2	07/20/2018	07/20/2018	Addendum 017 (07/20/18)
PFS.101	PLUMBING FOOD SERVICE WASTE & VENT PLAN - CASINO BAR & EDR	3	07/20/2018	07/20/2018	Addendum 017 (07/20/18)
PFS.102	PLUMBING FOOD SERVICE WASTE & VENT PLAN - GRAB-N-GO KITCHEN	2	07/20/2018	07/20/2018	Addendum 017 (07/20/18)
PFS.103	PLUMBING FOOD SERVICE WASTE & VENT PLAN - BANQUET KITCHEN	3	07/20/2018	07/20/2018	Addendum 017 (07/20/18)
PFS.104	PLUMBING FOOD SERVICE WASTE & VENT PLAN - WAREHOUSE	2	07/20/2018	07/20/2018	Addendum 017 (07/20/18)
PFS.105	PLUMBING FOOD SERVICE WASTE & VENT PLAN - FINE DINING	2	07/20/2018	07/20/2018	Addendum 017 (07/20/18)

Drawing No.	Drawing Title	Revision No.	Drawing Date	Received Date	Set
PFS.106	PLUMBING FOOD SERVICE WATER & GAS PLAN - CASINO BAR & EDR	2	07/20/2018	07/20/2018	Addendum 017 (07/20/18)
PFS.107	PLUMBING FOOD SERVICE WATER & GAS PLAN - GRAB-N-GO KITCHEN	2	07/20/2018	07/20/2018	Addendum 017 (07/20/18)
PFS.108	PLUMBING FOOD SERVICE WATER & GAS PLAN - BANQUET KITCHEN	3	07/20/2018	07/20/2018	Addendum 017 (07/20/18)
PFS.109	PLUMBING FOOD SERVICE WATER & GAS PLAN - FINE DINING	2	07/20/2018	07/20/2018	Addendum 017 (07/20/18)
PU0.0	PLUMBING COVERSHEET AND SHEET INDEX	2	04/27/2018	04/27/2018	RFI 21-22-23 (04/27/18)
PU1.1	PLUMBING ENLARGED UNDERSLAB PLAN - GAMING	3	04/27/2018	04/27/2018	RFI 21-22-23 (04/27/18)
PU1.2	PLUMBING ENLARGED UNDERSLAB PLAN - SOUTH	3	04/27/2018	04/27/2018	RFI 21-22-23 (04/27/18)
PU1.3	PLUMBING ENLARGED UNDERSLAB PLAN - BOH	3	04/27/2018	04/27/2018	RFI 21-22-23 (04/27/18)
PU1.4	PLUMBING ENLARGED UNDERSLAB PLAN - BANQUET BOH	3	04/27/2018	04/27/2018	RFI 21-22-23 (04/27/18)
PU1.5	PLUMBING ENLARGED UNDERSLAB PLAN - NORTH	3	04/27/2018	04/27/2018	RFI 21-22-23 (04/27/18)
Structural					
S0.1	STRUCTURAL NOTES	3	05/11/2018	05/11/2018	Addendum 08 (05/11/18)
S0.2	SPECAIL INSPECTIONS	0	05/08/2018	05/08/2018	Addendum 007 (05/08/18)
S1.1	FOUNDATION PLAN OVERALL	2	06/15/2018	06/15/2018	Addendum 013 (06/15/18)
S1.2	FOUNDATION PLAN AREA A	3	05/08/2018	05/08/2018	Addendum 007 (05/08/18)
S1.3	FOUNDATION PLAN AREA B	7	06/15/2018	06/15/2018	Addendum 013 (06/15/18)
S1.4	FOUNDATION PLAN AREA C	7	06/15/2018	06/15/2018	Addendum 013 (06/15/18)
S1.5	SAFER ROOM FOUNDATION PLANS	3	05/11/2018	05/11/2018	Addendum 08 (05/11/18)
S1.6	FOUNDATION DETAILS	2	05/22/2018	05/23/2018	Addendum 10 (05/22/18)
S1.7	FOUNDATION DETAILS	1	05/08/2018	05/08/2018	Addendum 007 (05/08/18)
S1.8	PORTE COCHERE FOUNDATION PLANS	3	05/22/2018	05/23/2018	Addendum 10 (05/22/18)
S2.1	SLAB PLAN	7	07/20/2018	07/20/2018	Addendum 017 (07/20/18)
S2.2	SLAB BUMPOUT PLANS	0	05/22/2018	05/23/2018	Addendum 10 (05/22/18)
S3.1	ROOF FRAMING PLANS	6	06/15/2018	06/15/2018	Addendum 013 (06/15/18)
S3.2	ROOF FRAMING PLANS	7	06/08/2018	06/08/2018	Addendum 012 (06/08/18)
S3.3	ROOF FRAMING PLAN	6	06/08/2018	06/08/2018	Addendum 012 (06/08/18)
S3.4	SAFER ROOMS FRAMING PLANS	1	04/05/2018	04/05/2018	Addendum 001 Revised (04/05/18)
S3.5	SNOW DRIFT PLAN	1	06/15/2018	06/15/2018	Addendum 013 (06/15/18)
S3.6	STAGE PLANS	1	07/11/2018	07/11/2018	Addendum 014 (07/11/18)
S3.7	PORTE COCHERE FRAMING PLAN	1	05/11/2018	05/11/2018	Addendum 08 (05/11/18)
S3.8	PORTE COCHERE FRAMING PLAN	2	05/22/2018	05/23/2018	Addendum 10 (05/22/18)
S4.1	BUILDING SECTIONS	1	04/05/2018	04/05/2018	Addendum 001 Revised (04/05/18)
S4.2	FRAME ELEVATIONS	2	05/08/2018	05/08/2018	Addendum 007 (05/08/18)
S4.3	FRAME ELEVATIONS	3	05/08/2018	05/08/2018	Addendum 007 (05/08/18)
S4.4	PORTE COCHERE SECTIONS	1	05/11/2018	05/11/2018	Addendum 08 (05/11/18)
S4.5	PORTE COCHERE SECTIONS	1	05/11/2018	05/11/2018	Addendum 08 (05/11/18)
S4.6	PORTE COCHERE SECTIONS	1	05/11/2018	05/11/2018	Addendum 08 (05/11/18)
S4.7	PORTE COCHERE SECTIONS	2	05/14/2018	05/14/2018	Addendum 009 (05/14/18)
S4.8	PORTE COCHERE SECTIONS	2	05/14/2018	05/14/2018	Addendum 009 (05/14/18)

Drawing No.	Drawing Title	Revision No.	Drawing Date	Received Date	Set
S4.9	JOIST GIRDER LOADINGS	0	06/08/2018	06/08/2018	Addendum 012 (06/08/18)
S5.1	STRUCTURAL DETAILS	2	05/11/2018	05/11/2018	Addendum 08 (05/11/18)
S5.2	STRUCTURAL DETAILS	1	05/14/2018	05/14/2018	Addendum 009 (05/14/18)
S5.3	STRUCTURAL DETAILS	1	05/14/2018	05/14/2018	Addendum 009 (05/14/18)

Current Specifications

Number	Description	Revision	Issued Date	Received Date	Set
00 - Procurement and Contracting Requirements					
00 0102	PROJECT INFORMATION	0	03/06/18	03/06/18	Bid Package 01
00 0105	GEOTECHNICAL DATA	0	03/06/18	03/06/18	Bid Package 01
00 3105	FIRE PROTECTION REPORT	0	05/04/18	05/04/18	Addendum 006
00 7200	General Requirements and Conditions	0	06/01/18	06/01/18	Addendum 011
000110	Table of Contents	5	06/22/18	06/25/18	Bid Package 06
01 - General Requirements					
01 2000	Price and Payment Procedures	0	06/01/18	06/01/18	Addendum 011
01 2300	Alternates	0	06/01/18	06/01/18	Addendum 011
01 3000	Administrative Requirements	0	06/01/18	06/01/18	Addendum 011
01 3216	Construction Progress Schedule	0	06/01/18	06/01/18	Addendum 011
01 4000	Quality Requirements	0	06/01/18	06/01/18	Addendum 011
01 5000	Temporary Facilities and Controls	0	06/01/18	06/01/18	Addendum 011
01 5713	Temporary Erosion and Sediment Control	0	06/01/18	06/01/18	Addendum 011
01 5813	Temporary Project Signage	0	06/01/18	06/01/18	Addendum 011
01 6000	Product Requirements	0	06/01/18	06/01/18	Addendum 011
01 6250	Substitution Request Form	0	06/01/18	06/01/18	Addendum 011
01 7000	Execution and Closeout Requirements	0	06/01/18	06/01/18	Addendum 011
01 7800	Closeout Submittals	0	06/01/18	06/01/18	Addendum 011
03 - Concrete					
03 30 00	CAST-IN-PLACE CONCRETE	0	03/06/18	03/06/18	Bid Package 01
03 4500	PRECAST ARCHITECTURAL CONCRETE	0	04/16/18	04/16/18	Bid Package 03
04 - Masonry					
04 2200	Concrete Unit Masonry	0	04/27/18	04/27/18	Addendum 005
04 4301	STONE MASONRY VENEER	0	04/16/18	04/16/18	Bid Package 03
05 - Metals					
05 1200	STRUCTURAL STEEL FRAMING	1	04/27/18	04/27/18	Addendum 005
05 5150	FIXED METAL LADDERS	0	04/16/18	04/16/18	Bid Package 03
06 - Wood, Plastics, and Composites					
06 1000	ROUGH CARPENTRY	0	04/16/18	04/16/18	Bid Package 03
06 1110	WOOD BLOCKING AND CURBING	0	04/16/18	04/16/18	Bid Package 03
06 2000	FINISH CARPENTRY	0	05/03/18	05/07/18	Bid Package 05
06 4100	ARCHITECTURAL WOOD CASEWORK	0	05/03/18	05/07/18	Bid Package 05
06 6100	SIMULATED STONE FABRICATIONS	1	06/22/18	06/25/18	Bid Package 06
06 8300	HIGH PRESSURE DECORATIVE LAMINATES PLASTIC PANELS METAL PANELS & LAMINATED PANELS	1	06/22/18	06/25/18	Bid Package 06

Number	Description	Revision	Issued Date	Received Date	Set
07 - Thermal and Moisture Protection					
07 1300	SHEET WATERPROOFING	0	03/27/18	03/27/18	Bid Package 02
07 1310	WATER REPELLENTS	0	04/16/18	04/16/18	Bid Package 03
07 2100	THERMAL INSULATION	1	04/16/18	04/16/18	Bid Package 03
07 2119	FOAMED-IN-PLACE INSULATION	0	04/16/18	04/16/18	Bid Package 03
07 2120	POLYISOCYANURATE INSULATION	0	04/16/18	04/16/18	Bid Package 03
07 2400	EXTERIOR INSULATION AND FINISH SYSTEMS	0	04/16/18	04/16/18	Bid Package 03
07 2510	FLUID APPLIED VAPOR PERMEABLE AIR BARRIER MEMBRANE	0	04/16/18	04/16/18	Bid Package 03
07 4113	METAL ROOF PANELS	0	04/16/18	04/16/18	Bid Package 03
07 4213	METAL WALL PANELS	0	04/16/18	04/16/18	Bid Package 03
07 4600	FIBER CEMENT SIDING	0	04/16/18	04/16/18	Bid Package 03
07 5200	MODIFIED BITUMINOUS MEMBRANE ROOFING	0	04/16/18	04/16/18	Bid Package 03
07 6200	SHEET METAL FLASHING AND TRIM	0	04/16/18	04/16/18	Bid Package 03
07 8100	APPLIED FIREPROOFING	1	05/08/18	05/08/18	Addendum 007
07 8400	FIRESTOPPING	0	04/16/18	04/16/18	Bid Package 03
07 9000	JOINT SEALERS	0	04/16/18	04/16/18	Bid Package 03
08 - Openings					
08 1113	HOLLOW METAL DOORS AND FRAMES	0	04/16/18	04/16/18	Bid Package 03
08 1416	FLUSH WOOD DOORS	0	05/03/18	05/07/18	Bid Package 05
08 3100	ACCESS DOORS & PANELS	0	05/03/18	05/07/18	Bid Package 05
08 3313	COILING COUNTER DOORS	0	05/03/18	05/07/18	Bid Package 05
08 3323	OVERHEAD COILING DOORS	0	04/16/18	04/16/18	Bid Package 03
08 4229	AUTOMATIC ENTRANCES	0	04/16/18	04/16/18	Bid Package 03
08 4233	REVOLVING DOOR ENTRANCES	1	06/15/18	06/15/18	Addendum 013
08 4300	ALUMINUM STOREFRONT ENTRANCES	0	04/16/18	04/16/18	Bid Package 03
08 4310	ALUMINUM STOREFRONT WINDOW SYSTEMS	0	04/16/18	04/16/18	Bid Package 03
08 4400	GLAZED ALUMINUM CURTAIN WALL SYSTEMS	0	04/16/18	04/16/18	Bid Package 03
08 7100	Door Hardware	2	06/01/18	06/01/18	Addendum 011
08 8150	GLASS	0	04/16/18	04/16/18	Bid Package 03
09 - Finishes					
09 2116	GYPSUM BOARD ASSEMBLIES	1	05/08/18	05/08/18	Addendum 007
09 3050	TILE	1	06/22/18	06/25/18	Bid Package 06
09 5100	Acoustical Ceilings	2	04/27/18	04/27/18	Addendum 005
09 6500	RESILIENT FLOORING & BASE	1	06/22/18	06/25/18	Bid Package 06
09 6813	TILE CARPETING	1	06/22/18	06/25/18	Bid Package 06
09 6900	ACCESS FLOORING	0	05/03/18	05/07/18	Bid Package 05
09 7200	Wall Coverings	0	06/22/18	06/25/18	Bid Package 06
09 9000	PAINTINGS AND COATINGS	0	04/16/18	04/16/18	Bid Package 03

Number	Description	Revision	Issued Date	Received Date	Set
09 9600	RESINOUS FLOOR COATINGS	0	05/03/18	05/07/18	Bid Package 05
10 - Specialties					
10 2113	PLASTIC TOILET COMPARTMENTS	0	05/03/18	05/07/18	Bid Package 05
10 2113.13	Plastic Toilet Compartments	0			None
10 2226	OPERABLE PARTITIONS	2	05/08/18	05/08/18	Addendum 007
10 2601	WALL AND CORNER GUARDS	0	05/03/18	05/07/18	Bid Package 05
10 2615	HIGH IMPACT WALL COVERING	0	05/03/18	05/07/18	Bid Package 05
10 2800	TOILET ACCESSORIES	1	06/01/18	06/01/18	Addendum 011
10 4400	FIRE PROTECTION SPECIALTIES	0	05/03/18	05/07/18	Bid Package 05
10 5100	LOCKERS	0	05/03/18	05/07/18	Bid Package 05
10 7313	Awnings	0	06/01/18	06/01/18	Addendum 011
10 7500	FLAGPOLES	0	04/16/18	04/16/18	Bid Package 03
10 8200	ROOF TOP EQUIPMENT SCREENS	1	04/16/18	04/16/18	Bid Package 03
11 - Equipment					
11 1313	LOADING DOCK BUMPERS	0	04/16/18	04/16/18	Bid Package 03
11 1316	LOADING DOCK SEALS AND SHELTERS	0	04/16/18	04/16/18	Bid Package 03
11 1319.13	LOADING DOCK LEVELERS	0	04/16/18	04/16/18	Bid Package 03
11 4000	FOODSERVICE EQUIPMENT	1	07/20/18	07/20/18	Addendum 017
11 4000R1	Foodservice Equipment R1	0	06/01/18	06/01/18	Addendum 011
11 4000R2	Foodservice Equipment R2	0	06/15/18	06/15/18	Addendum 013
14 - Conveying Equipment					
14 4216	Vertical Lifts	0	06/15/18	06/15/18	Addendum 013
21 - Fire Suppression					
21 05 00	Common Work Results for Fire Suppression	0	05/23/18	05/23/18	Addendum 010
21 1316	Dry-Pipe Pre-Action Sprinkler Systems	0	06/08/18	06/08/18	Addendum 012
21 2200	Clean-Agent Fire-Extinguishing Systems	0	06/08/18	06/08/18	Addendum 012
22 - Plumbing					
22 0000	Plumbing	0			None
22 05 13	COMMON MOTOR REQUIREMENTS FOR PLUMBING EQUIPMENT	0	05/03/18	05/07/18	Bid Package 05
22 05 16	EXPANSION FITTINGS AND LOOPS FOR PLUMBING PIPING	0	05/03/18	05/07/18	Bid Package 05
22 05 17	SLEEVES AND SLEEVE SEALS FOR PLUMBING PIPING	0	05/03/18	05/07/18	Bid Package 05
22 05 18	ESCUTCHEONS FOR PLUMBING PIPING	0	05/03/18	05/07/18	Bid Package 05
22 05 19	METERS AND GAGES FOR PLUMBING PIPING	0	05/03/18	05/07/18	Bid Package 05
22 05 23	GENERAL-DUTY VALVES FOR PLUMBING PIPING	0	05/03/18	05/07/18	Bid Package 05
22 05 29	HANGERS AND SUPPORTS FOR PLUMBING PIPING AND EQUIPMENT	0	05/03/18	05/07/18	Bid Package 05
22 05 48	VIBRATION AND SEISMIC CONTROLS FOR PLUMBING PIPING AND EQUIPMENT	0	05/03/18	05/07/18	Bid Package 05
22 05 53	IDENTIFICATION FOR PLUMBING PIPING AND EQUIPMENT	0	05/03/18	05/07/18	Bid Package 05
22 07 16	PLUMBING EQUIPMENT INSULATION	0	05/03/18	05/07/18	Bid Package 05

Number	Description	Revision	Issued Date	Received Date	Set
22 07 19	PLUMBING PIPING INSULATION	0	05/03/18	05/07/18	Bid Package 05
22 08 00	COMMISSIONING OF PLUMBING SYSTEMS	0	05/03/18	05/07/18	Bid Package 05
22 11 16	DOMESTIC WATER PIPING	0	05/03/18	05/07/18	Bid Package 05
22 11 19	DOMESTIC WATER PIPING SPECIALITIES	0	05/03/18	05/07/18	Bid Package 05
22 11 23	DOMESTIC WATER PUMPS	0	05/03/18	05/07/18	Bid Package 05
22 13 19	SANITARY WASTE PIPING SPECIALITIES	0	05/03/18	05/07/18	Bid Package 05
22 14 13	Facility Storm Drainage Piping	0	05/23/18	05/23/18	Addendum 010
22 42 13.13	Commercial Water Closets	0	05/03/18	05/07/18	Bid Package 05
22 42 13.16	COMMERCIAL URINALS	0	05/03/18	05/07/18	Bid Package 05
22 42 16.13	Commercial Lavatories	0	05/03/18	05/07/18	Bid Package 05
22 42 16.16	COMMERCIAL SINKS	0	05/03/18	05/07/18	Bid Package 05
22 47 16	PRESSURE WATER COOLERS	0	05/03/18	05/07/18	Bid Package 05
22 1113	PRIVATE WATER DISTRIBUTION	0	03/27/18	03/27/18	Bid Package 02
22 1313	PRIVATE SANITARY SEWERAGE	0	03/27/18	03/27/18	Bid Package 02
22 1316	SANITARY WASTE AND VENT PIPING	1	05/03/18	05/07/18	Bid Package 05
23 - Heating, Ventilating, and Air Conditioning (HVAC)					
23 00 01	HVAC GENERAL REQUIREMENTS	0	05/03/18	05/07/18	Bid Package 05
23 00 02	BASIC HVAC MATERIALS AND METHODS	0	05/03/18	05/07/18	Bid Package 05
23 05 16	PIPE EXPANSION FITTINGS AND LOOPS	0	05/03/18	05/07/18	Bid Package 05
23 05 18	ESCUTCHEONS FOR HVAC PIPING	0	05/03/18	05/07/18	Bid Package 05
23 05 19	HVAC METERS AND GAGES	0	05/03/18	05/07/18	Bid Package 05
23 05 23	VALVES	0	05/03/18	05/07/18	Bid Package 05
23 05 29	HANGERS AND SUPPORTS	0	05/03/18	05/07/18	Bid Package 05
23 05 48	HVAC VIBRATION CONTROLS	0	05/03/18	05/07/18	Bid Package 05
23 05 53	MECHANICAL IDENTIFICATION	0	05/03/18	05/07/18	Bid Package 05
23 05 93	TESTING ADJUSTING AND BALANCING	0	05/03/18	05/07/18	Bid Package 05
23 07 13	DUCT INSULATION	0	05/03/18	05/07/18	Bid Package 05
23 07 17	EQUIPMENT INSULATION	0	05/03/18	05/07/18	Bid Package 05
23 07 19	HVAC PIPE INSULATION	0	05/03/18	05/07/18	Bid Package 05
23 08 00	COMMISSIONING OF HVAC SYSTEMS	0	05/03/18	05/07/18	Bid Package 05
23 09 00	AUTOMATIC TEMPERATURE CONTROL SYSTEMS	1	06/01/18	06/01/18	Addendum 011
23 09 93	SEQUENCE OF OPERATIONS	0	05/03/18	05/07/18	Bid Package 05
23 21 13	HYDRONIC PIPING	0	05/03/18	05/07/18	Bid Package 05
23 21 23	HYDRONIC PUMPS	0	05/03/18	05/07/18	Bid Package 05
23 23 00	REFRIGERANT PIPING	0	05/03/18	05/07/18	Bid Package 05
23 25 00	HVAC WATER TREATMENT	0	05/03/18	05/07/18	Bid Package 05
23 31 13	HVAC DUCTS	0	05/03/18	05/07/18	Bid Package 05
23 33 00	DUCT ACCESSORIES	0	05/03/18	05/07/18	Bid Package 05

Number	Description	Revision	Issued Date	Received Date	Set
23 34 23	HVAC POWER VENTILATORS	0	05/03/18	05/07/18	Bid Package 05
23 36 00	AIR TERMINAL UNITS	0	05/03/18	05/07/18	Bid Package 05
23 37 13	DIFFUSERS REGISTERS AND GRILLES	0	05/03/18	05/07/18	Bid Package 05
23 51 00	BREECHINGS CHIMNEYS AND STACKS	0	05/03/18	05/07/18	Bid Package 05
23 52 16	CONDENSING BROILERS	0	05/03/18	05/07/18	Bid Package 05
23 64 18.1	MODULAR CENTRAL PLANT	0	05/03/18	05/07/18	Bid Package 05
23 65 00	CLOSED CIRCUIT COOLERS	1	05/03/18	05/07/18	Bid Package 05
23 73 13	AIR HANDLING UNIT	1	05/03/18	05/07/18	Bid Package 05
23 73 13.1	AIR HANDLING UNIT / DEDICATED OUTDOOR AIR SYSTEM / ENERGY RECOVERY UNIT	1	05/03/18	05/07/18	Bid Package 05
23 82 19	FAN-COIL UNITS	0	05/03/18	05/07/18	Bid Package 05
23 82 39	UNIT HEATERS	0	05/03/18	05/07/18	Bid Package 05
23 1123	Facility Natural-Gas Piping	0	04/16/18	04/16/18	Addendum 003
26 - Electrical					
26 05 72	OVERCURRENT PROTECTIVE DEVICE SHORT-CIRCUIT STUDY	0	05/03/18	05/07/18	Bid Package 05
26 05 73	OVERCURRENT PROTECTIVE DEVICE COORDINATION STUDY	0	05/03/18	05/07/18	Bid Package 05
26 05 74	OVERCURRENT PROTECTIVE DEVICE ARC-FLASH STUDY	0	05/03/18	05/07/18	Bid Package 05
26 22 00	LOW-VOLTAGE TRANSFORMERS	0	05/03/18	05/07/18	Bid Package 05
26 24 16	PANELBOARDS	0	05/03/18	05/07/18	Bid Package 05
26 27 26	WIRING DEVICES	0	05/03/18	05/07/18	Bid Package 05
26 28 13	FUSES	0	05/03/18	05/07/18	Bid Package 05
26 28 16	ENCLOSED SWITCHES AND CIRCUIT BREAKERS	0	05/03/18	05/07/18	Bid Package 05
26 29 13.03	MANUAL AND MAGNETIC MOTOR CONTROLLERS	0	05/03/18	05/07/18	Bid Package 05
26 33 53	STATIC UNINTERRUPTIBLE POWER SUPPLY	0	05/03/18	05/07/18	Bid Package 05
26 36 00	TRANSFER SWITCHES	0	05/03/18	05/07/18	Bid Package 05
26 51 19	LED INTERIOR LIGHTING	0	05/03/18	05/07/18	Bid Package 05
26 52 19	EMERGENCY AND EXIT LIGHTING	0	05/03/18	05/07/18	Bid Package 05
26 56 13	LIGHT POLES AND STANDARDS	0	05/03/18	05/07/18	Bid Package 05
26 56 19	LED EXTERIOR LIGHTING	0	05/03/18	05/07/18	Bid Package 05
26 0519	LOW-VOLTAGE ELECTRICAL POWER CONDUCTORS AND CABLES	2	06/08/18	06/08/18	Addendum 012
26 0526	GROUNDING AND BONDING FOR ELECTRICAL SYSTEMS	2	06/08/18	06/08/18	Addendum 012
26 0529	HANGERS AND SUPPORTS FOR ELECTRICAL SYSTEMS	1	05/03/18	05/07/18	Bid Package 05
26 0533	RACEWAYS AND BOXES FOR ELECTRICAL SYSTEMS	2	06/08/18	06/08/18	Addendum 012
26 0543	UNDERGROUND DUCTS AND RACEWAYS FOR ELECTRICAL SYSTEMS	2	06/08/18	06/08/18	Addendum 012
26 0544	SLEEVES AND SLEEVE SEALS FOR ELECTRICAL RACEWAYS AND CABLING	1	05/03/18	05/07/18	Bid Package 05
26 0553	IDENTIFICATION FOR ELECTRICAL SYSTEMS	0	05/03/18	05/07/18	Bid Package 05
26 2413	Switchboards	1	05/03/18	05/07/18	Bid Package 05
26 3213.13	Deisel Emergency Engine Generators	1	05/03/18	05/07/18	Bid Package 05
26 4113	LIGHTING PROTECTION FOR STRUCTURES	1	05/03/18	05/07/18	Bid Package 05

Number	Description	Revision	Issued Date	Received Date	Set
28 - Electronic Safety and Security					
28 3111	DIGITAL ADDRESSABLE FIRE ALARM AND EMERGENCY COMMUNICATIONS SYSTEM	0	05/03/18	05/07/18	Bid Package 05
31 - Earthwork					
31 2000	EARTHWORK	0	03/06/18	03/06/18	Bid Package 01
31 2319	DEWATERING	0	03/06/18	03/06/18	Bid Package 01
31 2500	EROSION AND SEDIMENTATION CONTROL	0	03/06/18	03/06/18	Bid Package 01
31 3116	TERMITE CONTROL	0	03/27/18	03/27/18	Bid Package 02
31 5000	EXCAVATION SUPPORT AND PROTECTION	0	03/06/18	03/06/18	Bid Package 01
31 6329	DRILLED CONCRETE PIERS AND SHAFTS	0	03/06/18	03/06/18	Bid Package 01
32 - Exterior Improvements					
32 1216	ASPHALT PAVING	0	04/20/18	04/20/18	Bid Package 04
32 1313	CONCRETE PAVING	0	04/20/18	04/20/18	Bid Package 04
32 1373	CONCRETE PAVING JOINT SEALANTS	0	04/20/18	04/20/18	Bid Package 04
32 1723	PAVEMENT MARKINGS	0	04/20/18	04/20/18	Bid Package 04
32 3113	CHAIN-LINK FENCES AND GATES	0	04/20/18	04/20/18	Bid Package 04
32 8000	IRRIGATION SYSTEMS	0	05/04/18	05/04/18	Addendum 006
32 9000	PLANTING	0	05/04/18	05/04/18	Addendum 006
32 9200	LAWNS AND GRASSES	1	05/04/18	05/04/18	Addendum 006
33 - Utilities					
33 4100	Private Storm Sewer	1	04/16/18	04/16/18	Addendum 003

CHEROKEE NATION ENTERTAINMENT
TAHLEQUAH CASINO
 TAHLEQUAH, OKLAHOMA
 INTERIOR THEMING



James R. Childers
 Architect, Inc.
 45 South 4th Street
 Fort Smith, AR 72901
 479-785-2480
 www.childersarchitect.com

PROFESSIONAL SEAL:

CONSULTANT LOGO:



CHEROKEE NATION ENTERTAINMENT
TAHLEQUAH CASINO
 TAHLEQUAH, OKLAHOMA

PROJECT PHASE:


INTERIOR THEMING

REVISIONS		
#	DATE	DESCRIPTION

DATE: 06/01/18 JOB NUMBER: 17-06

SHEET NUMBER: --

COVER

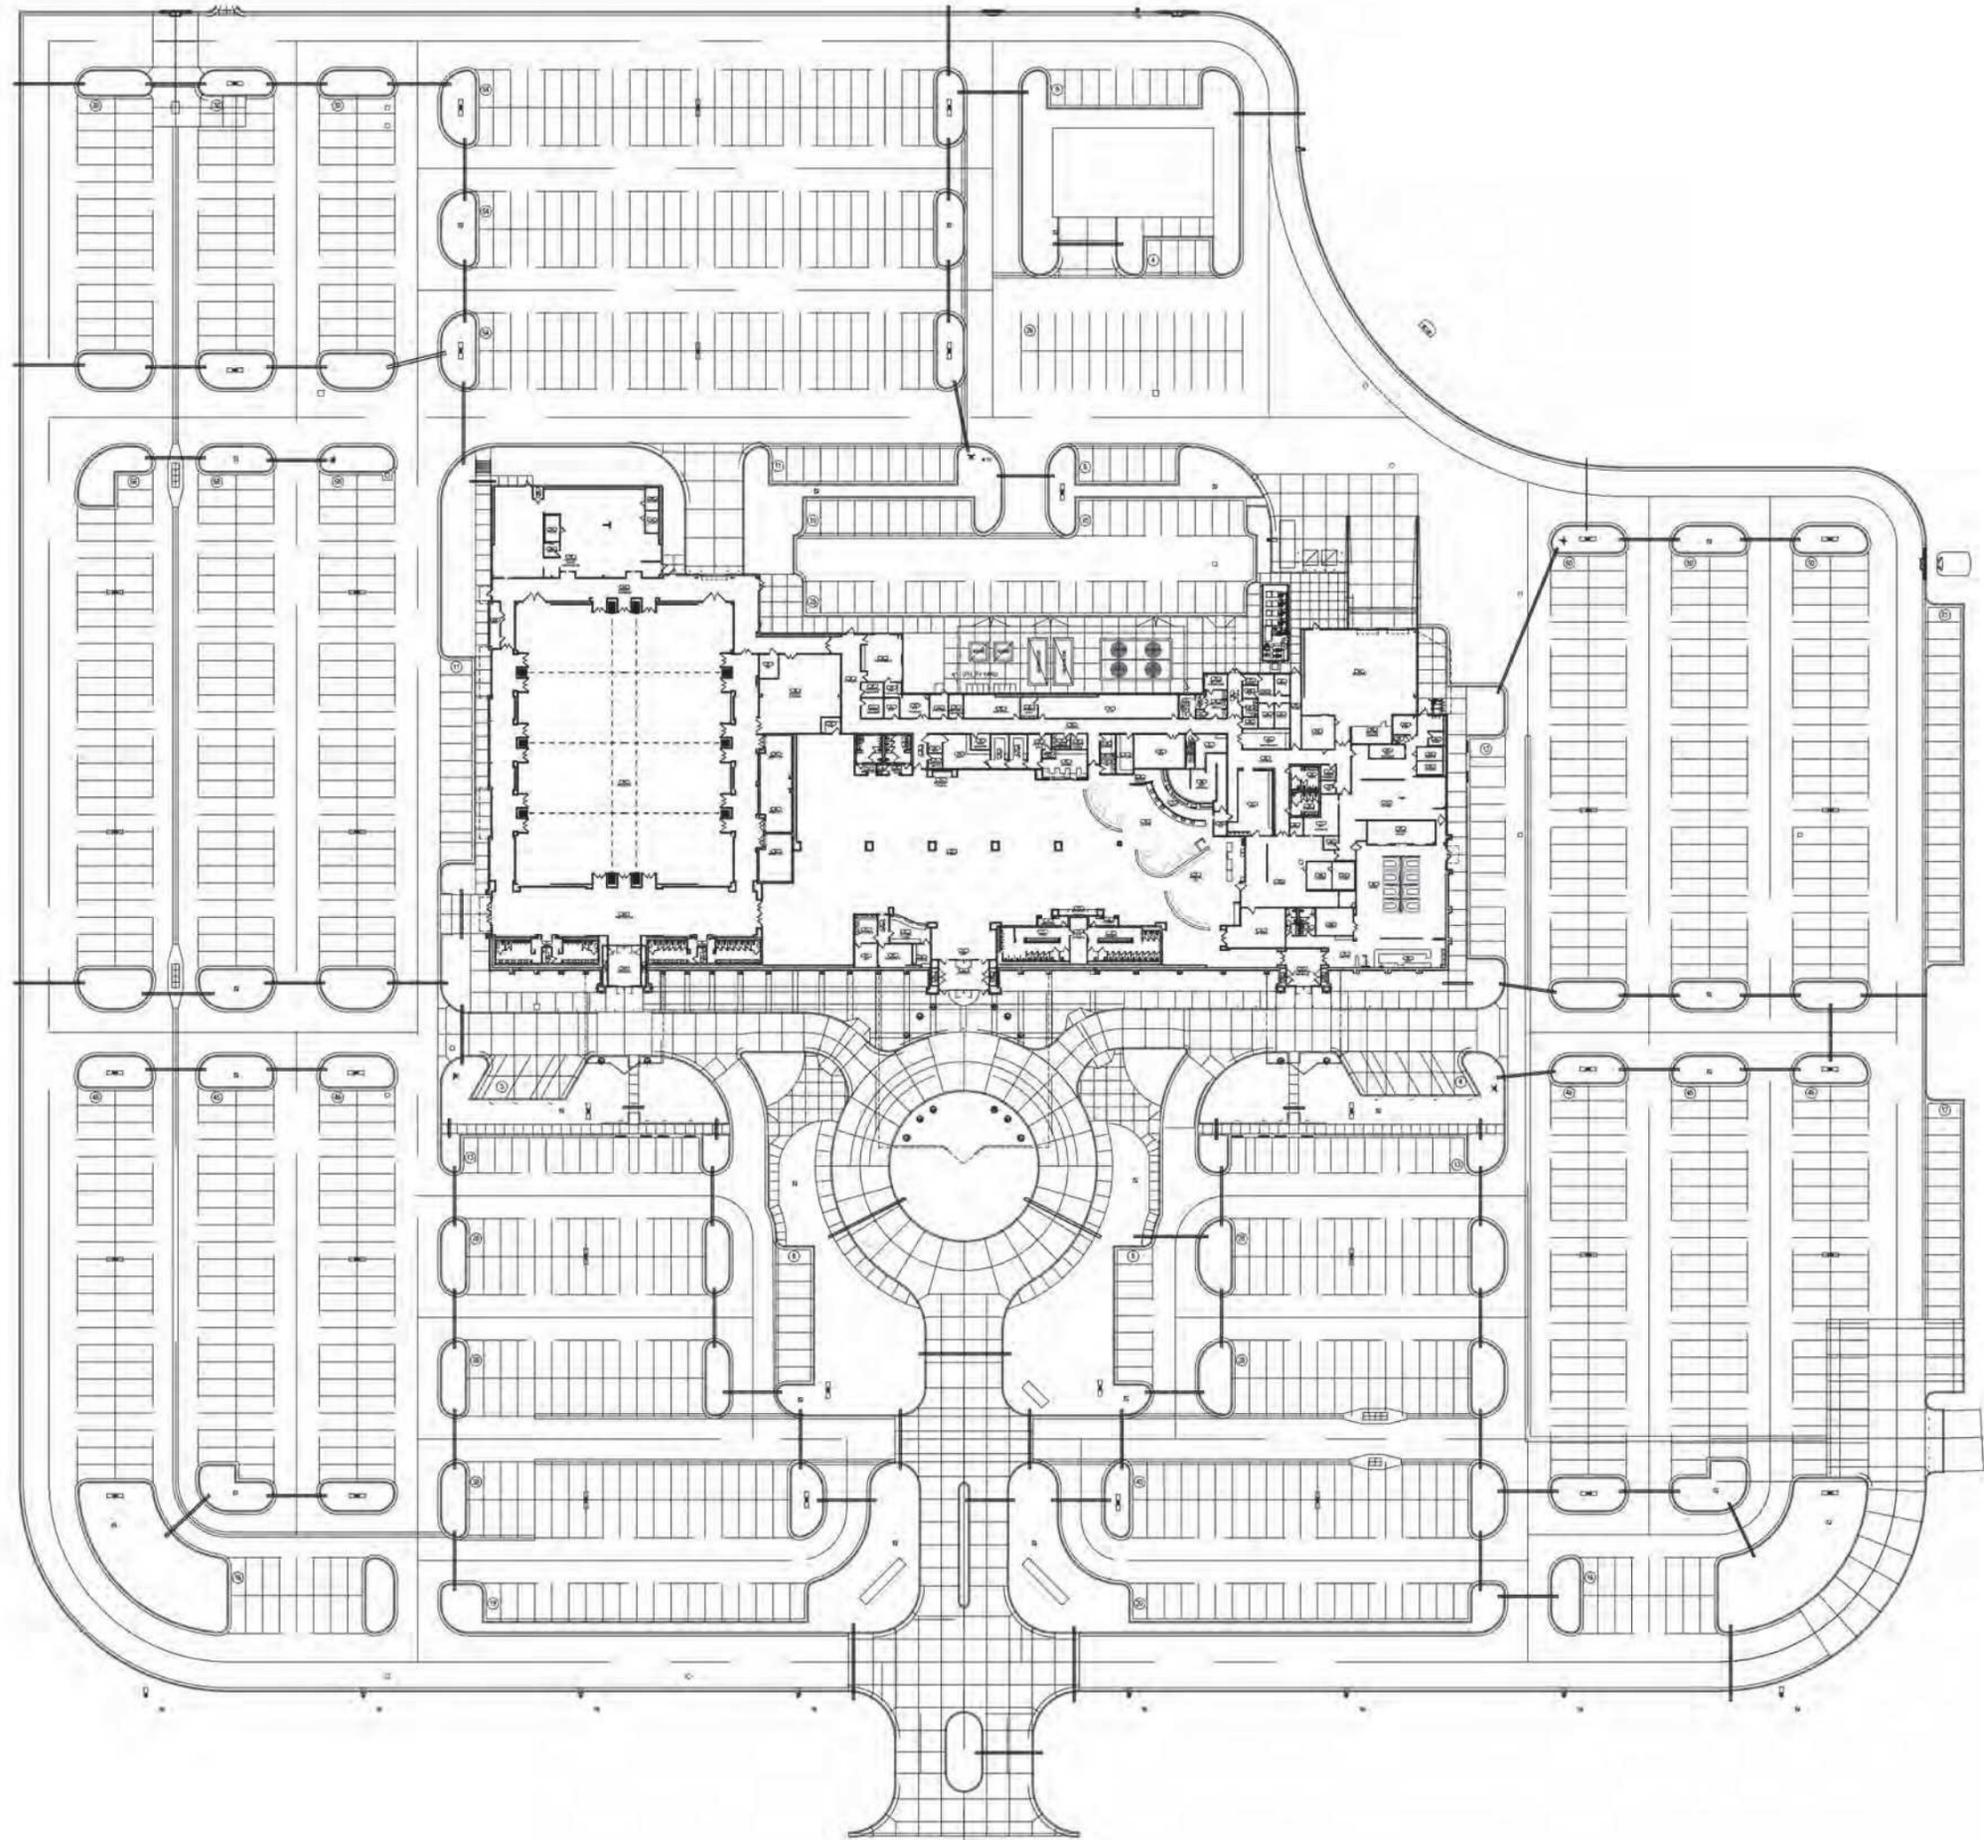

Ꭰ

D.

Ꭱ

R.

Ꭲ

T.

Ꭳ

Ꭴ.

Ꭵ

O.

Ꭶ

i.

Ꭷ

S. Ꭸ.

Ꭹ

Ꭺ.

Ꭼ

Ꭽ.

Ꭾ

A.

Ꭿ

J.


Ꮀ

E.

Ꮁ

Ꮂ.



PATTERNS

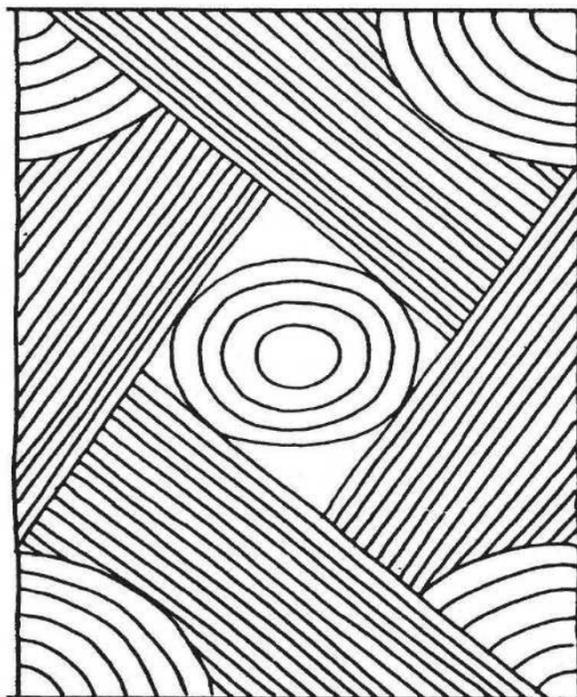


WEAVING



POTTERY

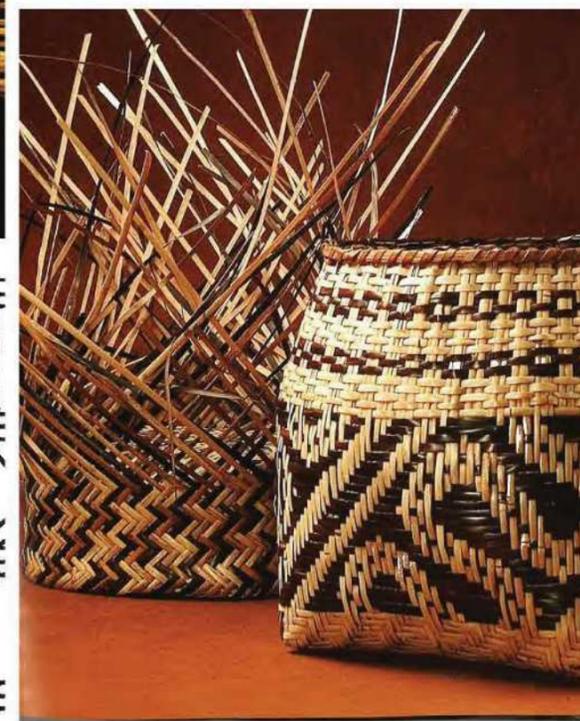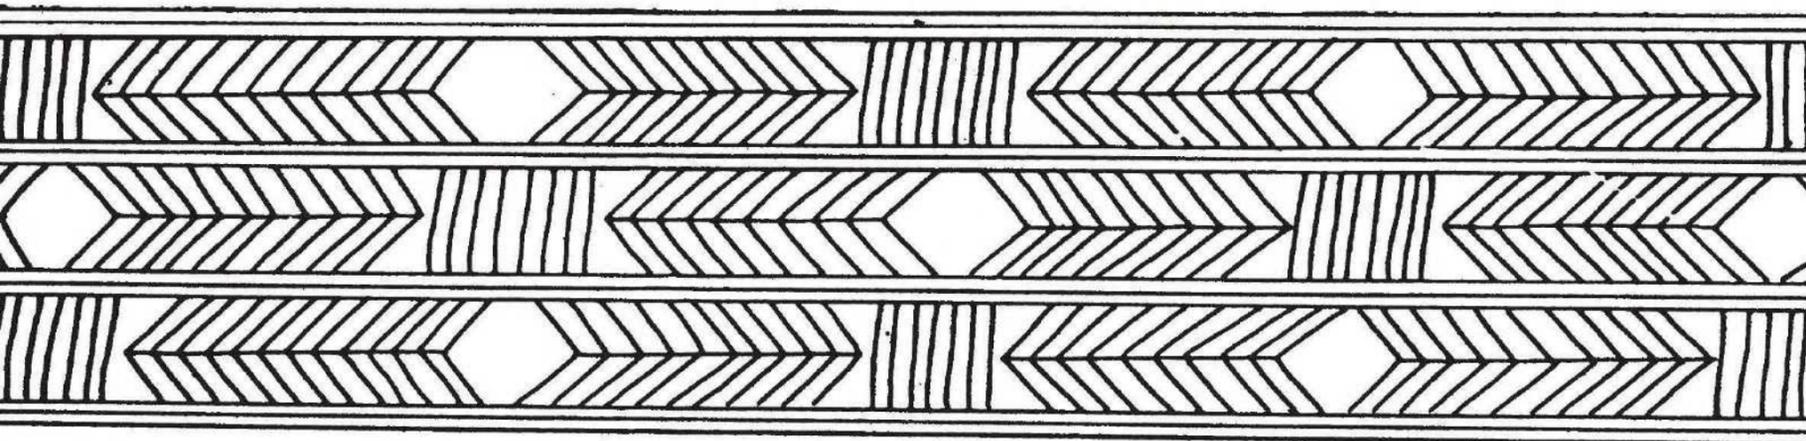

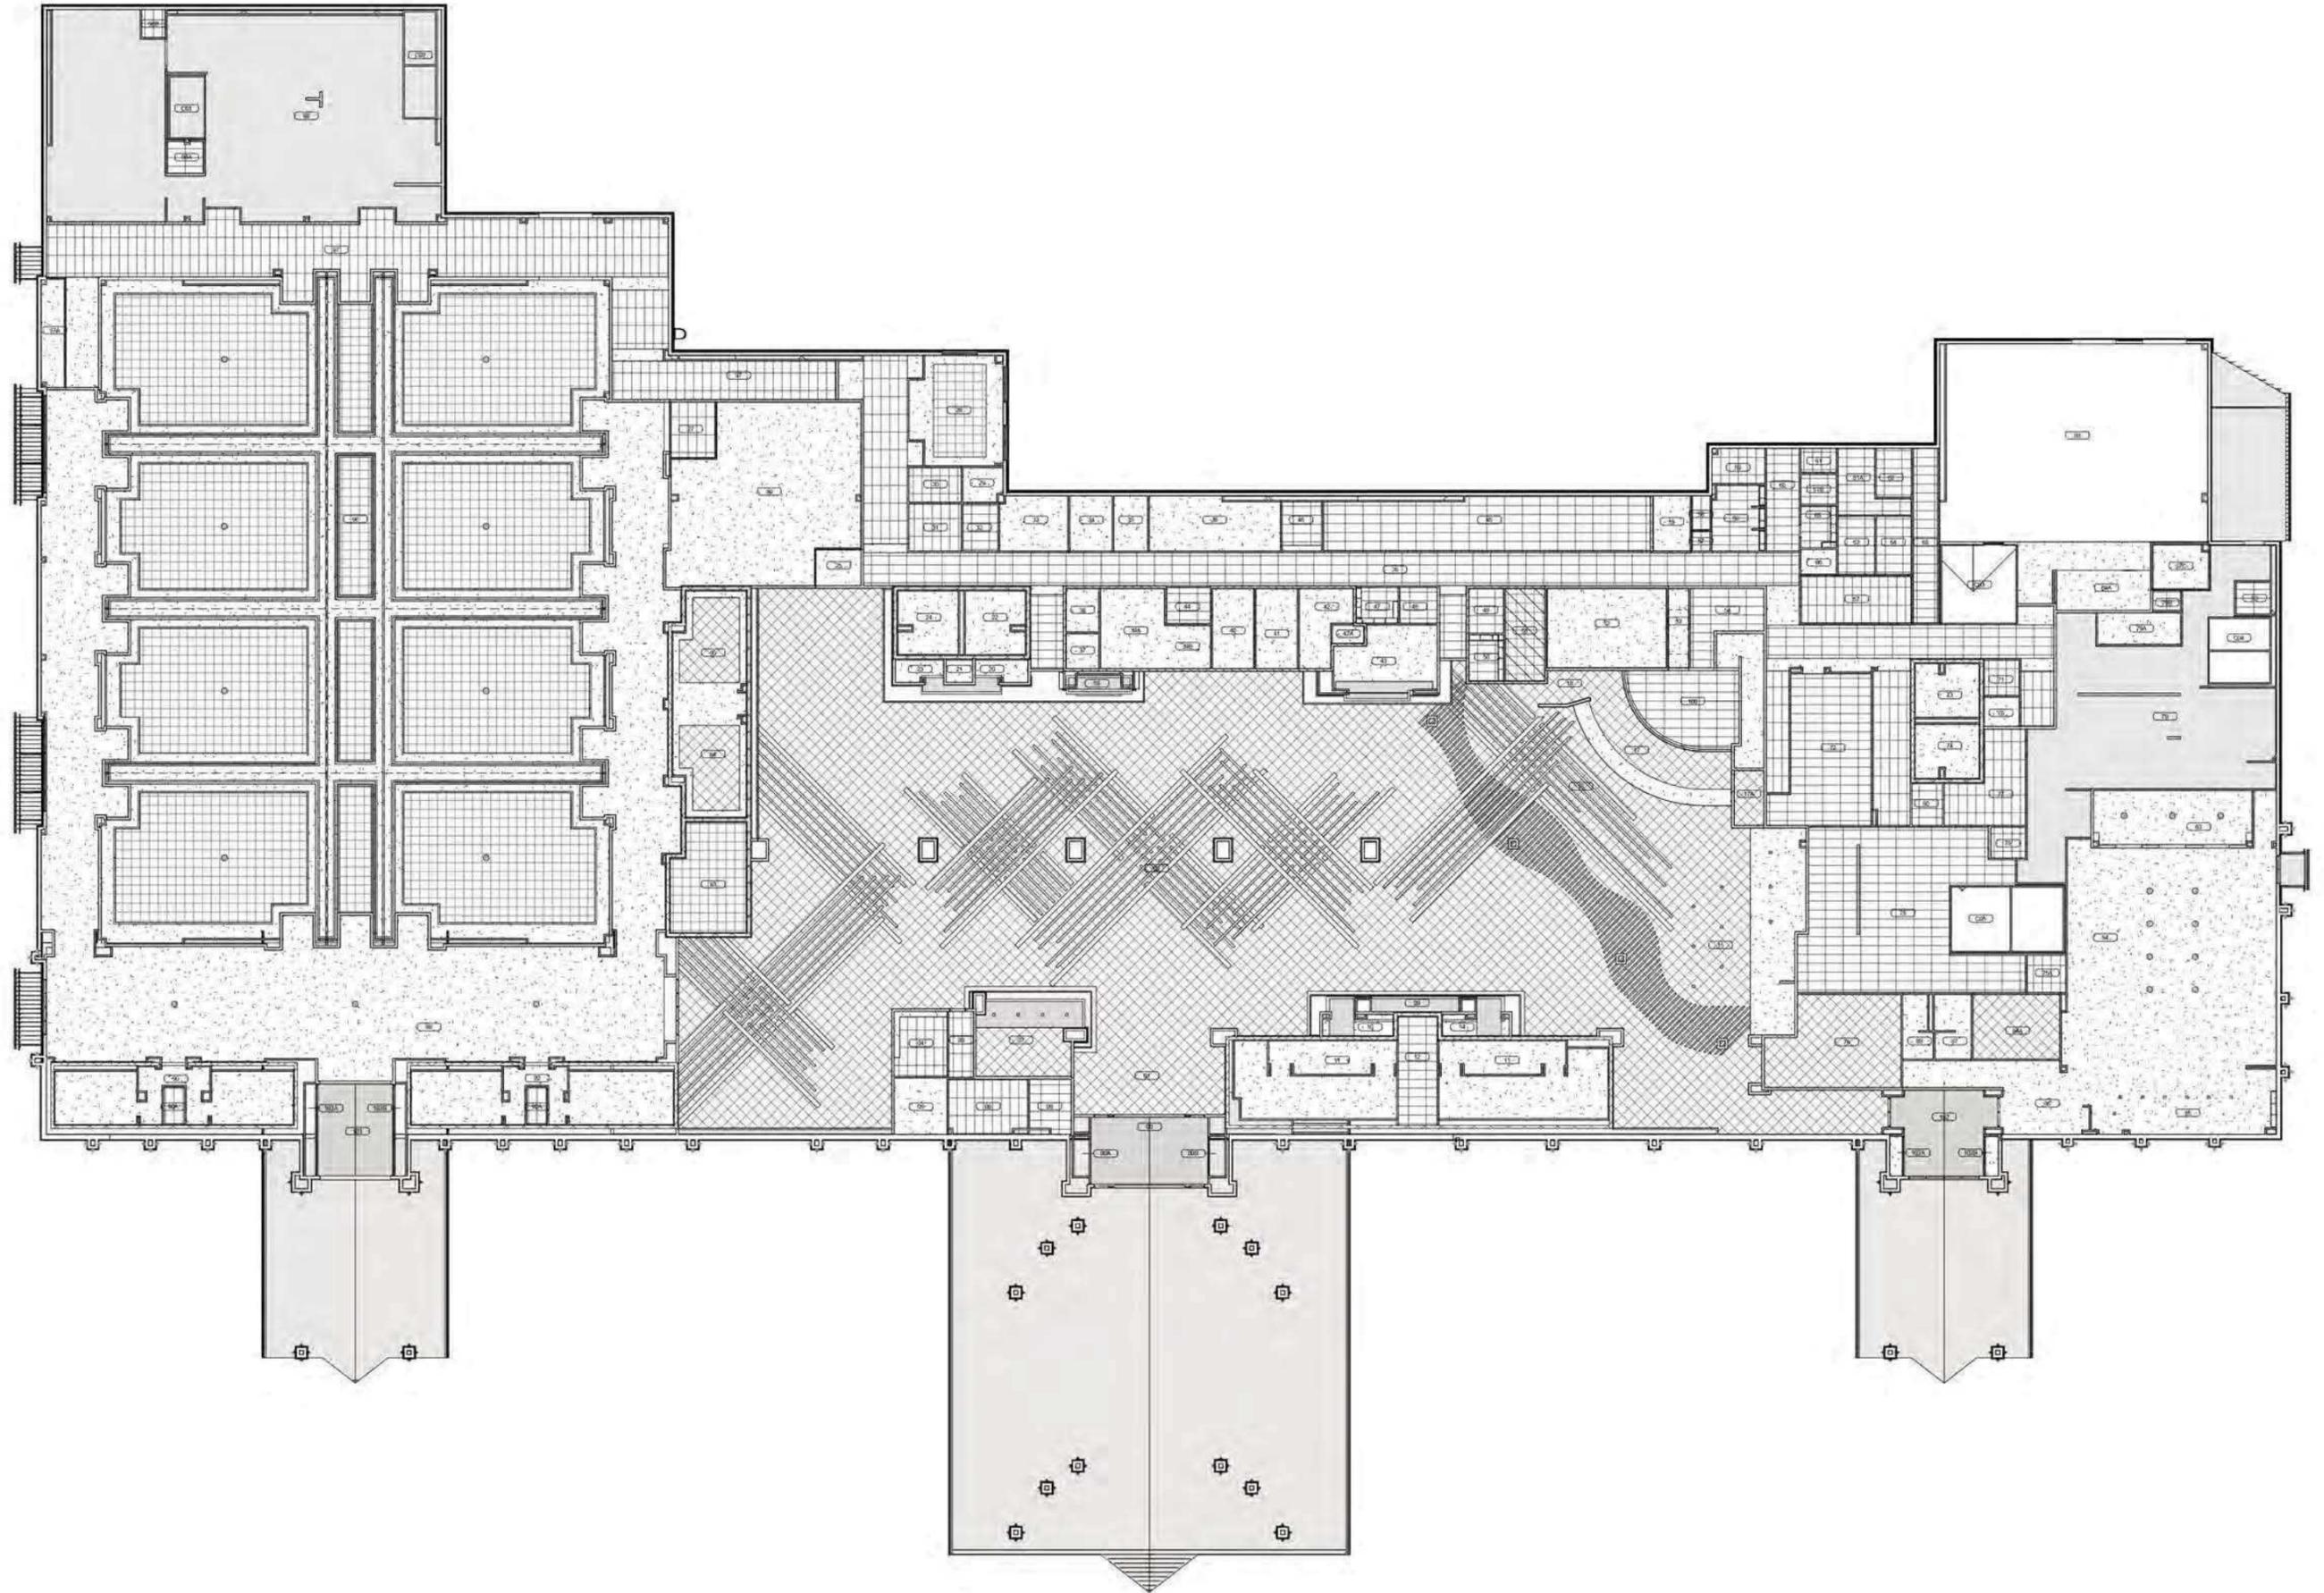





BEVERAGE

W

